



CURVE	RADIUS	LENGTH	TANGENT	CHORD	BEARING	DELTA
C1	100.00'	110.86'	61.90'	105.27'	N75°30'50" E	63°31'04"
C2	100.00'	41.40'	21.00'	41.11'	N84°35'20" W	23°43'24"

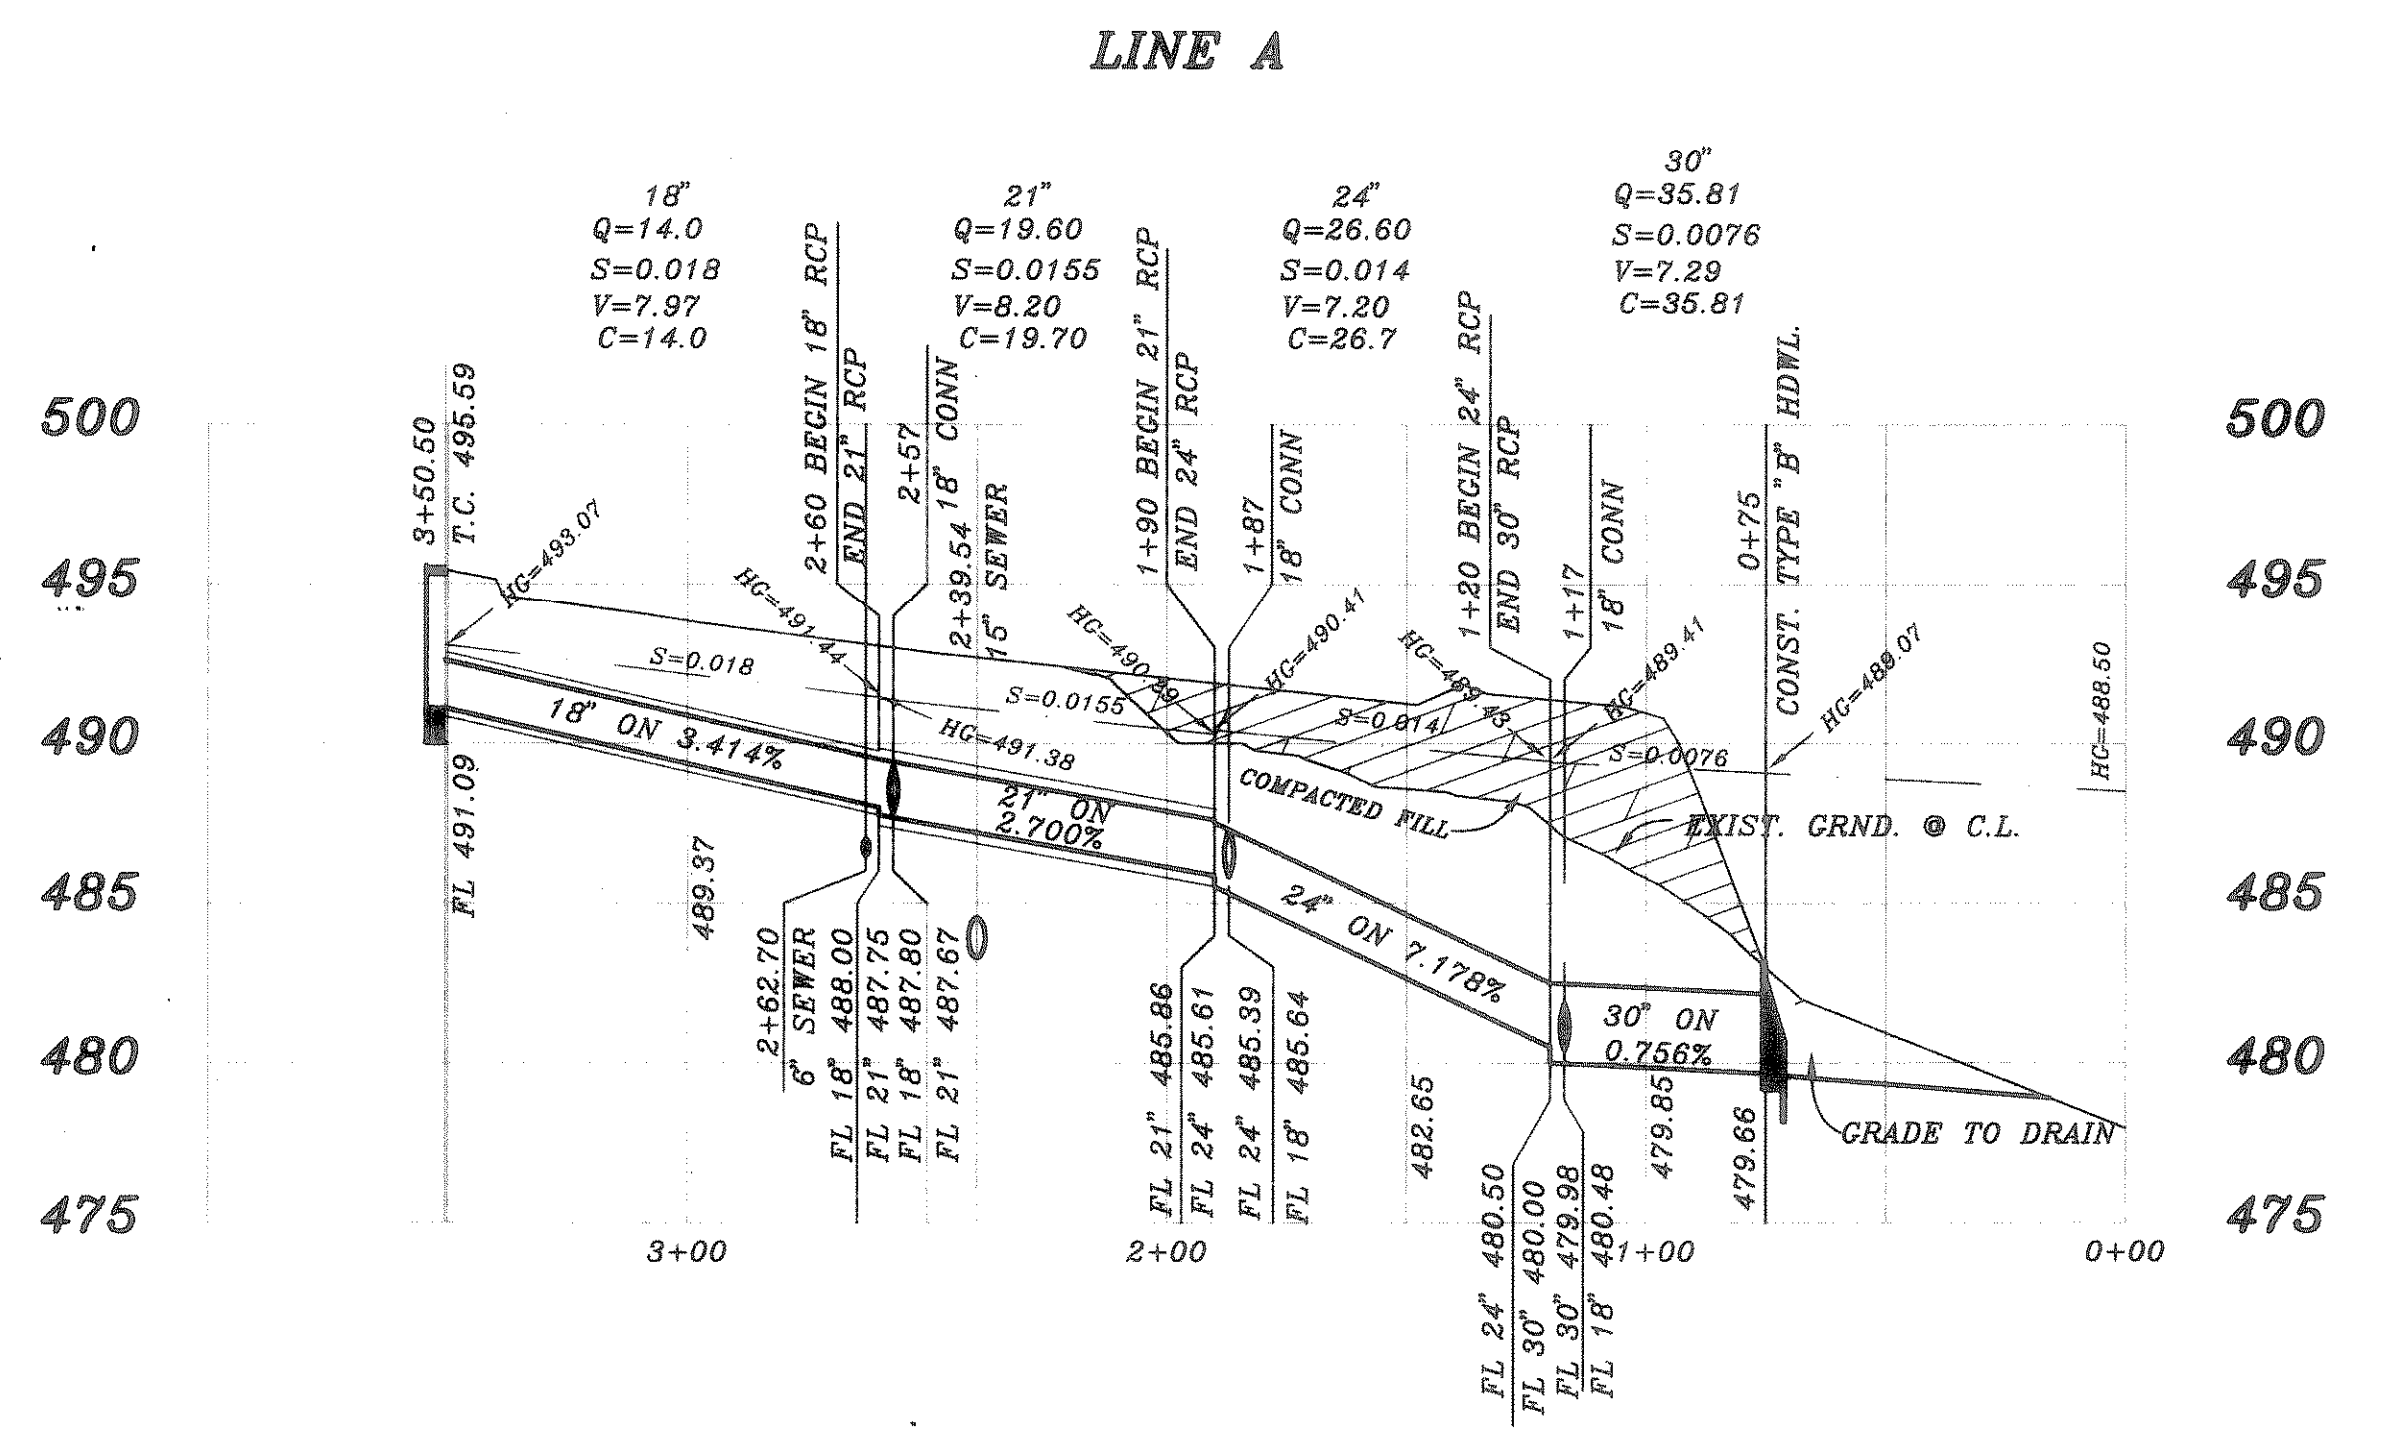

B.M.
 SQUARE ON N. END OF HDWL ON EAST
 SIDE OF ST. HWY. NO. 205, 170' +/-
 SOUTH OF CENTERLINE OF CARUTH LANE.
 ELEVATION = 482.40

B.M.
 NORTHEAST TOP OF CURB AT NORTH END
 OF FANNIN STREET, 125' +/- EAST OF
 SOUTHEAST ADDITION CORNER.
 ELEVATION = 518.18

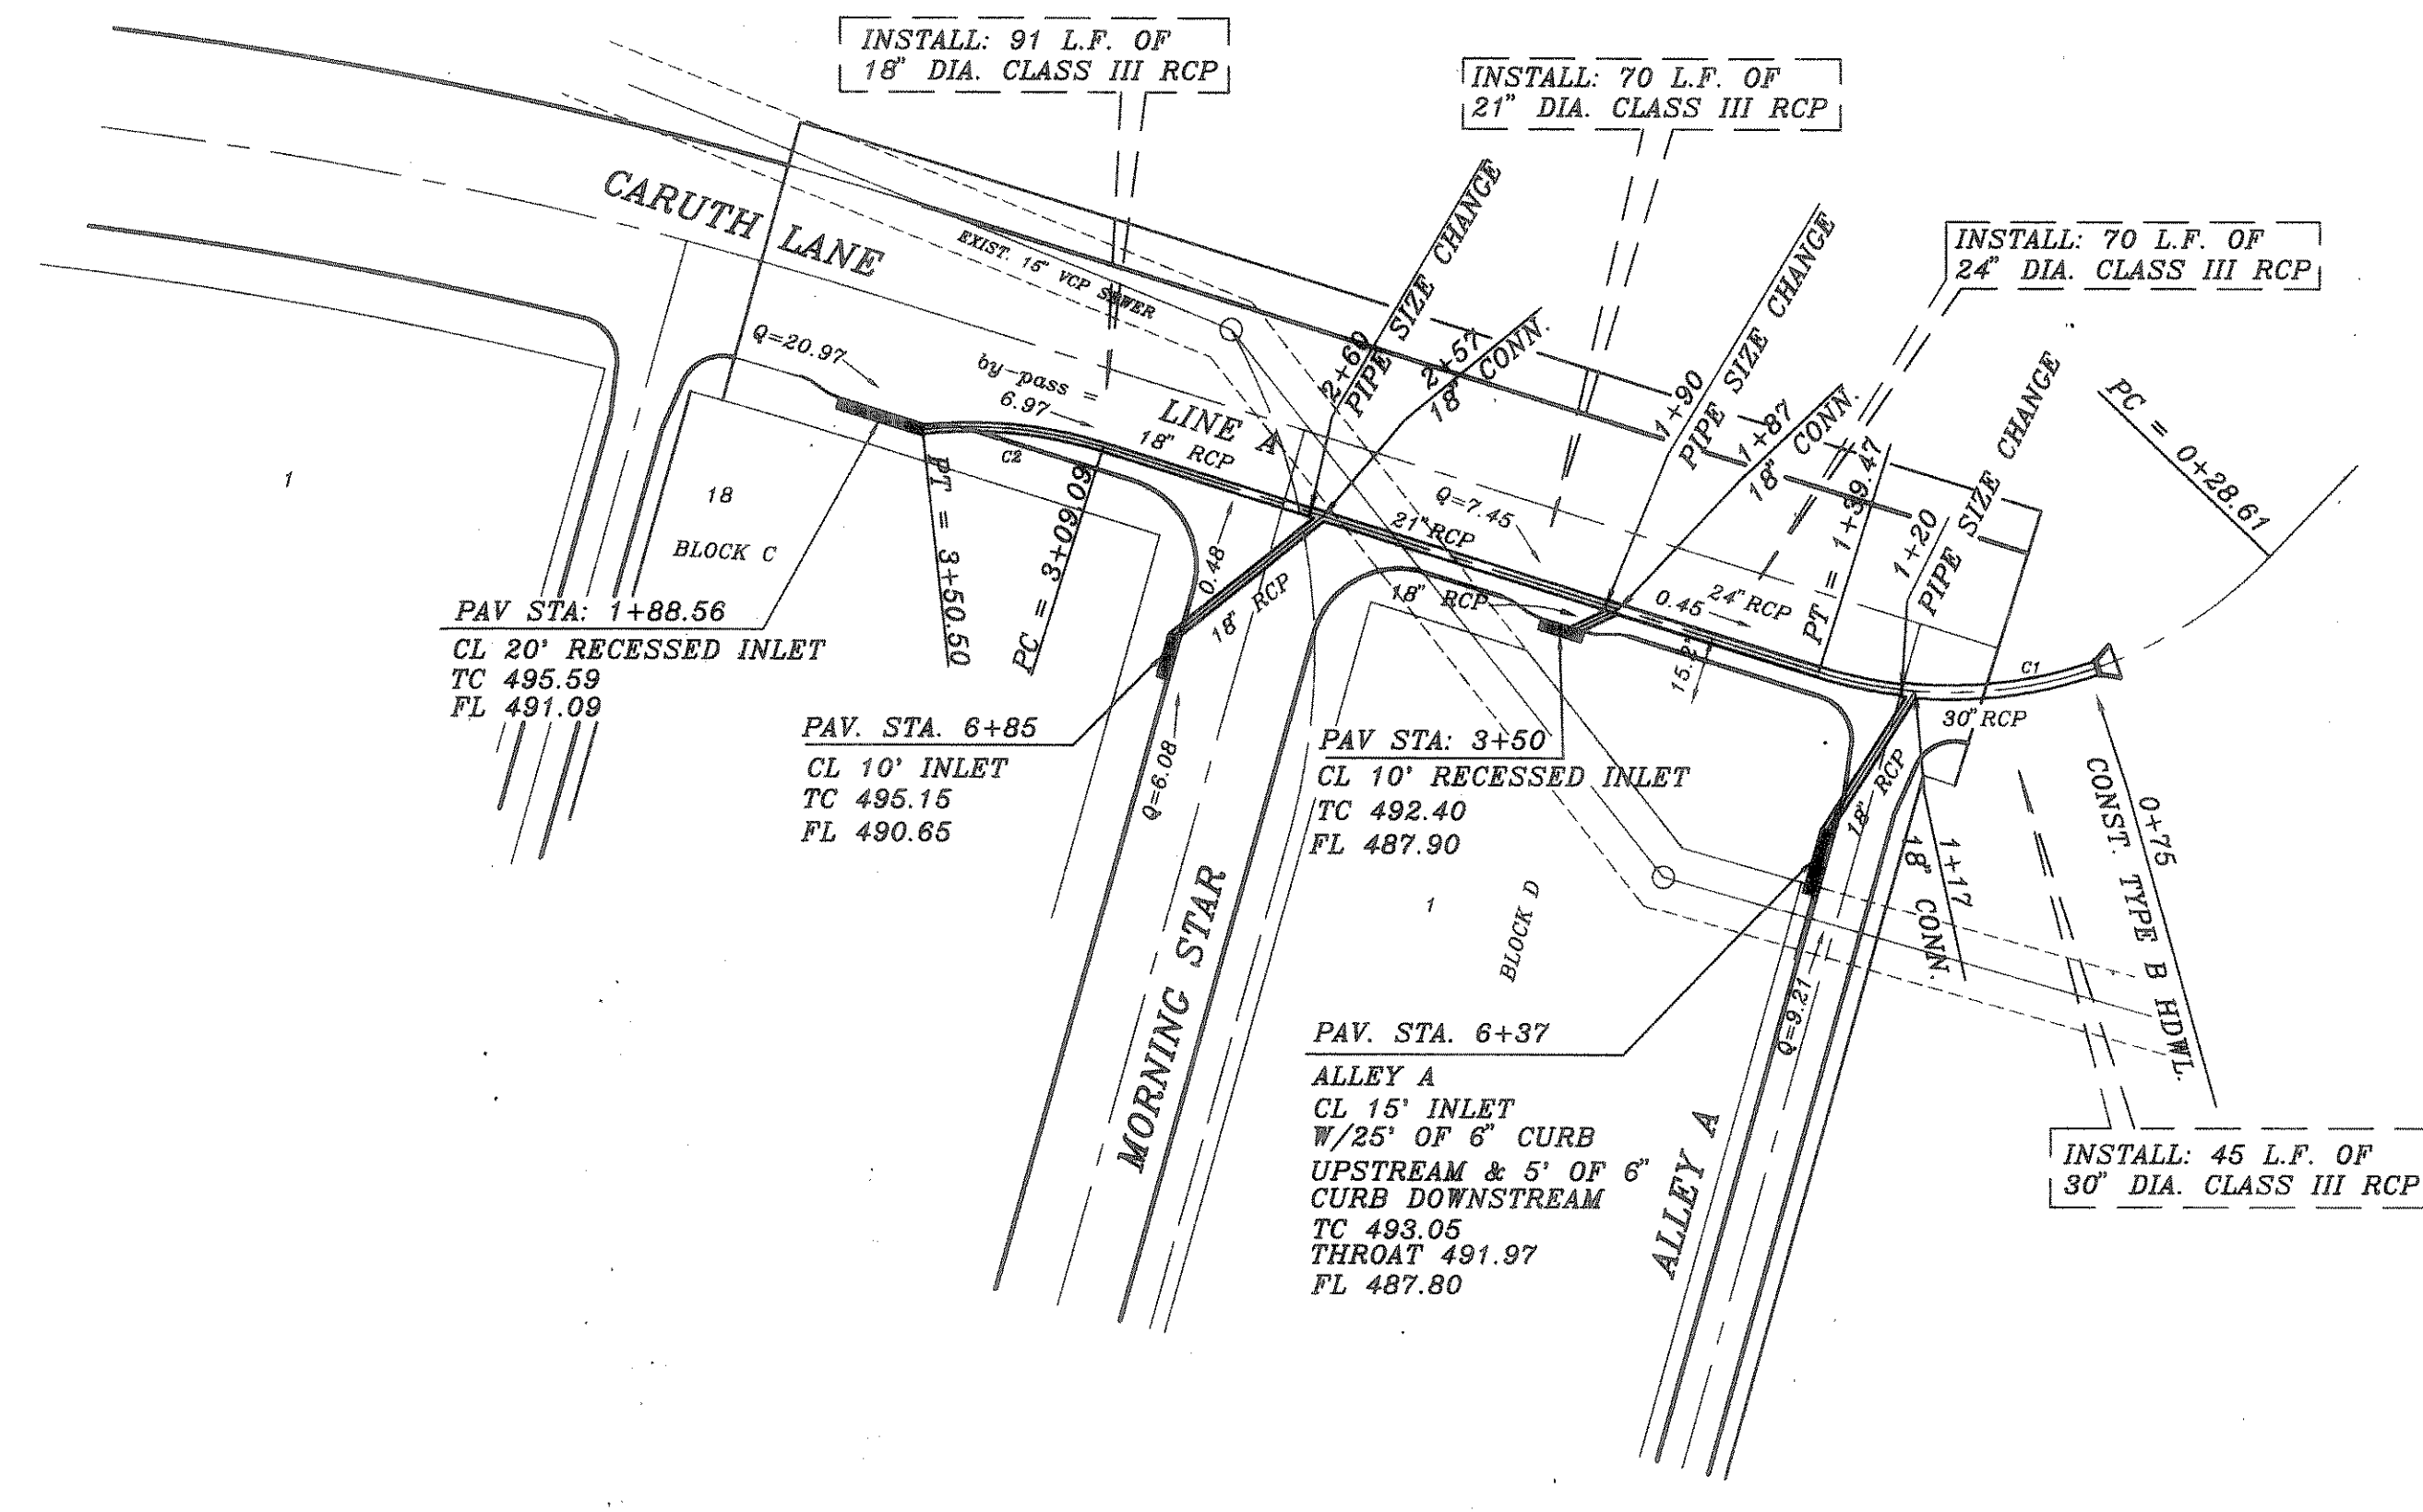

AS-BUILT

REVISION DESCRIPTION	DATE	SCALE	DESIGN	DRAWN	SHEET NO. 7 9
	5/14/95	1" = 40' 1" = 6'	H.L.E.		
HAROLD L. EVANS CONSULTING ENGINEER P.O. BOX 28855 2331 GUS THOMASSON ROAD, SUITE 102 DALLAS, TEXAS 75228, (214) 328-8133					PROPOSED STORM SEWER LINE A CARUTH LAKE NO. 3 CITY OF ROCKWALL