

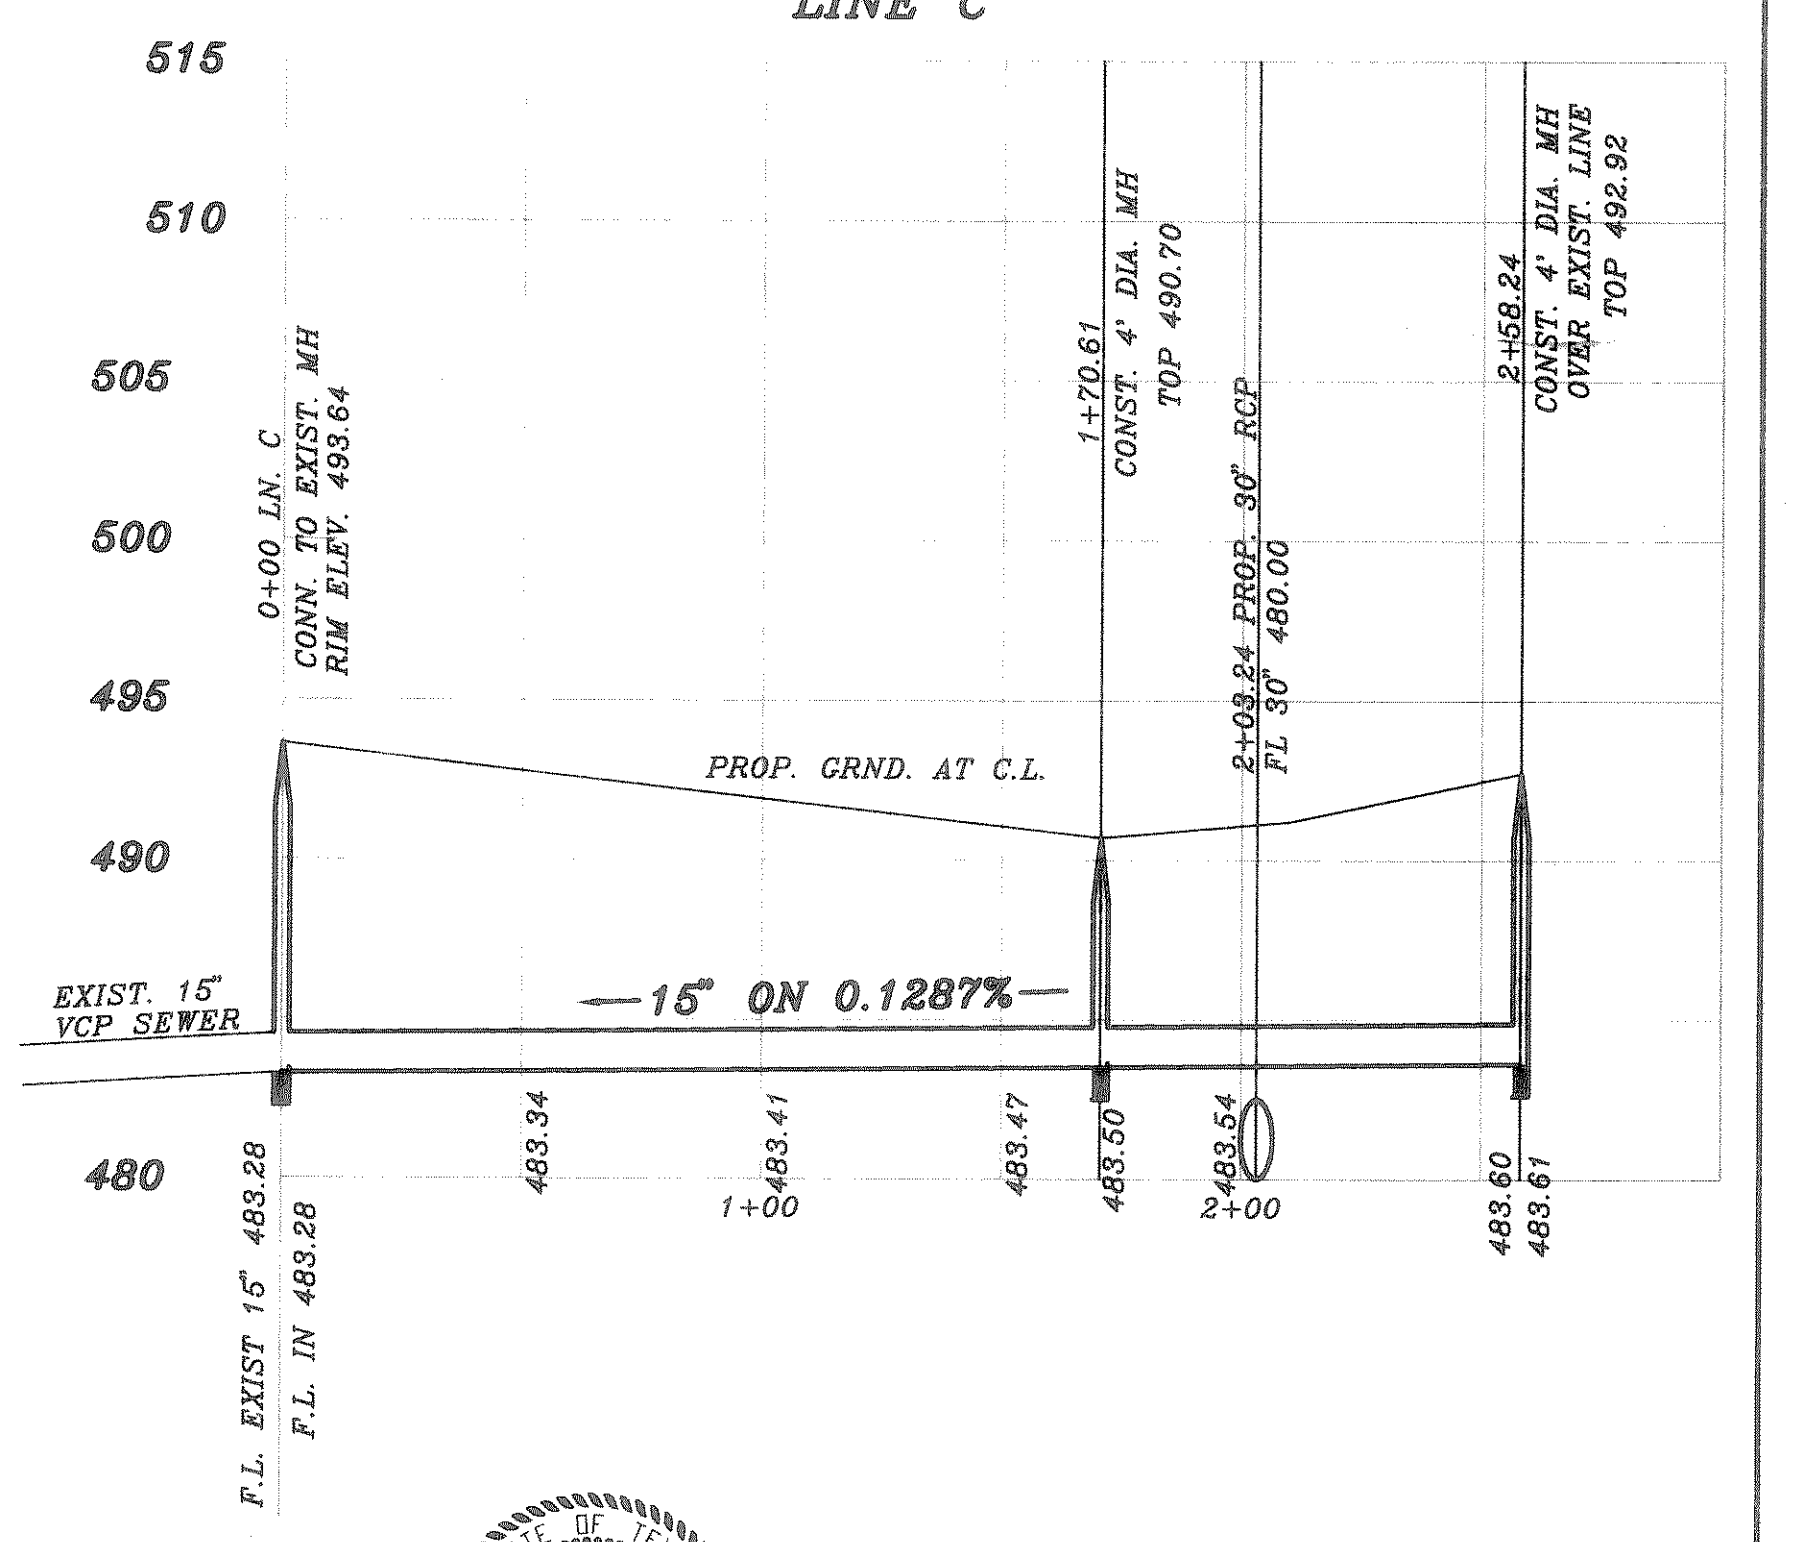
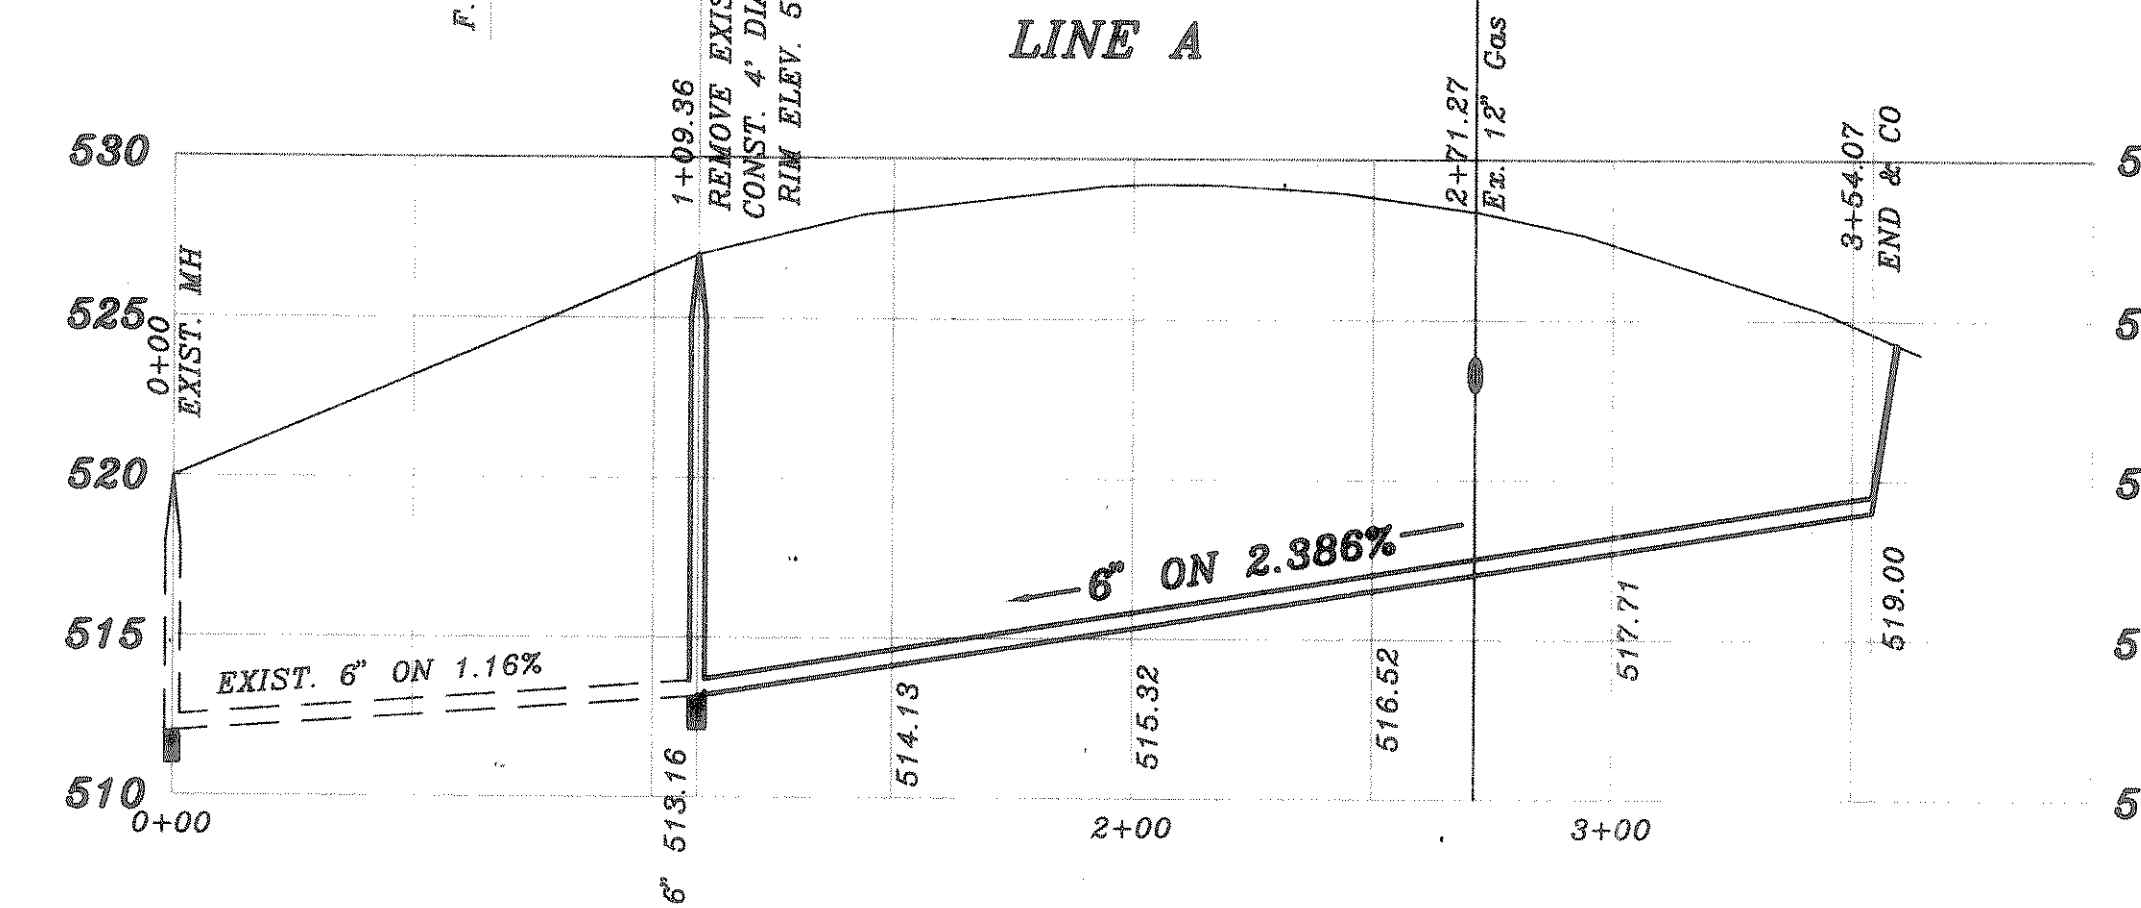
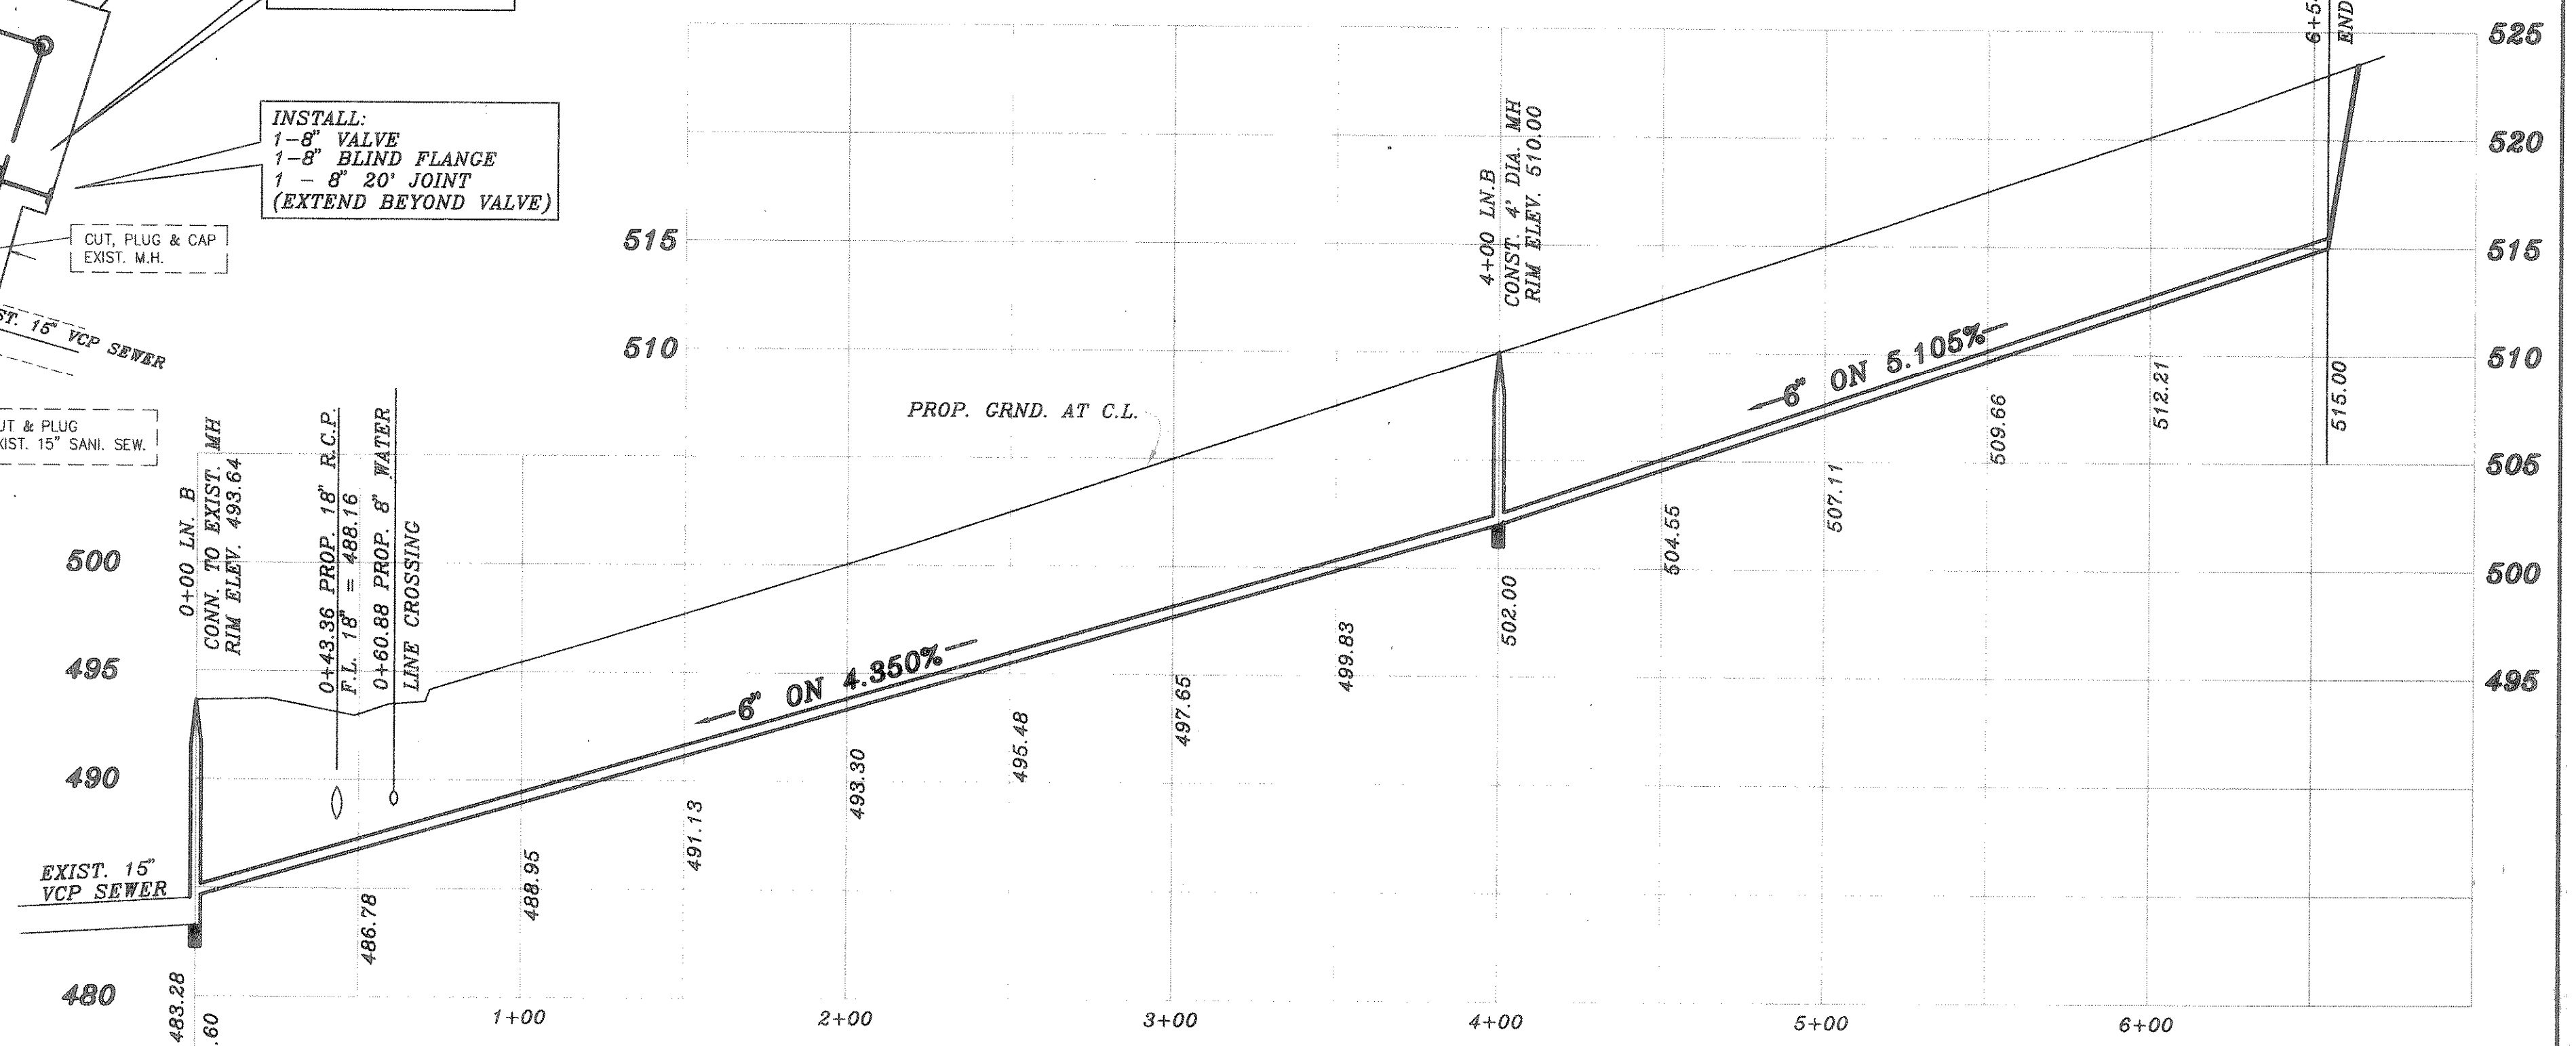


CURVE	RADIUS	LENGTH	TANGENT	CHORD	DELTA
C1	150.00'	117.308'	61.839'	114.342'	44°48'31"
C2	844.500'	140.107'	70.214'	139.946'	09°30'20"

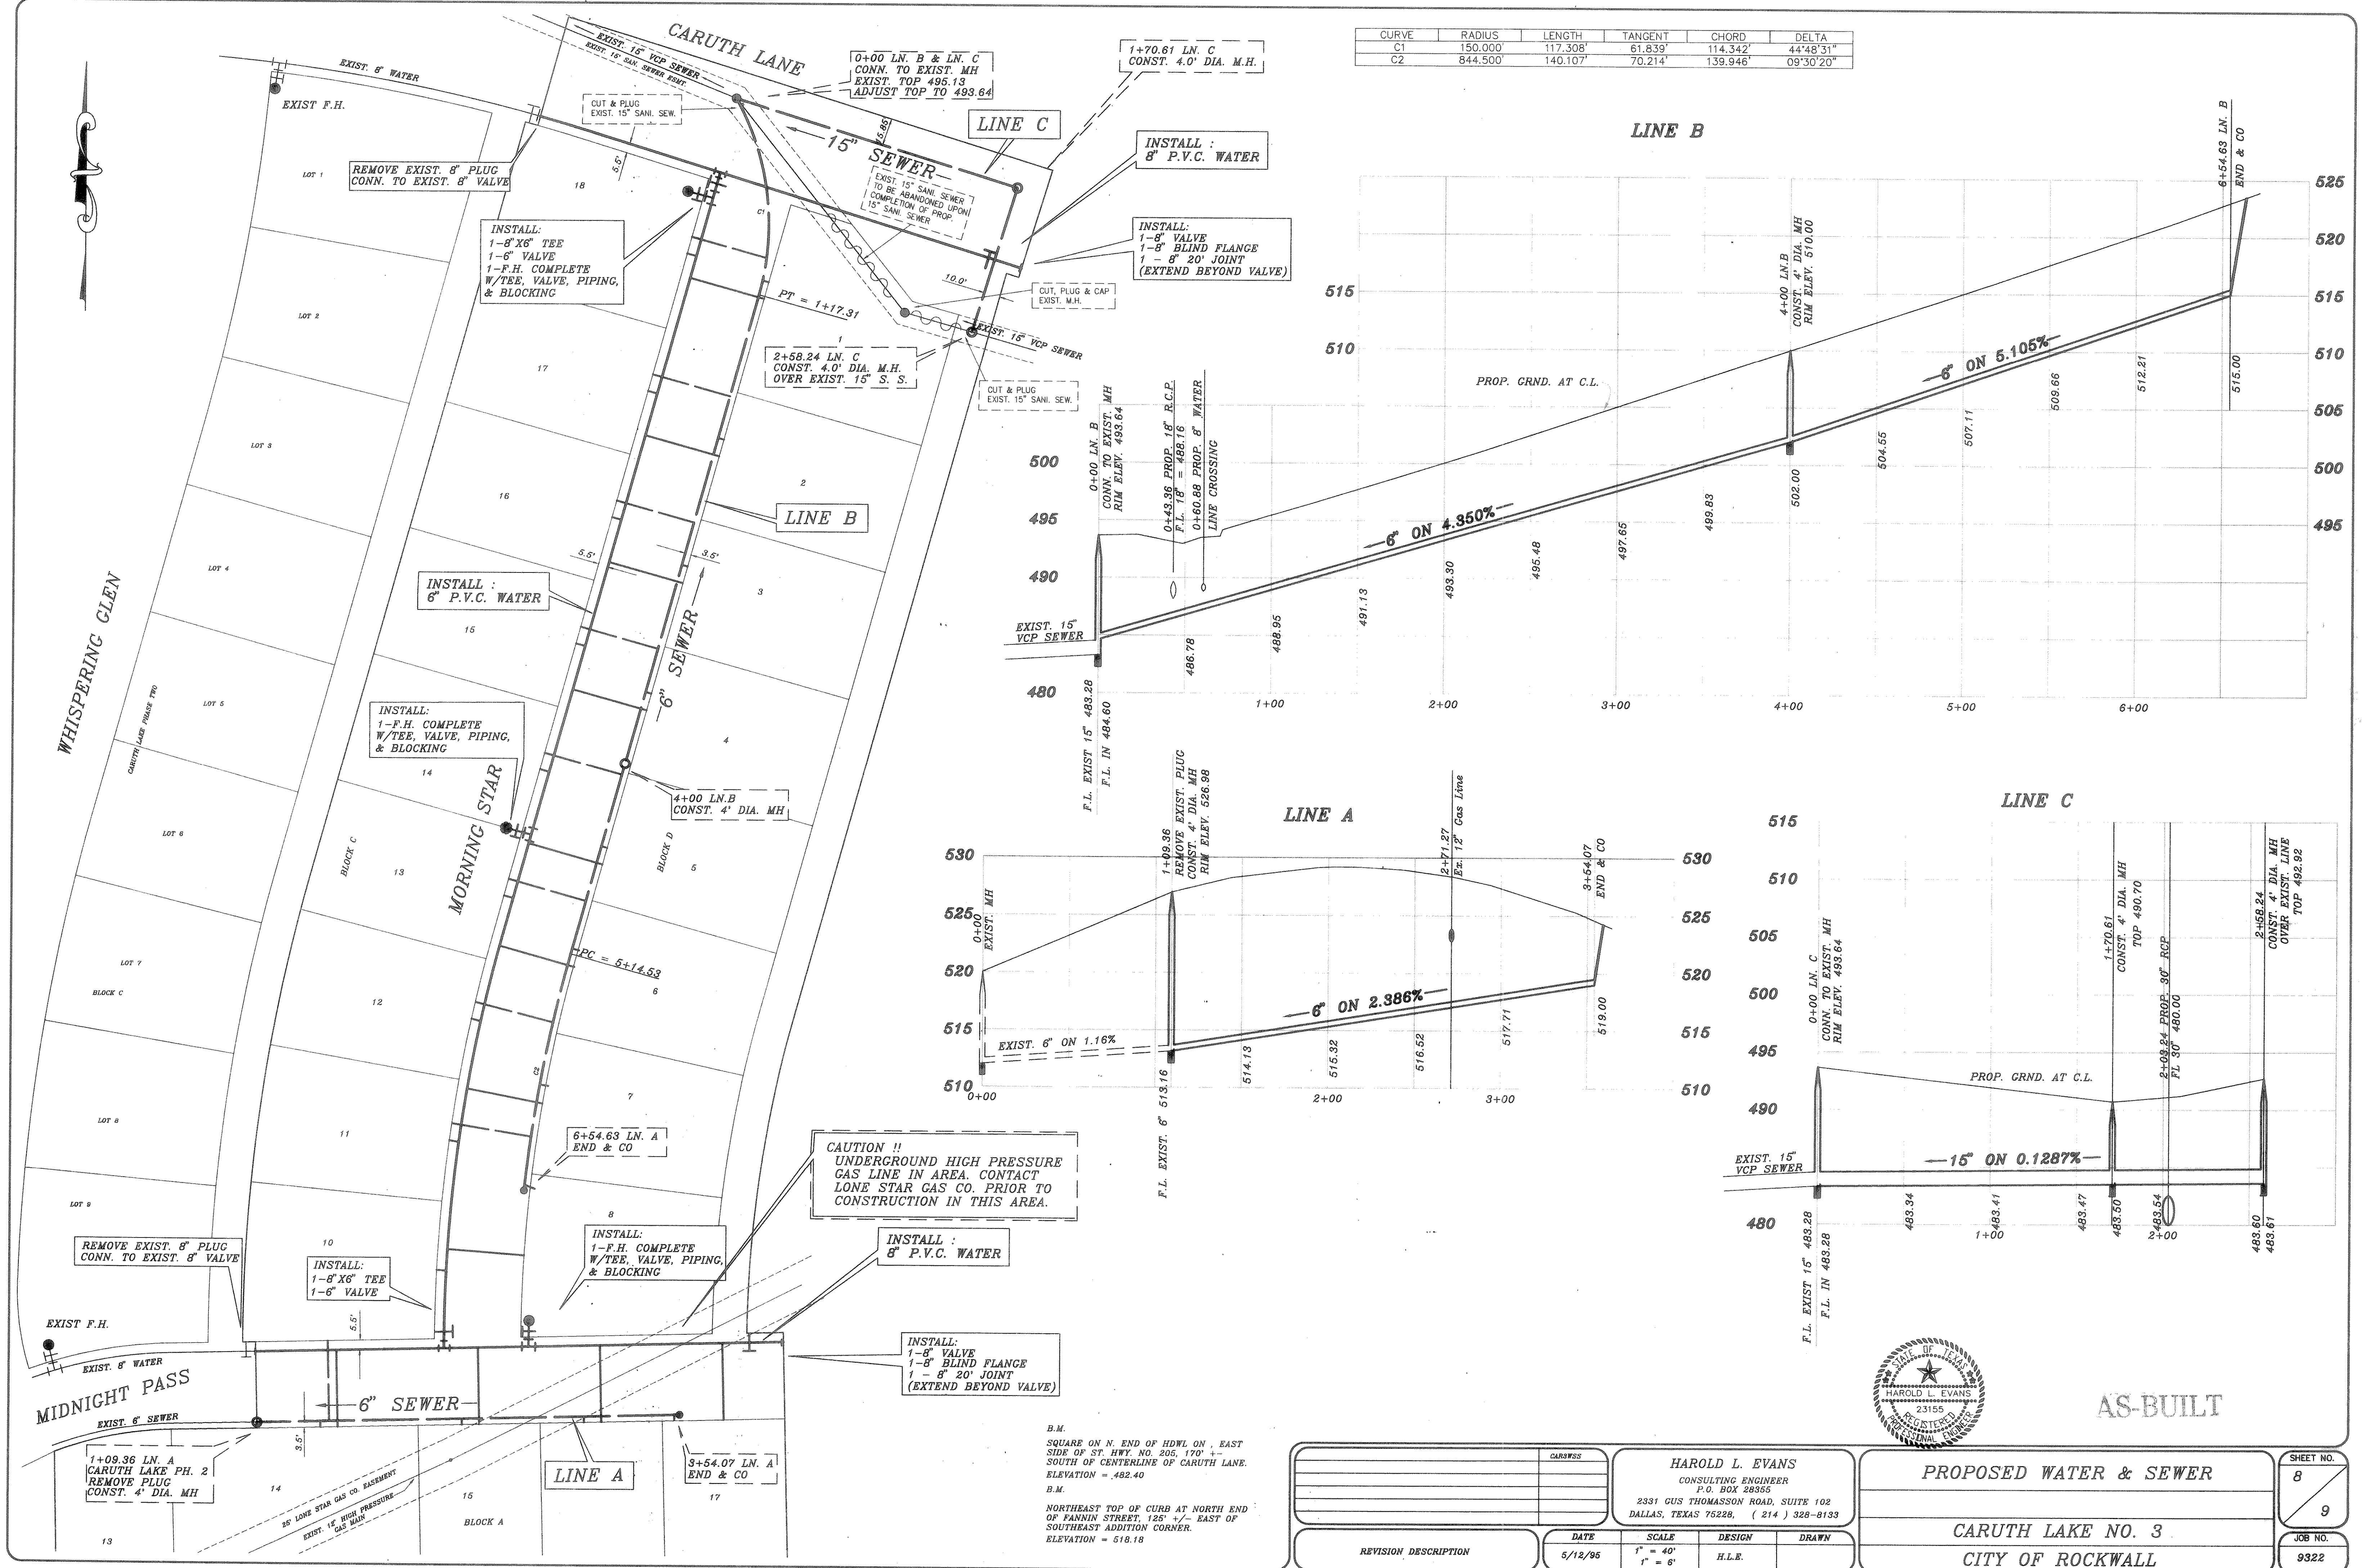

CAUTION !!
 UNDERGROUND HIGH PRESSURE
 GAS LINE IN AREA. CONTACT
 LONE STAR GAS CO. PRIOR TO
 CONSTRUCTION IN THIS AREA.

B.M.
 SQUARE ON N. END OF HDWL ON EAST
 SIDE OF ST. HWY. NO. 205, 170' +/-
 SOUTH OF CENTERLINE OF CARUTH LANE.
 ELEVATION = 482.40
 B.M.
 NORTHEAST TOP OF CURB AT NORTH END
 OF PANNIN STREET, 125' +/- EAST OF
 SOUTHEAST ADDITION CORNER.
 ELEVATION = 518.18

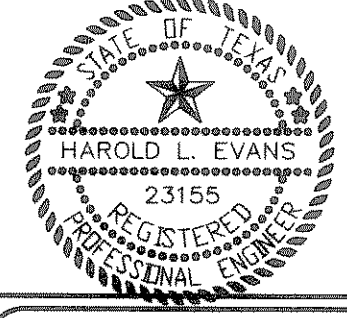

AS-BUILT

HAROLD L. EVANS CONSULTING ENGINEER P.O. BOX 28355 2331 GUS THOMASSON ROAD, SUITE 102 DALLAS, TEXAS 75228, (214) 328-8133		SHEET NO. 8 9
PROPOSED WATER & SEWER CARUTH LAKE NO. 3 CITY OF ROCKWALL		JOB NO. 9322
REVISION DESCRIPTION CARWSS	DATE 5/12/95	SCALE 1" = 40' 1" = 6'
DESIGN H.L.E.	DRAWN	