

LEGEND
 -490- EX. CONTOURS
 -490- PROP. CONTOURS

CARUTH LAKE

NORMAL POOL
 ELEV. 477.50

FUTURE CITY PARK

CARUTH LANE


ALLEY #1

BIG OAK COURT
 SEE SHEET NO. 7

MATCH LINE
 SEE SHEET NO. 5A

ASBULT
 Winkelman & Associates, Inc. hereby states that the
 design and construction of the improvements shown
 hereon have been made as per the approved construction
 documents prepared by Winkelman & Associates, Inc. and
 that the contractor shall be responsible for the
 quality of construction and for the maintenance of
 the improvements.
 Winkelman & Associates, Inc.
 DATE

Winkelman & Associates, Inc.
 CONSULTING CIVIL ENGINEERS & SURVEYORS
 12800 Wilshire Blvd., Suite 200
 Dallas, Texas 75250
 (214) 460-7000
 (214) 460-7001, TX

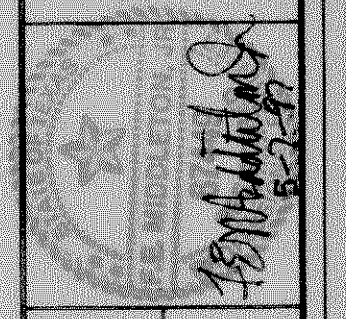

CARUTH LAKE PHASE FOUR
 S.S. MCCURRY SURVEY, ABSTRACT NO. 146
 M.B. JONES SURVEY, ABSTRACT NO. 122
 CITY OF ROCKWALL
 ROCKWALL COUNTY, TEXAS
 LUMBERMEN'S INVESTMENT CORPORATION
 5485 BELTLINE ROAD, SUITE 225
 DALLAS, TEXAS 75240

**GRADING PLAN
 NORTH OF CARUTH LANE**

Scale: 1"=40' Date: 10-9-97
 Designed By: RB
 Drawn By: MK
 Checked By: F.E.M.
 File: 14633GR1.DWG
 Project No.: 14633.01(20)

SHEET
 5
 OF
 29