

☺ CURVE DATA

CURVE	RADIUS	DELTA	TANGENT	LENGTH	CHORD	BEARING
C-1	200.00'	167°45'00"	26.55'	56.71'	56.52'	N09°31'25"W
C-2	200.00'	170°20'00"	30.08'	59.49'	59.49'	S09°05'40"E
C-3	200.00'	142°15'00"	25.19'	53.11'	49.98'	S05°45'30"W
C-4	200.00'	133°58'00"	23.82'	47.42'	47.31'	N08°09'43"E

AS BUILT


Winkelmann & Associates, Inc. hereby states that this plan, to the best of our knowledge is "As Built." Modifications from the originally approved construction documents have been made as per information provided by the contractor. Winkelmann & Associates, Inc. does not certify as to the correctness or quality of construction as no field inspection was performed.

*[Signature]*  
WINKELMANN & ASSOCIATES, INC.  
DATE: 7-20-03



BENCHMARK:  
PK NAIL IN ☺ OF CARUTH LANE & ALLEY INTERSECTION 150'± EAST OF MORNINGSTAR DRIVE. ELEV. 491.68

BENCHMARK:  
"X" CHISELED IN ☺ OF ALLEY EAST OF MORNINGSTAR DRIVE WITHIN 3RD LOT NORTH OF MIDNIGHT PASS. ELEV. 513.26

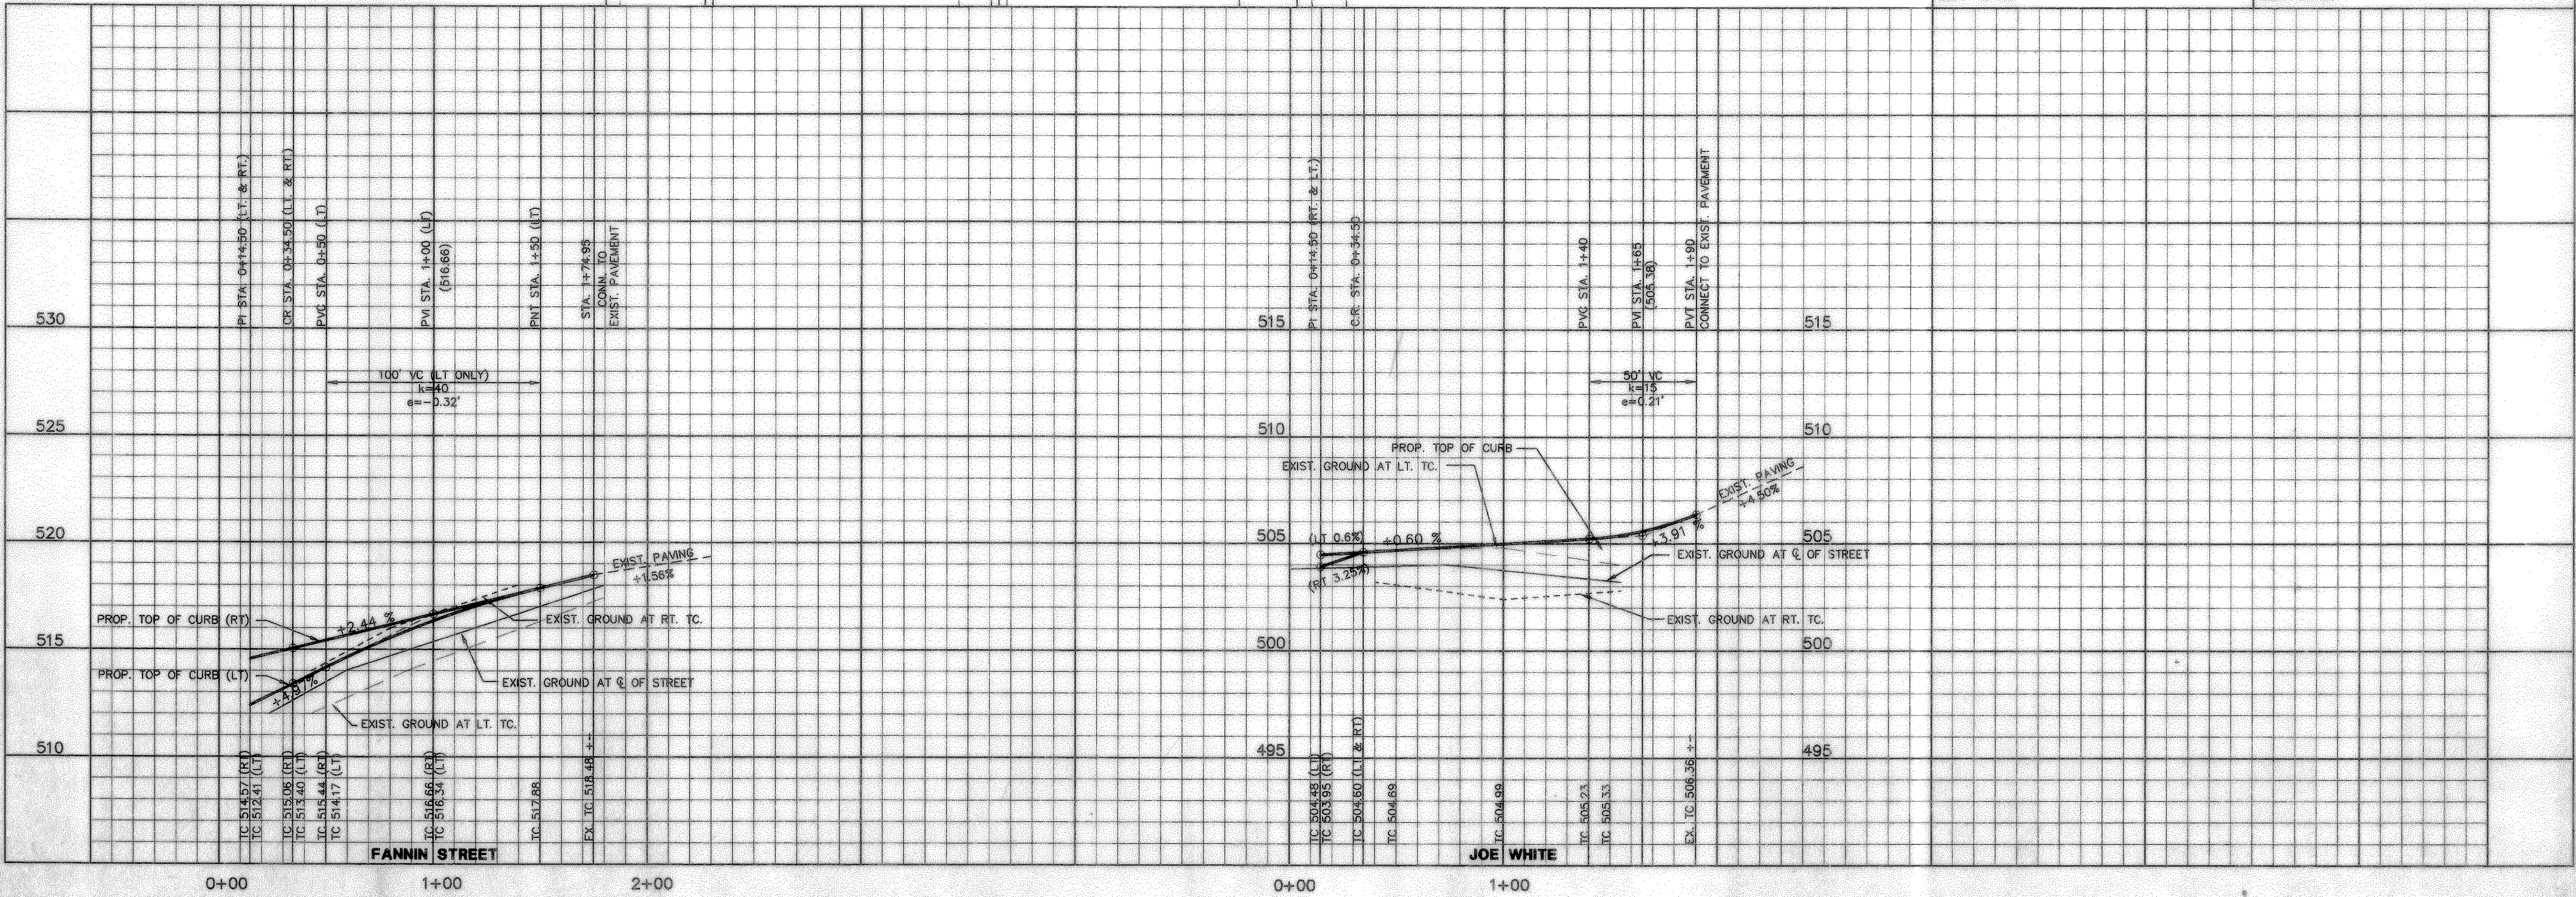

**Winkelmann & Associates, Inc.**  
CONSULTING CIVIL ENGINEERS & SURVEYORS  
1300 Wilshire Blvd., Suite 202  
Dallas, Texas 75201  
(214) 462-7059 FAX



CARUTH LAKE PHASE FOUR  
S.S. MOJES SURVEY, ABSTRACT NO. 122  
CITY OF ROCKWALL, TEXAS  
LUMBERMEN INVESTMENT CORPORATION  
5495 BELLEVUE ROAD, SUITE 223  
DALLAS, TEXAS 75240

**PAVING PLAN & PROFILE**  
**FANNIN STREET STA. 0+00 TO STA. 1+74.95**  
**JOE WHITE STA. 0+00 TO STA. 1+66.29**  
**ALLEY '4' STA. 0+00 TO STA. 1+11.89**

Scale: 1"=40' Date: 5-9-03  
Designed By: RE  
Drawn By: MK  
Checked By: F.E.M.  
File: 14633P7.DWG  
Project No.: 14633.01(20)