
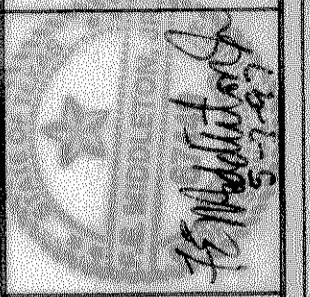


BENCHMARK:  
PK NAIL IN C. OF CARUTH LANE & ALLEY INTER-SECTION 150'± EAST OF MORNINGSTAR DRIVE. ELEV. 491.68

BENCHMARK:  
"X" CHISELED IN C. OF ALLEY EAST OF MORNINGSTAR DRIVE WITHIN 3RD LOT NORTH OF MIDNIGHT PASS. ELEV. 513.26

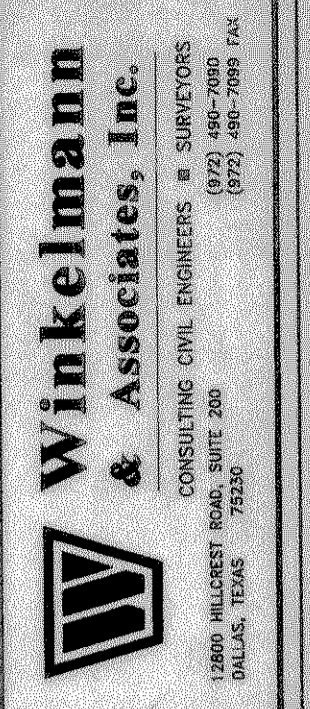

CARUTH LAKE PHASE FOUR  
S.S. MCCURRY SURVEY, ABSTRACT NO. 148  
M.B. JONES SURVEY, ABSTRACT NO. 122  
CITY OF ROCKWALL  
ROCKWALL COUNTY, TEXAS

LUMBERMEN'S INVESTMENT CORPORATION  
5949 DALLAS, TEXAS 75240

**PAVING PROFILES  
ALLEY '1' & ALLEY '3'**

Scale: 1"=40' H Date: 5-9-97  
Designed By: K.C.  
Drawn By: MK  
Checked By: F.E.M.  
File: 14633A13.DWG  
Project No.: 14633.01

Winkelmann & Associates, Inc. hereby states that this plan, specification and contract documents were prepared by the original engineer or architect. Modifications from the originally approved construction documents have been made as per information provided by the contractor, Winkelmann & Associates, Inc. does not certify as to the correctness or quality of construction as no field inspection was performed.

*F.E.M.*  
WINKELMANN & ASSOCIATES, INC. DATE: 7-20-97