


**LEGEND**  
 - - - EX. CONTOURS  
 ——— PROP. CONTOURS

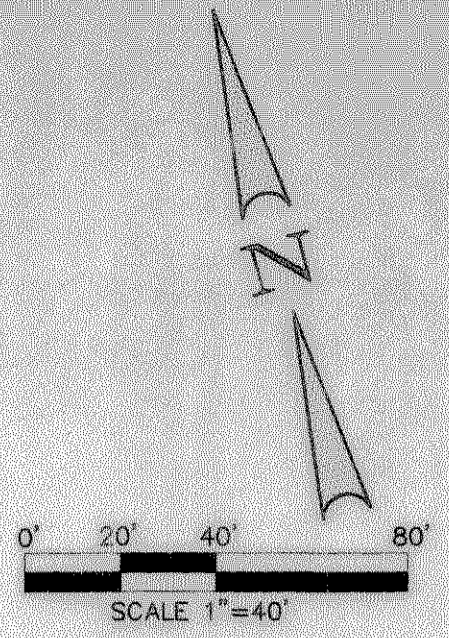


NORMAL POOL  
 ELEV. 477.50

REFER TO PLANS PREPARED BY WINKELMANN & ASSOCIATES, INC.  
 FOR CARUTH LAKE, PHASE FIVE DATED FEBRUARY, 1997  
 FOR CONTINUATION OF GRADING CONTOURS.

ASBUILT

Winkelmann & Associates, Inc. hereby states that this plan, to the best of our knowledge is the final. Modifications from the originally approved construction documents have been made as per information provided by the contractor. Winkelmann & Associates, Inc. does not carry a liability for the consequences or quality of construction as no field inspection was performed.  
*[Signature]*  
 WINKELMANN & ASSOCIATES, INC. DATE 7-30-98

**Winkelmann & Associates, Inc.**  
 CONSULTING CIVIL ENGINEERS & SURVEYORS  
 12000 Hillcrest Road, Suite 300  
 Dallas, Texas 75230  
 (214) 490-1999 FAX

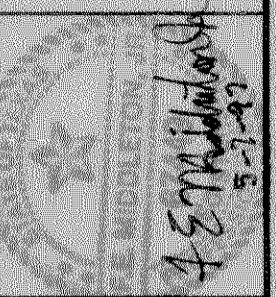

CARUTH LAKE PHASE FOUR  
 S.S. McCURRY SURVEY, ABSTRACT NO. 146  
 M.B. JONES SURVEY, ABSTRACT NO. 122  
 CITY OF ROCKWALL  
 ROCKWALL COUNTY, TEXAS  
 LUMBERMEN'S INVESTMENT CORPORATION  
 5495 BELTLINE ROAD, SUITE 225  
 DALLAS, TEXAS 75240

**GRADING PLAN  
 NORTH OF CARUTH LANE**

Scale: 1"=40'  
 Date: 5-9-97  
 Designed By: RB  
 Drawn By: MK  
 Checked By: F.E.M.  
 File: 14633G02.DWG  
 Project No.: 14633.01(20)

**SHEET**  
 5A  
 OF  
 29