

BENCHMARK: PK NAIL IN C OF CARUTH LANE & ALLEY INTERSECTION 150'± EAST OF MORNINGSTAR DRIVE. ELEV. 491.68

BENCHMARK: PK CHISEL IN C OF ALLEY EAST OF MORNINGSTAR DRIVE WITHIN 3RD LOT NORTH OF MIDNIGHT PASS. ELEV. 513.26

STA. 2+86.73  
CONST. STD. 4" DIA. M.H.  
CONCRETE  
CONCRETE TO FIELD  
VERIFY HORIZONTAL AND  
VERTICAL LOCATION OF  
EXIST. 10" S.S. AND  
DISCOVER ANGLES TO  
ENGINEER

STA. 0+00 LINE "H"  
STA. 1+74.77 LINE "H"  
CONST. STD. 4" DIA. M.H.


STA. 6+56.00  
CONST. STD. CLEANOUT

STA. 4+75.00  
CONST. STD. 4" DIA. M.H.

STA. 0+16.96 LINE "C"  
STA. 9+59.35 LINE "A"  
CONST. 5" DIA. M.H.

Winkelmann & Associates, Inc. hereby states that this plan, to the best of our knowledge and belief, represents the original approved construction documents. We do not warrant the accuracy or quality of construction as no high pressure or low pressure.

*J.E. Winkelmann*  
DATE: 7-20-98

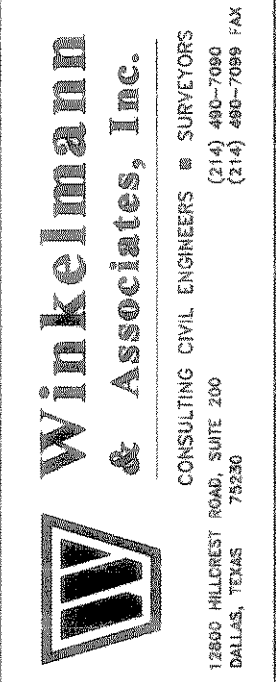

CURTIS LANE PHASE FOUR  
S.S. MURPHY SURVEY, ABSTRACT NO. 146  
M.B. JONES SURVEY, ABSTRACT NO. 122  
CITY OF ROCKWALL  
ROCKWALL COUNTY, TEXAS

**SANITARY SEWER PROFILES**  
**LINE 'C', LINE 'H' & LINE 'J'**

Scale: 1" = 4'-0"  
Date: 5-9-97  
Designed By: R.B.  
Drawn By: MK  
Checked By: F.E.M.  
File: 146333S.C.DWG  
Project No.: 14633.01