


BENCHMARK: PK NAIL IN C OF CARUTH LANE & ALLEY INTERSECTION 150'± EAST OF MORNINGSTAR DRIVE. ELEV. 491.68

BENCHMARK: "X" CHISSELED IN C OF ALLEY EAST OF MORNINGSTAR DRIVE WITHIN 3RD LOT NORTH OF MIDNIGHT PASS. ELEV. 513.26

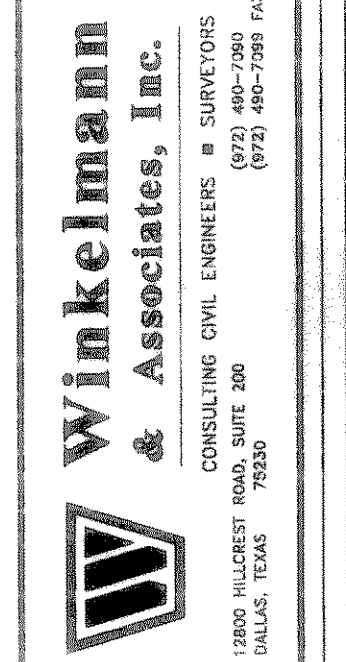

CITY OF HOUSTON
S.S. MURPHY SURVEY, ABSTRACT NO. 145
M.B. JONES SURVEY, ABSTRACT NO. 122
CITY OF HOUSTON
HOUSTON, TEXAS

LUMBERMEN'S INVESTMENT CORPORATION
5465 BELTLINE ROAD, SUITE 225
DALLAS, TEXAS 75240

STORM SEWER PROFILES
LINE '1', LINE '2' & LINE '3'

Scale: 1"=20' Date: 5-9-97
Designed By: K.G.
Drawn By: MK
Checked By: F.E.M.
File: 14633SIDWG
Project No.: 14633.01

ASSEMBLY
Winkelmann & Associates, Inc. hereby states that this plan, to the best of our knowledge and belief, was prepared from the original approved construction documents and that no information has been added or changed since the original information was provided by the contractor. Winkelmann & Associates, Inc. does not warrant the accuracy or quality of construction as no field inspection was performed.

[Signature]
WINKELMANN & ASSOCIATES, INC. DATE