
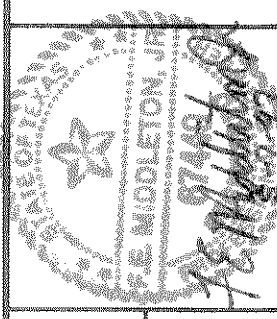


BENCHMARK:
PK NAIL IN E OF CARUTH LANE & ALLEY INTER-
SECTION 150'± EAST OF MORNINGSTAR DRIVE.

BENCHMARK:
"X" CHISELED IN E OF ALLEY EAST OF MORNINGSTAR
DRIVE WITHIN 3RD LOT NORTH OF MIDNIGHT PASS.
ELEV. 513.26

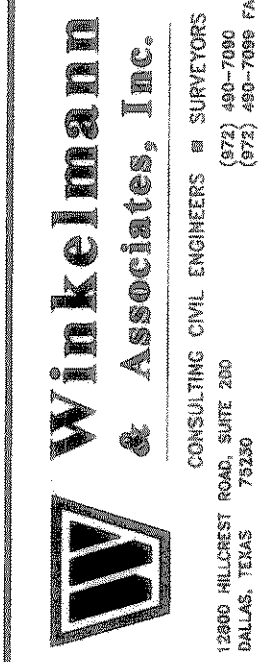

CARUTH LANE PHASE FOUR
S.S. SURVEY, PROJECT NO. 146
41.6 ACRES SURVEY, PROJECT NO. 12
ROCKWALL COUNTY, TEXAS
LAWRENCE INVESTMENT CORPORATION
5406 BELLEVUE ROAD, SUITE 225
DALLAS, TEXAS 75240

**STORM SEWER PROFILES
LINE 4, LINE 5 & LINE 6**

Scale: 1" = 10' H
Date: 5-9-97
Designed By: K.G.
Drawn By: T.C.
Checked By: F.E.M.
File: 14633SP2.DWG
Project No.: 14633.01

Winkelmann & Associates, Inc. hereby states that this plan, as shown, was prepared by its duly qualified and licensed professional engineers and that the design and construction of the project shown herein is in accordance with the applicable laws, rules, regulations and codes of the State of Texas. The contractor shall be responsible for the construction of the project in accordance with the approved construction documents. Winkelman & Associates, Inc. does not warrant the quality of construction or the performance of the project.

T.C. Winkler
7-30-97
WINKELMANN & ASSOCIATES, INC.