


No.	DATE	REVISION	APPROV.

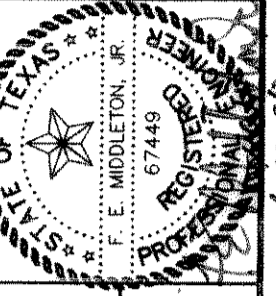


CARUTH LAKE PHASE FIVE  
 S.S. MCCURRY SURVEY, ABSTRACT NO. 146  
 M.B. JONES SURVEY, ABSTRACT NO. 122  
 CITY OF ROCKWALL  
 ROCKWALL COUNTY, TEXAS

LUMBERMEN INVESTMENT CORPORATION  
 5499 BELLEVILLE ROAD  
 DALLAS, TEXAS 75240

**PAVING PROFILES**  
**ALLEY '10' & ALLEY '11'**

Scale: 1" = 4'-0"  
 Date: 5/28/98  
 Designed By: K.G.  
 Drawn By: MK  
 Checked By: PEM  
 File: 14633ALL3.DWG  
 Project No.: 14633.01(20)

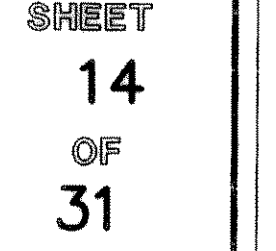

AS BUILT  
 Winkelman & Associates, Inc. hereby states that this plan, to the best of our knowledge is "As Built." Modifications from the originally approved construction documents have been made as per information provided by the contractor, Winkelman & Associates, Inc. whose responsibility as to the correctness of quality of construction as noted inspection was performed.  
 K.G. Winkelman  
 WINKELMANN & ASSOCIATES (INC.)  
 DATE: 10/14/99