
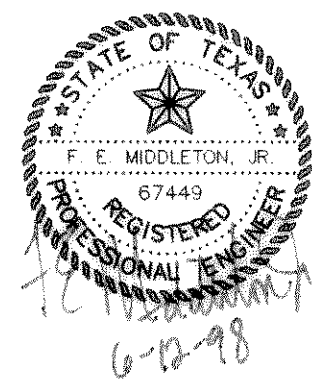


CONSTRUCTION PLANS FOR CARUTH LAKE PHASE FIVE

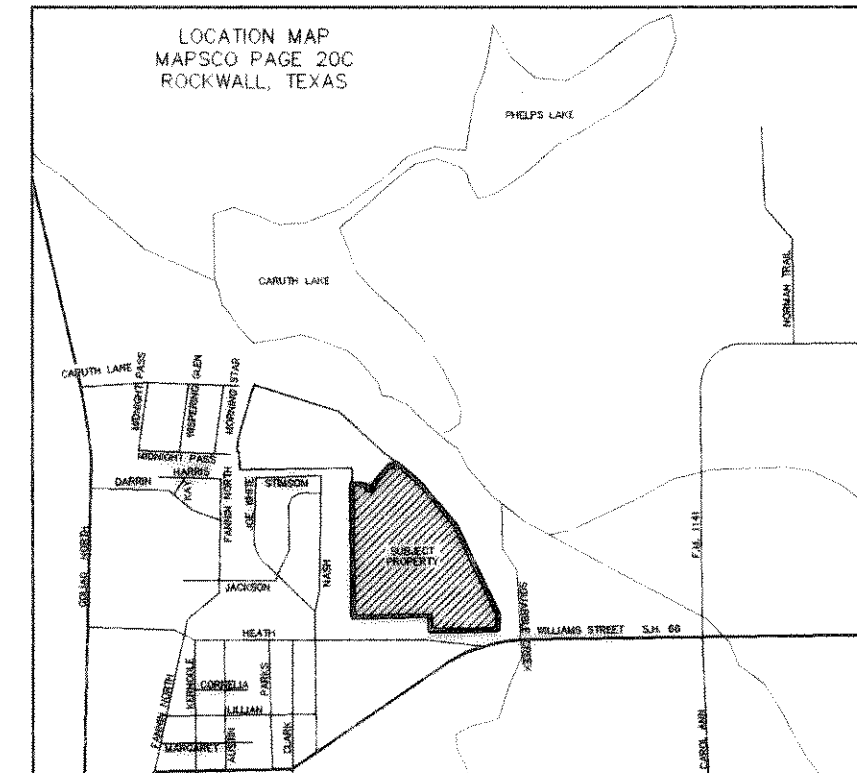

CITY OF ROCKWALL
ROCKWALL COUNTY, TEXAS

JUNE 11, 1998

DEVELOPER:

LUMBERMEN'S INVESTMENT CORPORATION
5495 BELTLINE ROAD, SUITE 225
DALLAS, TEXAS 75240

SHEET INDEX

- COVER SHEET
- FINAL PLAT
- 1. GENERAL NOTES
- 2. DRAINAGE AREA MAP
- 3. PAVING & DRAINAGE PLAN / PAVING PROFILE
WISPERWOOD DRIVE STA. 3+40.97 TO STA. 13+00
- 4. PAVING & DRAINAGE PLAN / PAVING PROFILE
WISPERWOOD DRIVE STA. 13+00 TO STA. 14+60.55
HIGH COTTON LANE STA. 14+60.55 TO STA. 20+50
ALLEY "11" STA. 0+00 TO STA. 2+00
- 5. PAVING & DRAINAGE PLAN / PAVING PROFILE
HIGH COTTON LANE STA. 20+50 TO STA. 26+73.41
ALLEY "11" STA. 2+00 TO STA. 7+25.01
- 6. PAVING & DRAINAGE PLAN / PAVING PROFILE
CARUTH LANE STA. 16+42.21 TO STA. 26+50
- 7. PAVING & DRAINAGE PLAN / PAVING PROFILE
CARUTH LANE STA. 26+50 TO STA. 36+46.92
- 8. PAVING & DRAINAGE PLAN / PAVING PROFILE
DOGWOOD LANE STA. 0+00 TO STA. 8+65.61
ALLEY "13" STA. 0+00 TO STA. 3+30.01
ALLEY "7" STA. 0+00 TO STA. 10+78.35
- 9. PAVING & DRAINAGE PLAN / PAVING PROFILE
SAFFLOWER COURT STA. 0+00 TO STA. 3+91.12
ALLEY "8" STA. 0+00 TO STA. 6+41.09
- 10. PAVING & DRAINAGE PLAN / PAVING PROFILE
REDWOOD TRAIL STA. 0+00 TO STA. 9+96.67
ALLEY "9" STA. 0+00 TO STA. 4+79.41
- 11. PAVING & DRAINAGE PLAN / PAVING PROFILE
STARLIGHT PLACE STA. 0+00 TO STA. 6+39.25
ALLEY "10" STA. 0+00 TO STA. 11+18.50
- 11A. GRADING AND EROSION CONTROL PLAN
NORTH OF CARUTH LANE
- 12. ALLEY "7" & ALLEY "13" PROFILES
- 13. ALLEY "8" & ALLEY "9" PROFILES
- 14. ALLEY "10" & ALLEY "11" PROFILES
- 15. STORM SEWER PROFILES
LINE "1", LINE "2", LINE "3" & LINE "4"
- 16. STORM SEWER PROFILES
LINE "5" & LINE "6"
- 17. STORM SEWER PROFILES
LINE "7"
- 18. STORM SEWER PROFILES
LINES "8", "9" & "10"
- 19. WATER & SANITARY SEWER PLAN
- 20. WATER & SANITARY SEWER PLAN
- 21. SANITARY SEWER PROFILES
LINE "B" & LINE "F"
- 22. SANITARY SEWER PROFILES
LINE "D" & LINE "E"
- 23. SANITARY SEWER PROFILES
LINE "C"
- 24. SANITARY SEWER PROFILES
LINE "H"
- 25. SANITARY SEWER PROFILES
LINE "G"
- 26. STORM WATER POLLUTION PREVENTION PLAN
- 27. LOT GRADING PLAN
- 28. LOT GRADING PLAN
- 29. LOT GRADING PLAN
- 29A. WALL DETAILS
- 30. TREESCAPE PLAN
- 31. TREESCAPE PLAN

ASBUILT

Winkelmann & Associates, Inc. hereby states that this plan, to the best of our knowledge is "As Built." Modifications from the originally approved construction documents have been made as per information provided by the contractor. Winkelmann & Associates, Inc. does not certify as to the correctness or quality of construction as no field inspection was performed.
J. E. Winkelmann, Jr. 10-14-99
WINKELMANN & ASSOCIATES, INC. DATE

Winkelmann & Associates, Inc.

CONSULTING CIVIL ENGINEERS ■ SURVEYORS
12800 HILLCREST ROAD, SUITE 200 (972) 490-7090
DALLAS, TEXAS 75230 (972) 490-7099 FAX