


BENCHMARK:  
PK NAIL IN C OF CARUTH LANE & ALLEY INTER-  
SECTION 150± EAST OF MORNINGSTAR DRIVE.  
ELEV. 491.68

BENCHMARK:  
"X" CHISELED IN C OF ALLEY EAST OF MORNINGSTAR  
DRIVE WITHIN 3RD LOT NORTH OF MIDNIGHT PASS.  
ELEV. 513.26

No.	DATE	REVISION	APPROV.

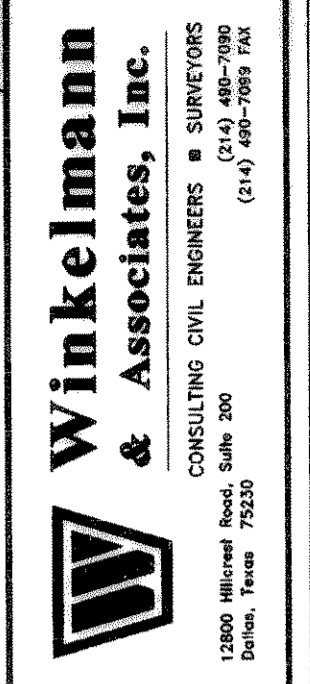

CARUTH LAKE PHASE FIVE  
S.S. McCURRY SURVEY, ABSTRACT NO. 146  
M.B. JONES SURVEY, ABSTRACT NO. 122  
ROCKWALL COUNTY, TEXAS

LUMBERMEN'S INVESTMENT CORPORATION  
5495 LUMBERMEN ROAD, SUITE 225  
DALLAS, TEXAS 75240

**PAVING PROFILE**  
**ALLEY '7' STA. 0+00 TO STA.10+63.85**  
**ALLEY '13' STA. 0+00 TO STA.3+15.51**

Winkelman & Associates, Inc. hereby states that this plan, to the best of our knowledge as "as built" modifications from the originally approved construction documents have been made in accordance with the requirements of the contractor, Winkelman & Associates, Inc. does not accept any responsibility for the correctness or quality of construction as no field inspection was performed.

*J.S. Winkelman*  
WINKELMAN & ASSOCIATES, INC.  
DATE: 10-14-99

Scale: 1" = 4'-0"  
Date: 5/28/98  
Designed By: K.G.  
Drawn By: MK  
Checked By: FEM  
File: 14633ALI.DWG  
Project No.: 14633.01(20)