


BENCHMARK:
PK NAIL IN @ OF CARUTH LANE & ALLEY INTER-SECTION 150'± EAST OF MORNINGSTAR DRIVE. ELEV. 491.68

BENCHMARK:
"X" CHISEL IN @ OF ALLEY EAST OF MORNINGSTAR DRIVE WITHIN 3RD LOT NORTH OF MIDNIGHT PASS. ELEV. 513.26

| No. | DATE | REVISION | APPROV. |
|-----|------|----------|---------|
| | | | |

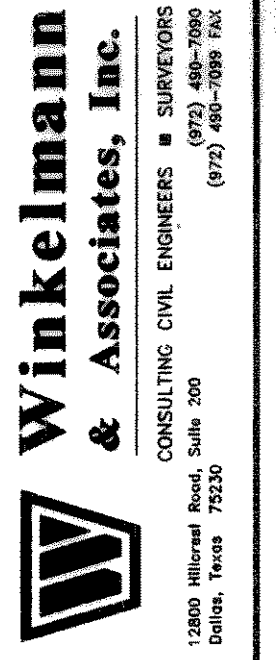

CARUTH LAKE PHASE FIVE
S.S. MCCURRY SURVEY, ABSTRACT NO. 146
M.B. JONES & COMPANY, INC.
CITY OF ROCKWALL
ROCKWALL COUNTY, TEXAS

LUMBERMEN'S INVESTMENT CORPORATION
5495 W. LANTANA, SUITE 225
DALLAS, TEXAS 75240

PAVING PROFILE
ALLEY '8' STA. 0+00 TO STA. 6+01.59
ALLEY '9' STA. 0+06 TO STA. 4+64.91

ASBUILT
Winkelman & Associates, Inc. hereby states that this plan to the best of our knowledge is "As Built". Modifications from the original plan were made as part of the construction process. Winkelman & Associates, Inc. does not warrant as to the correctness or quality of construction or field inspection was performed.

J.S. Modesto
WINKELMANN & ASSOCIATES, INC. DATE 10-14-99

Scale: 1" = 40' Date: 5/27/98
Designed By: K.G.
Drawn By: MK
Checked By: FEM
File: 14633ALL2.DWG
Project No.: 14633 01 (20)