

CULVERT "1" DESIGN CALCULATIONS

CULVERT LOCATION: GARUTH LAKE PHASE 6, ROCKWALL, TEXAS
 LENGTH, L 112.18 FT DESIGN STORM FREQ. 100-YR
 ROUGHNESS COEFF., n 0.012 MAX. VEL. 12.0 ft/sec
 TAILWATER 1.38' D.S. CHANNEL WIDTH 6'
 ENTRANCE DESCRIPTION 3A DESIGN DISCHARGE 100.84 cfs

RDWY. ELEV. 502.00 U.S. CULV. F.L. 497.02
 U.S. CULV. F.L. 497.02 D.S. CULV. F.L. 495.00
 DIFFERENCE 4.98' DIFFERENCE 2.02'
 REQ'D. FREEBOARD 1.0 FT. CULV. SLOPE, S₀ 0.012
 ALLOW. HEADWATER 3.98' FT. S₀ = 2.02 FT. = 1.80%
 112.0

DOWNSTREAM CHANNEL CALCULATIONS

Q₁₀₀ = 100.84 cfs
 n = 0.035
 SIDE SLOPE (L & RT) = 3:1
 LONGITUDINAL SLOPE = 3.10%
 DEPTH OF FLOW = 1.38 ft
 AVERAGE VELOCITY = 7.23 fps

CULVERT "1"

TRIAL CULVERT										HEADWATER CALCULATION																			The Greater Controlling Head Water (Inlet or Outlet) (feet)	SELECTED CONDUIT SIZE
Trial Area of Opening T.A.c = $\frac{Q}{V_{max}}$ (sq. ft.)	Channel Width "W" (feet)	DEPTH RANGE D.R.		POSSIBLE CULVERT SIZES					INLET CONTROL (Using Figure 11)					OUTLET CONTROL (Using Figure 14 & 30)																
		T.A.c	AHW	No.	Width of Box "D" (ft.)	Total Culvert Area "A _c " (sf)	"Q" Each Opening (c.f.s.)	Entrance Type	Case No.	Q/B (c.f.s.)	HW/D (figure 25)	HW (feet)	Entrance Coeff. K _e	CASE III HW = H + TW - L X S ₀ (feet)			CASE IV HW = H + h ₀ - L X S ₀ (feet)													
														"H" (figure 27)	"TW" (feet)	L X S ₀ (feet)	"HW" (feet)	"H" (figure 27)	h ₀ = $\frac{d_c + D}{2}$ (figure 30)	$\frac{d_c + D}{2}$ (feet)	"TW" (feet)	h ₀ (feet)	L X S ₀ (feet)	"HW" (feet)						
1	2	3	4	5	6	8	9	10	11	12	13	14	15	16	17	18	19	20	21	22	23	24	25	26	27	28	29			
8.42	6'	1.40	3.98	3	1	6	18	101.11	3A	1	16.85	1.30	3.75	0.70	1.30	1.38	2.02	0.66	1.30	2.0	2.50	1.38	2.50	2.02	1.78	3.90' (INLET)	6'x3' RCB			

CULVERT "2" DESIGN CALCULATIONS

CULVERT LOCATION: GARUTH LAKE PH 6, ROCKWALL, TEXAS
 LENGTH, L 123.42 FT DESIGN STORM FREQ. 100-YR
 ROUGHNESS COEFF., n 0.012 MAX. VEL. 12.0 ft/sec
 TAILWATER 1.85' D.S. CHANNEL WIDTH 6'
 ENTRANCE DESCRIPTION 3A DESIGN DISCHARGE 72.81 cfs

RDWY. ELEV. 526.00 U.S. CULV. F.L. 526.19
 U.S. CULV. F.L. 526.19 D.S. CULV. F.L. 525.50
 DIFFERENCE 3.81' DIFFERENCE 0.69'
 REQ'D. FREEBOARD 1.0 FT. CULV. SLOPE, S₀ 0.005
 ALLOW. HEADWATER 2.81' FT. S₀ = 0.69 FT. = 0.50%
 138.60

DOWNSTREAM CHANNEL CALCULATIONS

Q₁₀₀ = 72.81 cfs
 n = 0.035
 SIDE SLOPE (L & RT) = 3:1
 LONGITUDINAL SLOPE = 0.50%
 DEPTH OF FLOW = 1.85 ft
 AVERAGE VELOCITY = 3.41 fps

CULVERT "2"


TRIAL CULVERT										HEADWATER CALCULATION																			The Greater Controlling Head Water (Inlet or Outlet) (feet)	SELECTED CONDUIT SIZE
Trial Area of Opening T.A.c = $\frac{Q}{V_{max}}$ (sq. ft.)	Channel Width "W" (feet)	DEPTH RANGE D.R.		POSSIBLE CULVERT SIZES					INLET CONTROL (Using Figure 11)					OUTLET CONTROL (Using Figure 14 & 30)																
		T.A.c	AHW	No.	Width of Box "D" (ft.)	Total Culvert Area "A _c " (sf)	"Q" Each Opening (c.f.s.)	Entrance Type	Case No.	Q/B (c.f.s.)	HW/D (figure 25)	HW (feet)	Entrance Coeff. K _e	CASE III HW = H + TW - L X S ₀ (feet)			CASE IV HW = H + h ₀ - L X S ₀ (feet)													
														"H" (figure 27)	"TW" (feet)	L X S ₀ (feet)	"HW" (feet)	"H" (figure 27)	h ₀ = $\frac{d_c + D}{2}$ (figure 30)	$\frac{d_c + D}{2}$ (feet)	"TW" (feet)	h ₀ (feet)	L X S ₀ (feet)	"HW" (feet)						
1	2	3	4	5	6	8	9	10	11	12	13	14	15	16	17	18	19	20	21	22	23	24	25	26	27	28	29			
6.06	6	0.61	2.81	2	2	4	16	36.40	3A	1	9.10	1.20	2.40	0.70	0.90	1.85	0.62	2.13	0.90	1.40	1.70	1.85	1.85	0.62	2.13	2.40' (INLET)	2-4'x2' RCB			

NOTE:
 FIG. 25, 27 & 29 ARE THE NOMOGRAPHS OF
 BUREAU OF PUBLIC ROADS, JAN. 1963, PAGE NO.
 G-25, G-27, G-29

BENCHMARK 1
 TOP OF GRATE INLET IN ALLEY NORTH OF LOT 10,
 BLOCK A OF SILVER CREEK CROSSING, PH III,
 SECT. 4 - ELEV. = 709.17

BENCHMARK 2
 SQUARE CUT FOUND IN THE CORNER OF CONCRETE
 ALLEY AT THE NORTHERLY MOST CORNER OF SILVER
 CREEK CROSSING PH. III, SECT. 4 - ELEV. = 723.0

- LEGEND**
- PP Power Pole
 - WV Water Valve
 - SN Sign
 - TSN Traffic Signs
 - LP Light Pole
 - W Water Line
 - OH Overhead Power Lines
 - 742- Proposed Contour Line
 - 742- Existing Contour Line

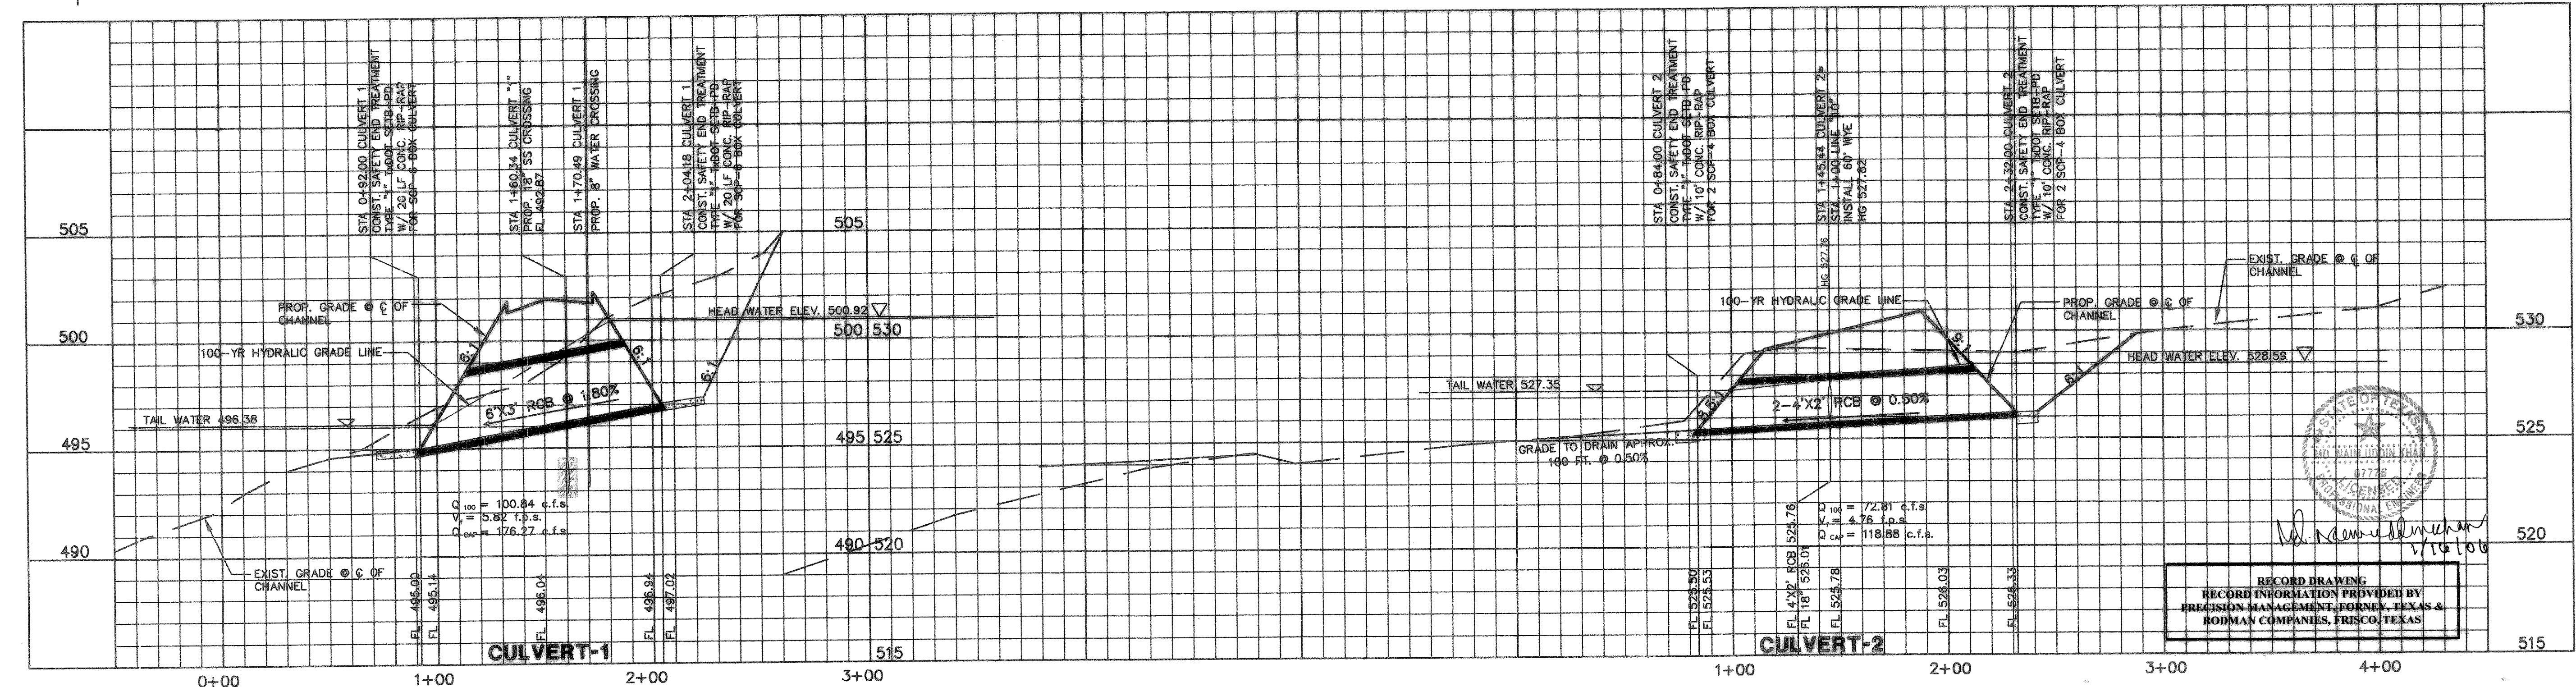


RECORD DRAWING
 RECORD INFORMATION PROVIDED BY
 PRECISION MANAGEMENT, FORTNEY, TEXAS &
 RODMAN COMPANIES, FRISCO, TEXAS

THESE CONSTRUCTION PLANS WERE PREPARED
 UNDER THE RESPONSIBLE SUPERVISION OF
 M.D. NAIMI UDDIN KHAN, REGISTERED PROFESSIONAL
 ENGINEER NO. 87776

THE SEAL APPEARING ON THIS
 DOCUMENT WAS AUTHORIZED BY
 M.D. NAIMI UDDIN KHAN, P.E. #87776

4/12/04

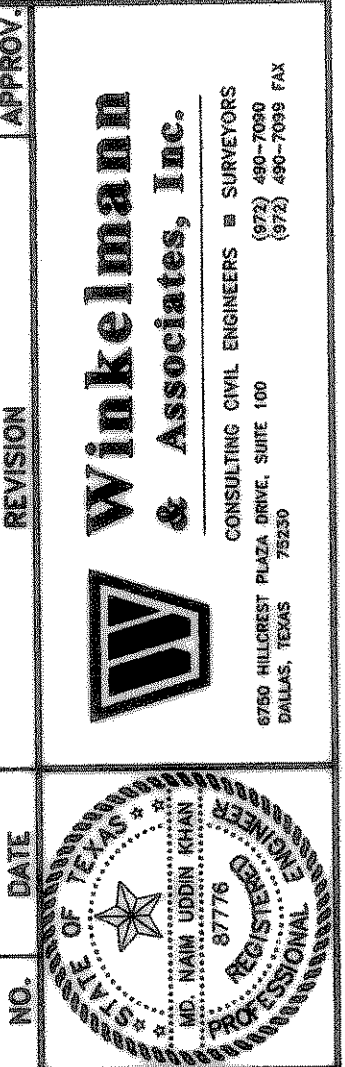

Winkelmann & Associates, Inc.
 CONSULTING CIVIL ENGINEERS - SURVEYORS
 5405 BELLEVUE BLVD., SUITE 100
 DALLAS, TEXAS 75240
 (972) 462-7000 FAX

STILLWATER CANYON, PHASE 1A
 MICHAEL JAMES SURVEY ABSTRACT NO. 710
 CITY OF DESOTO
 DALLAS COUNTY, TEXAS

LUMBERMEN'S INVESTMENT CORPORATION
 5495 BELLEVUE ROAD #225
 DALLAS, TEXAS 75240

CULVERT PROFILES & CALCULATIONS
 (PHASE 6 & PHASE 6A)

Scale: V. 1"=4' Date: 12/2/03
 Designed By: NK
 Drawn By: MS
 Checked By: NK
 File: 146546A/MCPR.dwg/rev: 1
 Project No.: 14654.01

SHEET
 33
 OF
 57