

BENCHMARK:
"X" CHISELED IN C OF ALLEY EAST OF MORNINGSTAR DRIVE WITHIN 3RD LOT NORTH OF MIDNIGHT PASS. ELEV. 513.26

BENCHMARK:
PK NAIL IN C OF CAROLYN LANE & ALLEY INTERSECTION 150'± EAST OF MORNINGSTAR DRIVE. ELEV. 491.68

Scale: 1" = 4'-0"
Date: 12/22/03



Designed By: RB
Drawn By: MS
Checked By: NK
File: 146546A.MSSP.DWG
Project No.: 14654.01

SANITARY SEWER PROFILES
LINE F - STA. 0+00 STA. 7+02.54
LINE C - STA. 20+00 STA. 23+34.31
LINE G1 - STA. 0+00 STA. 3+92.00

THE SEAL APPEARING ON THIS DOCUMENT WAS AUTHORIZED BY
 MD. NAIM UDDIN KHAN, # 87776

THESE CONSTRUCTION PLANS WERE PREPARED UNDER THE CLOSE PERSONAL SUPERVISION OF
 MD. NAIM UDDIN KHAN, REGISTERED PROFESSIONAL ENGINEER NO. 87776

M.B. Jones
 M.B. JONES SURVEY, ABSTRACT NO. 122
 CITY OF ROCKWALL
 ROCKWALL COUNTY, TEXAS
 LUMBERMEN'S INVESTMENT CORPORATION
 5495 BELTLINE ROAD #225
 DALLAS, TEXAS 75240

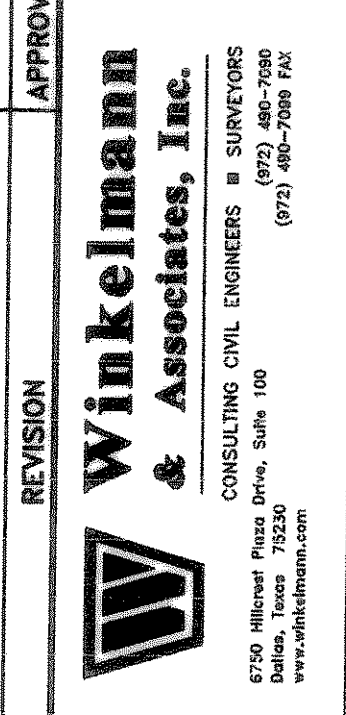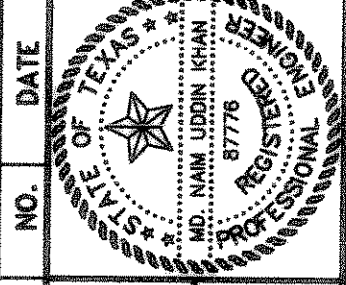

NO. DATE REVISION APPROV.

SHEET
 41
 OF
 57