

BENCHMARK:
 "X" CHISELED IN \odot OF ALLEY EAST OF MORNINGSTAR
 DRIVE WITHIN 3RD LOT NORTH OF MIDNIGHT PASS.
 ELEV. 513.26

THE SEAL, APPEARING ON THIS
 DOCUMENT WAS AUTHORIZED BY
 MD. NAIM UDDIN KHAN, # 87776


THESE CONSTRUCTION PLANS WERE PREPARED
 BY THE ENGINEER AND REGISTERED PROFESSIONAL
 ENGINEER NO. 87776
 MD. NAIM UDDIN KHAN

NO.	DATE	REVISION	APPROV.

Scale: 1" = 4'-0"
 Designed By: RB
 Drawn By: MS
 Checked By: NK
 Title: 146546ANSPP.DWG
 Project No.: 14654.01

SANITARY SEWER PROFILES
LINE D - STA. 0+00 STA. 10+49.03
LINE H1 - STA. 0+00 STA. 2+06.15

M.B. JONES SURVEY, ABSTRACT NO. 122
 CITY OF ROCKWALL,
 ROCKWALL COUNTY, TEXAS
 LUMBERMEN'S INVESTMENT CORPORATION
 5495 BELTLINE ROAD #225
 DALLAS, TEXAS 75240

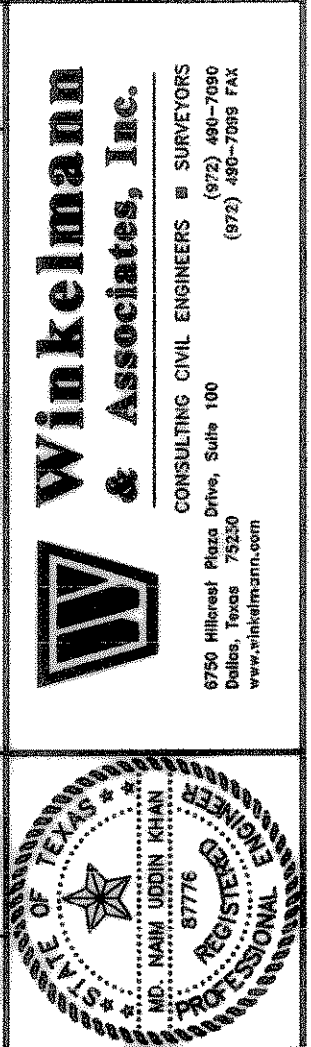

Winkelman & Associates, Inc.
 CONSULTING CIVIL ENGINEERS & SURVEYORS
 6750 Walnut Plaza Drive, Suite 100
 Dallas, Texas 75248
 (972) 482-7262
 (972) 482-7299 FAX