


**AS-BUILT DRAWINGS:**  
 TO THE BEST OF JBI PARTNERS, INC.'S KNOWLEDGE, JBI HEREBY STATES THAT THIS PLAN IS AS-BUILT. THE INFORMATION PROVIDED IS BASED ON CONSTRUCTION STAKING AND PAD VERIFICATION AT THE SITE AND INFORMATION PROVIDED BY THE CONTRACTOR.

Daniel Dewey 4/11/2014  
 Name Date

| NO. | REVISIONS DURING CONSTRUCTION | BY | DATE | NO. | REVISIONS DURING PLAN REVIEW           | BY  | DATE   |
|-----|-------------------------------|----|------|-----|----------------------------------------|-----|--------|
|     |                               |    |      | 1   | PER CITY COMMENTS & REVISED TRAIL RAMP | CBM | 5/7/12 |

DESIGNED BY:  
 JBI  
 DRAWN BY:  
 JBI  
 CHECKED BY:  
 CBM

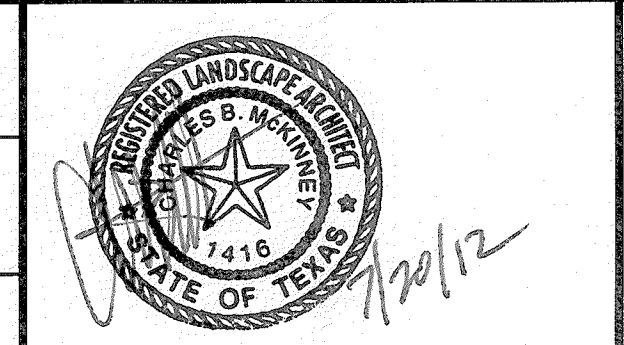

16301 Quorum Drive  
 Suite 200 B  
 Addison, Texas 75240  
 Main 972.248.7676  
 Fax 972.248.1414  
 www.jbipartners.com

**OVERALL PLAN**  
**PHASE 7B AND PHASE 8A**  
**CARUTH LAKES**  
**CITY OF ROCKWALL, TEXAS**

PROJECT NO.  
**HOE132**  
 SHEET NO.  
**L1**