



1 PHASE 7B OVERALL SCREENING PLAN

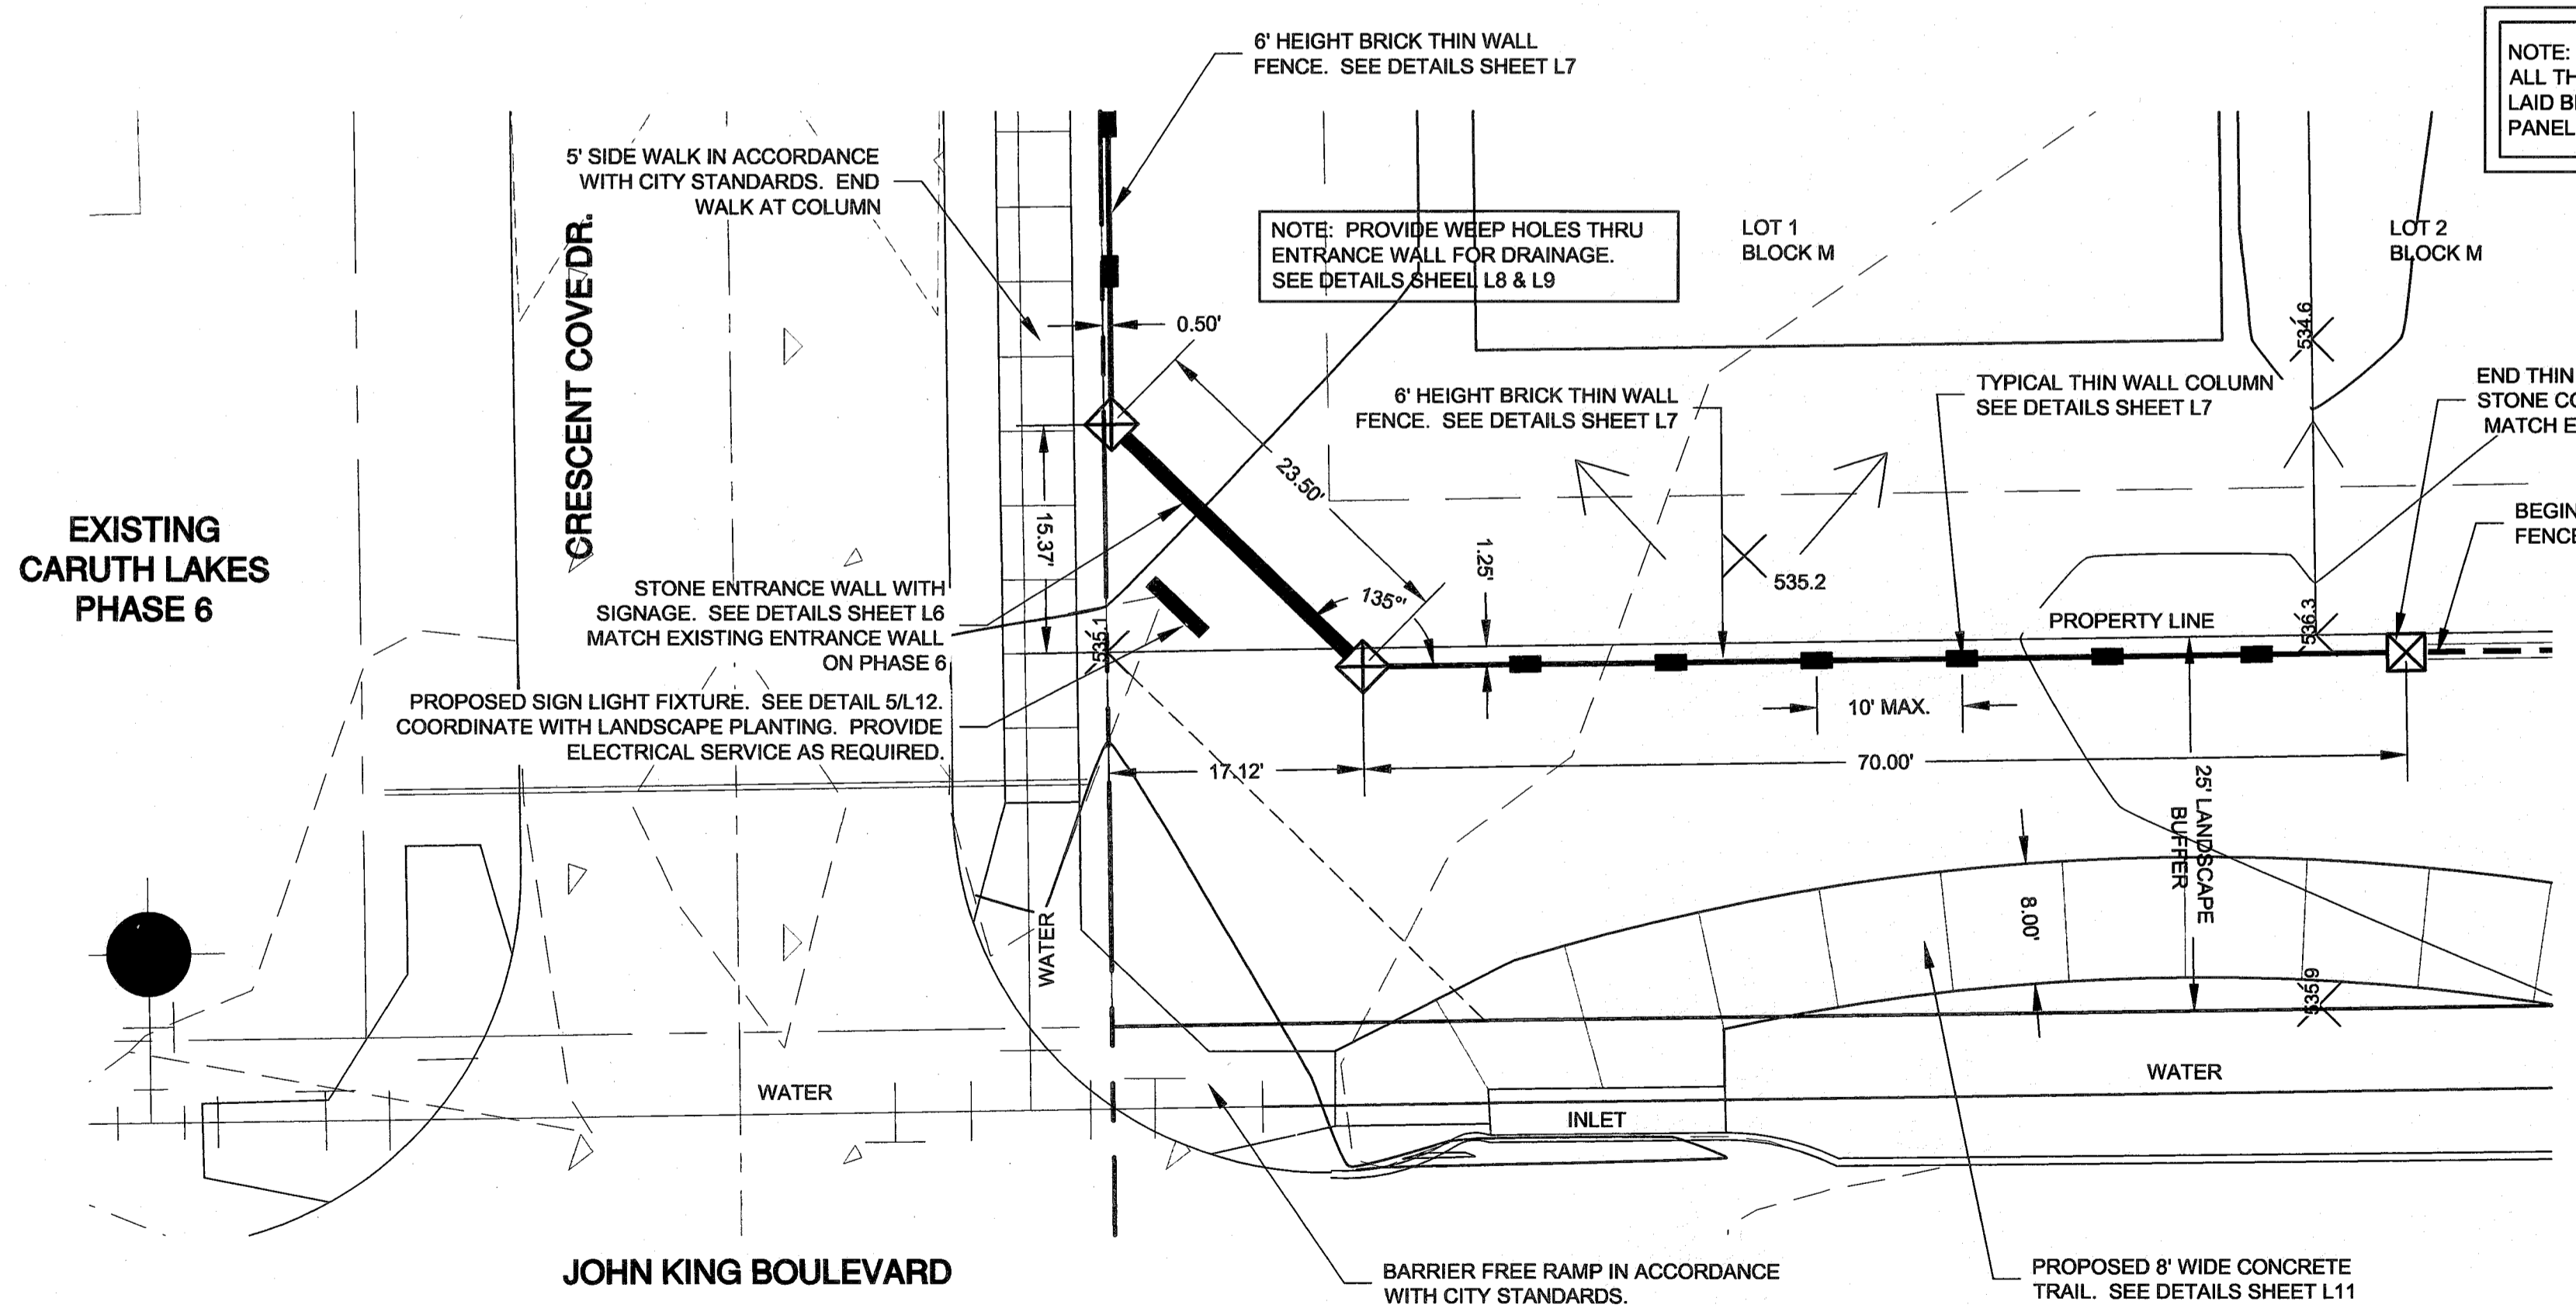

2 ENLARGED PLAN - PHASE 7B ENTRANCE AREA

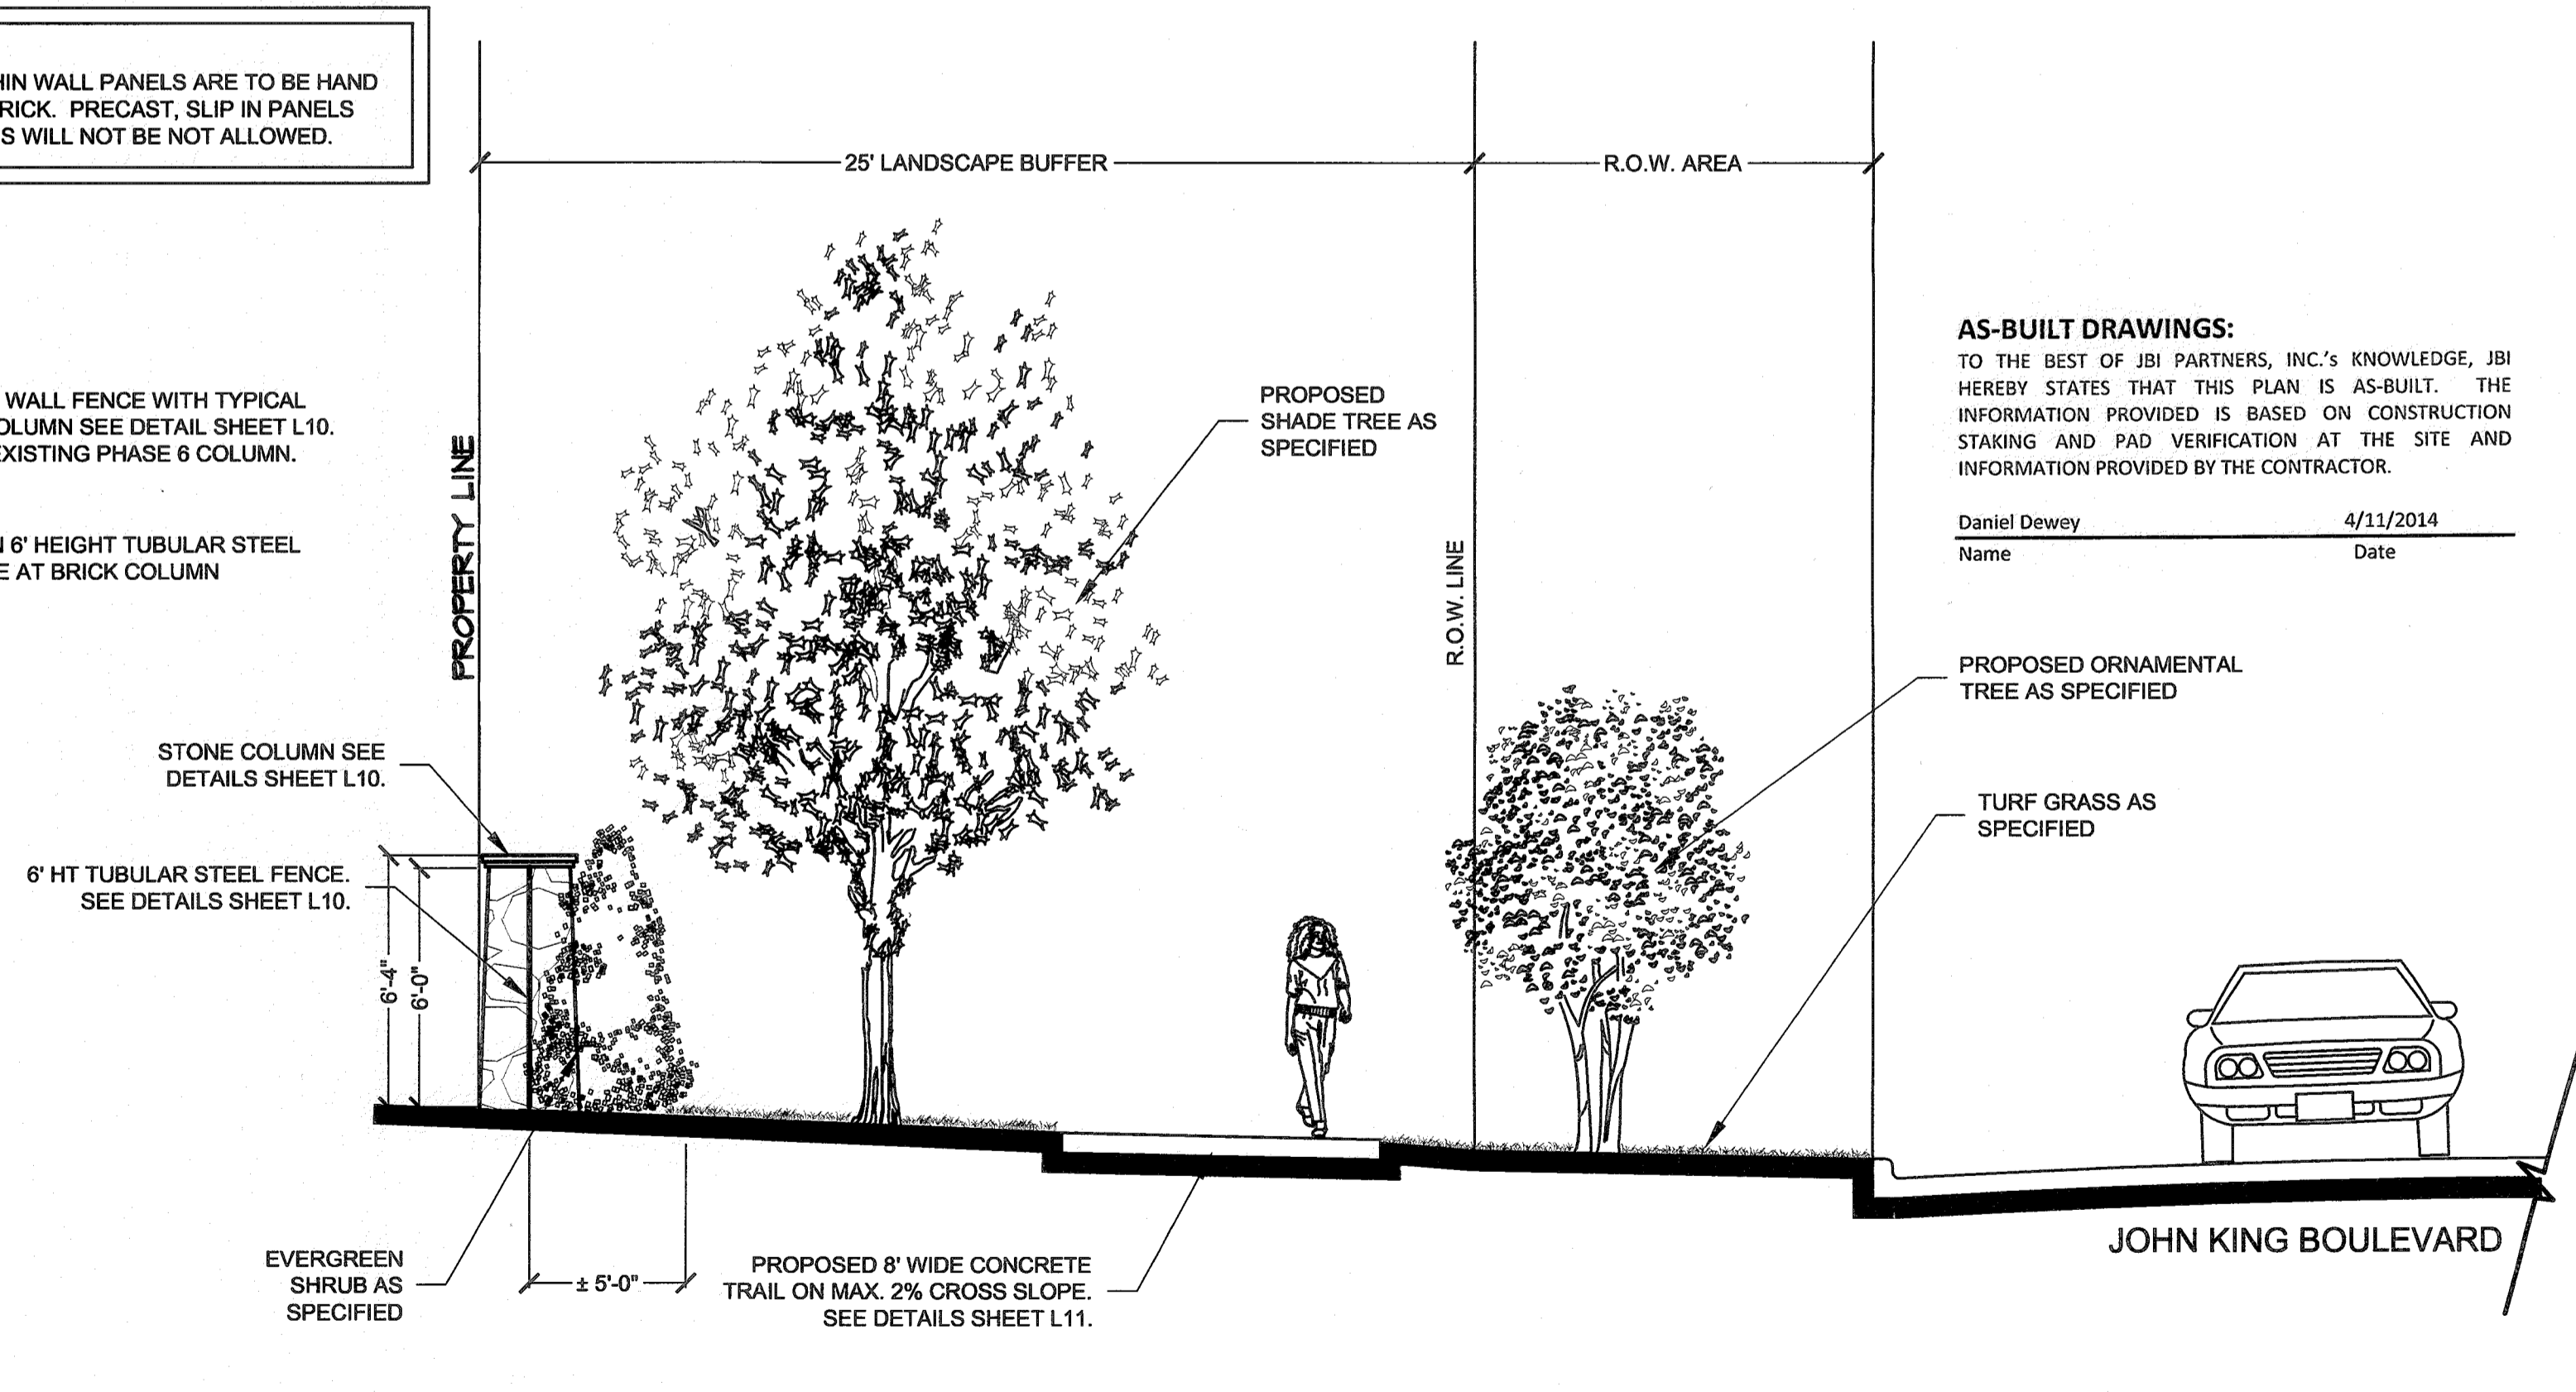

3 SECTION A-A SCREENING ALONG LANDSCAPE BUFFER

NO.	REVISIONS DURING CONSTRUCTION	BY	DATE	NO.	REVISIONS DURING PLAN REVIEW	BY	DATE

DESIGNED BY: JBI			16301 Quorum Drive Suite 200 B Addison, Texas 75240 Main 972.248.7676 Fax 972.248.1414 www.jbipartners.com	PROJECT NO.
DRAWN BY: JBI				HOE132
CHECKED BY: CBM				SHEET NO.
				L2

SCREENING PLAN
PHASE 7B
CARUTH LAKES
CITY OF ROCKWALL, TEXAS