


**1 ENTRY WALL WITH - PHASE 8A SOUTH SIDE OF PHELPS LAKE DRIVE ENTRANCE ELEVATION**

SCALE: 1/2" = 1'-0"

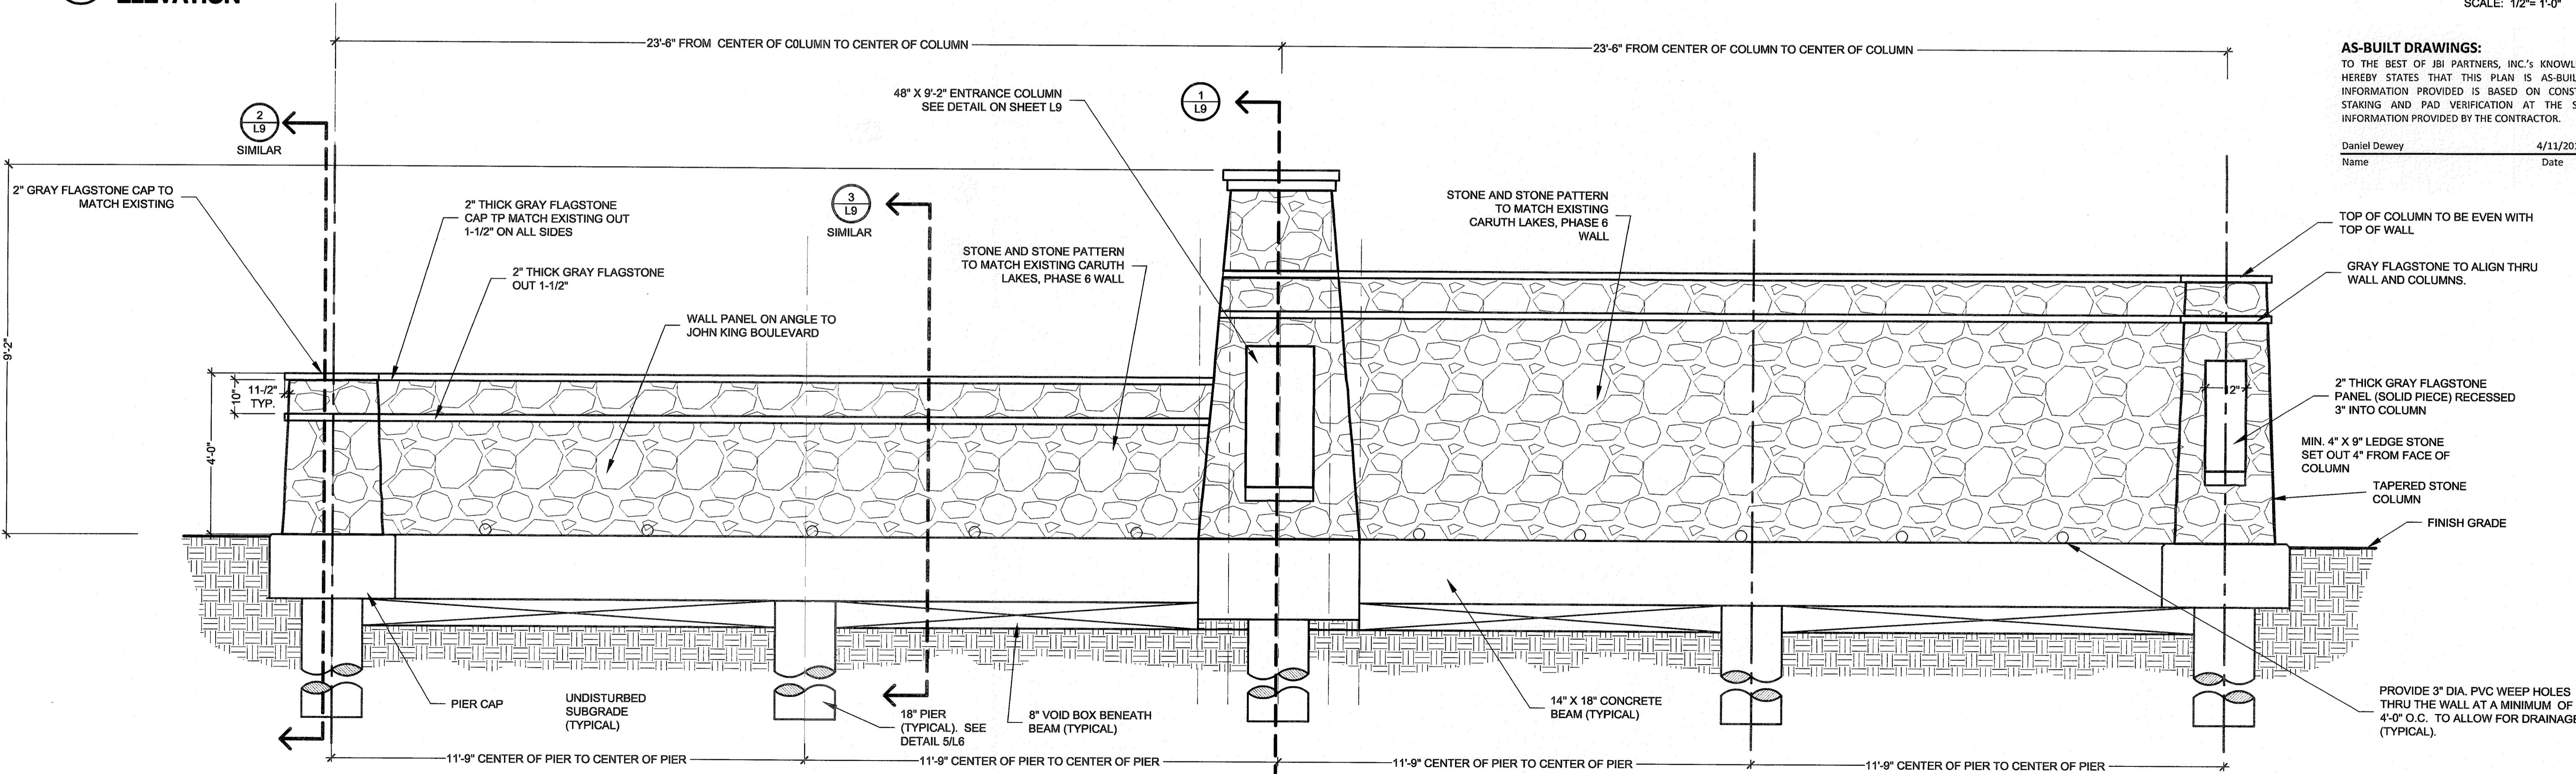

**2 ENTRY WALL WITH - PHASE 8A NORTH SIDE ELEVATION**

SCALE: 1/2" = 1'-0"

**AS-BUILT DRAWINGS:**  
 TO THE BEST OF JBI PARTNERS, INC.'S KNOWLEDGE, JBI HEREBY STATES THAT THIS PLAN IS AS-BUILT. THE INFORMATION PROVIDED IS BASED ON CONSTRUCTION STAKING AND PAD VERIFICATION AT THE SITE AND INFORMATION PROVIDED BY THE CONTRACTOR.  
 Daniel Dewey 4/11/2014  
 Name Date

NO.	REVISIONS DURING CONSTRUCTION	BY	DATE	NO.	REVISIONS DURING PLAN REVIEW	BY	DATE
1	PER CITY COMMENTS & REVISED TRAIL RAMP	CBM	5/7/12				

DESIGNED BY: JBI  
 DRAWN BY: JBI  
 CHECKED BY: CBM

16301 Quorum Drive  
 Suite 200 B  
 Addison, Texas 75240  
 Main 972.248.7876  
 Fax 972.248.1414  
 www.jbipartners.com

**ENTRANCE WALL ELEVATIONS**  
**PHASE 8A**  
**CARUTH LAKES**  
**CITY OF ROCKWALL, TEXAS**

PROJECT NO. HOE132  
 SHEET NO. L8