

BENCHMARKS


- X-chiseled in CL of Alley East of Morningstar Drive within the third lot north of Midnight Pass. Elevation = 513.26
- PK Nail in CL of Canuth Lane & Alley intersection 150 feet +/- east of Morningstar Drive. Elevation = 491.68

NO.	REVISIONS DURING CONSTRUCTION	BY	DATE	NO.	SUBMITTALS	DATE

The seal appearing on this document was authorized by DANIEL DEWEY, P.E. 93961. Alteration of a sealed document without proper notification to the responsible engineer is an offense under the Texas Engineering Practice Act.

DANIEL DEWEY
 93961
 LICENSED PROFESSIONAL ENGINEER

5-17-B

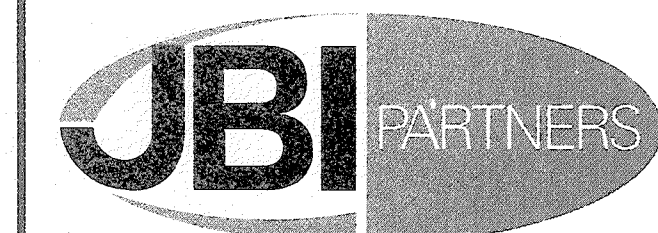

16301 Quorum Drive
 Suite 200 B
 Addison, Texas 75001
 Main 972.248.7676
 Fax 972.248.1414
 www.jbipartners.com

PAVING PLAN & PROFILE

ALLEY 3 & ALLEY 4
Caruth Lakes Phase 8A
City of Rockwall, Texas

PROJECT NO.	HOE132
SHEET NO.	13

Drawing: H:\Projects\HOE132-8A\PAVING\PAVING PLAN & PROFILE.dwg Saved By: cwall Date: 5/13/2013 3:18 PM
 Printed by: cwall Plot Date: 5/16/2013 12:52 PM