

PERIMETER SCREENING AND LANDSCAPE CONSTRUCTION PLANS FOR CARUTH LAKES PHASES 7B AND 8A CITY OF ROCKWALL ROCKWALL COUNTY, TEXAS

A. NORTH TEXAS MUNICIPAL WATER DISTRICT (NTMWD) 30-INCH WATER TRANSMISSION PIPELINE IS LOCATED WITHIN LIMITS OF CONSTRUCTION.

B. OPERATION OF HEAVY EARTHMOVING EQUIPMENT, COMPACTION EQUIPMENT OR HEAVY CONSTRUCTION EQUIPMENT, SUCH AS CONCRETE TRUCKS, SHALL BE RESTRICTED TO SPECIFIC CROSSING POINTS ACROSS NTMWD EASEMENTS, AS APPROVED BY THE NTMWD. THE CROSSINGS SHALL BE DESIGNATED AND VERIFIED TO PROVIDE A MINIMUM OF FIVE-FEET OF COVER.

C. TO ASSURE THAT PLACING OF SIGNIFICANT LOADS OVER THE NTMWD PIPELINE DOES NOT DAMAGE THE EXISTING PIPELINE, NO MATERIALS SHALL BE STOCKPILED ON THE NTMWD EASEMENT, WITHOUT AUTHORIZATION FROM THE NTMWD. IF THE CONTRACTOR DESIRES TO USE THE NTMWD'S EASEMENT FOR STOCKPILE OF MATERIALS, CONTACT NTMWD ENGINEERING AT (972) 442-5405 SO YOUR PLANS FOR USE OF NTMWD'S EASEMENT CAN BE REVIEWED.

D. A MINIMUM OF THREE FEET SEPARATION BETWEEN THE BOTTOM OF THE PAVEMENT AND TOP OF NTMWD PIPELINE IS REQUIRED. IN ADDITION, IF SEPARATION BETWEEN THE BOTTOM OF THE PAVEMENT AND THE TOP OF THE PIPELINE IS LESS THAN 3.5 FEET, A THICKENED PAVEMENT SECTION IS REQUIRED.

E. CROSSING OF THE NTMWD EASEMENT WITH OTHER UTILITIES, SUCH AS TV CABLE, PHONE, GAS AND ELECTRIC, SHALL BE COORDINATED WITH THE NTMWD TO AVOID DAMAGE TO THE NTMWD FACILITIES.


F. OUTDOOR LIGHTING, LANDSCAPING, SCREENING WALLS OR OTHER FACILITIES SHALL NOT BE INSTALLED IN NTMWD EASEMENTS WITHOUT WRITTEN APPROVAL OF THE NTMWD.

G. UNLESS OTHERWISE SHOWN OR REQUIRED A MINIMUM OF ONE-FOOT CLEARANCE SHALL BE PROVIDED FOR ALL UTILITIES CROSSING THE NTMWD PIPELINES.

H. "THE CONTRACTOR SHALL CONTACT NTMWD ENGINEERING AT (972) 442-5405 AT LEAST 48 HOURS PRIOR TO PERFORMING ANY WORK IN THE VICINITY OF THE NTMWD FACILITIES."

ALL CONTRACTORS TO USE STANDARD DETAILS PER CITY OF ROCKWALL AND NCTCOG THIRD EDITION.

Note:
To Contractor(s) The contractor(s) is (are) to provide "red lined" mark-ups of these plans to the engineer for any field changes made during construction after the project is complete. These mark-ups will be used to prepare "Construction Record Drawings".

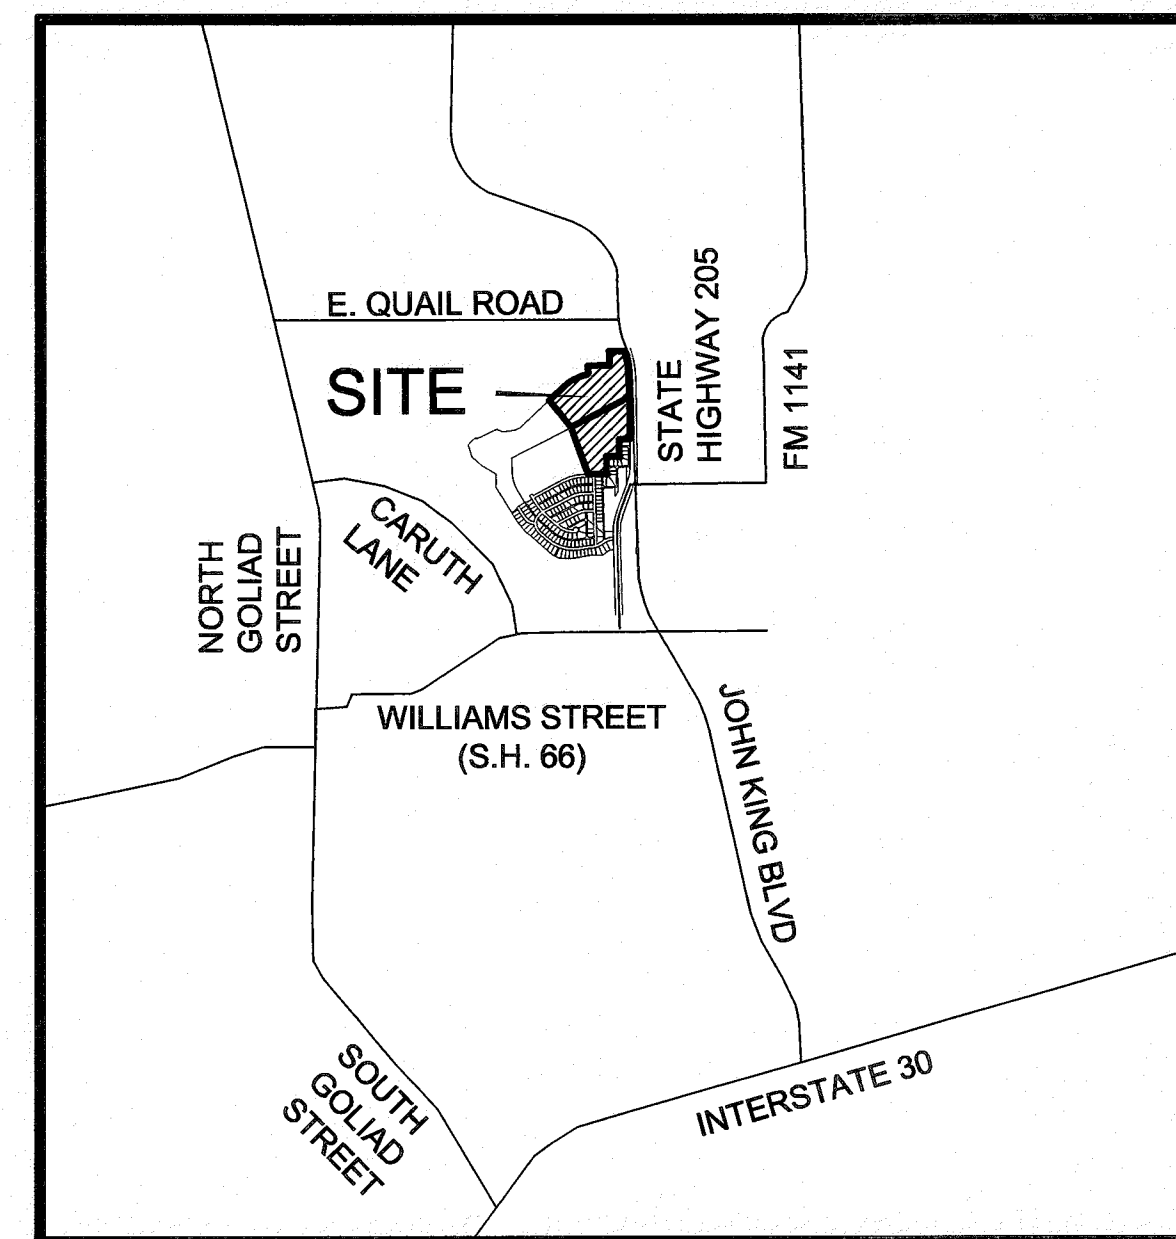

LOCATION MAP
MAPSCO PAGE 20C-D
ROCKWALL, TEXAS
N.T.S

INDEX

SHEET NO.	DESCRIPTION
L1	OVERALL PLAN - PHASES 7B & 8A
L2	SCREENING PLAN - PHASE 7B
L3	SCREENING PLAN - PHASE 8A
L4	LANDSCAPE PLANTING PLAN - PHASE 7B
L5	LANDSCAPE PLANTING PLAN - PHASE 8A
L6	ENTRANCE WALL ELEVATION AND DETAILS - PHASE 7B
L7	BRICK THIN WALL DETAILS - PHASE 7B
L8	ENTRANCE WALL ELEVATIONS - PHASE 8A
L9	ENTRANCE WALL DETAILS - PHASE 8A
L10	STONE COLUMN AND TUBULAR STEEL FENCE - PHASES 7B & 8A
L11	MISCELLANEOUS DETAILS - TRAIL - PHASES 7B & 8A
L12	LANDSCAPE PLANTING DETAILS - PHASES 7B & 8A

OWNER \ DEVELOPER
D.R. HORTON - TEXAS, LTD.
4306 MILLER ROAD, SUITE A
ROWLETT, TEXAS 75088
(214) 607-4244

ENGINEER - SURVEYOR - LANDSCAPE ARCHITECT



16301 Quorum Drive
Suite 200 B
Addison, Texas 75240
Main 972.248.7676
Fax 972.248.1414
www.jbipartners.com
TEXAS REGISTERED ENGINEERING FIRM F-438

AS-BUILT DRAWINGS:

TO THE BEST OF JBI PARTNERS, INC.'S KNOWLEDGE, JBI HEREBY STATES THAT THIS PLAN IS AS-BUILT. THE INFORMATION PROVIDED IS BASED ON CONSTRUCTION STAKING AND PAD VERIFICATION AT THE SITE AND INFORMATION PROVIDED BY THE CONTRACTOR.

Daniel Dewey 4/11/2014
Name Date



JBI PROJECT # HOE132

CARUTH LAKES PHASE 7B & 8A PERIMETER SCREENING AND LANDSCAPE

JBI PARTNERS