


1 PHASE 8A OVERALL SCREENING PLAN
L3

SCALE: 1" = 30'-0"

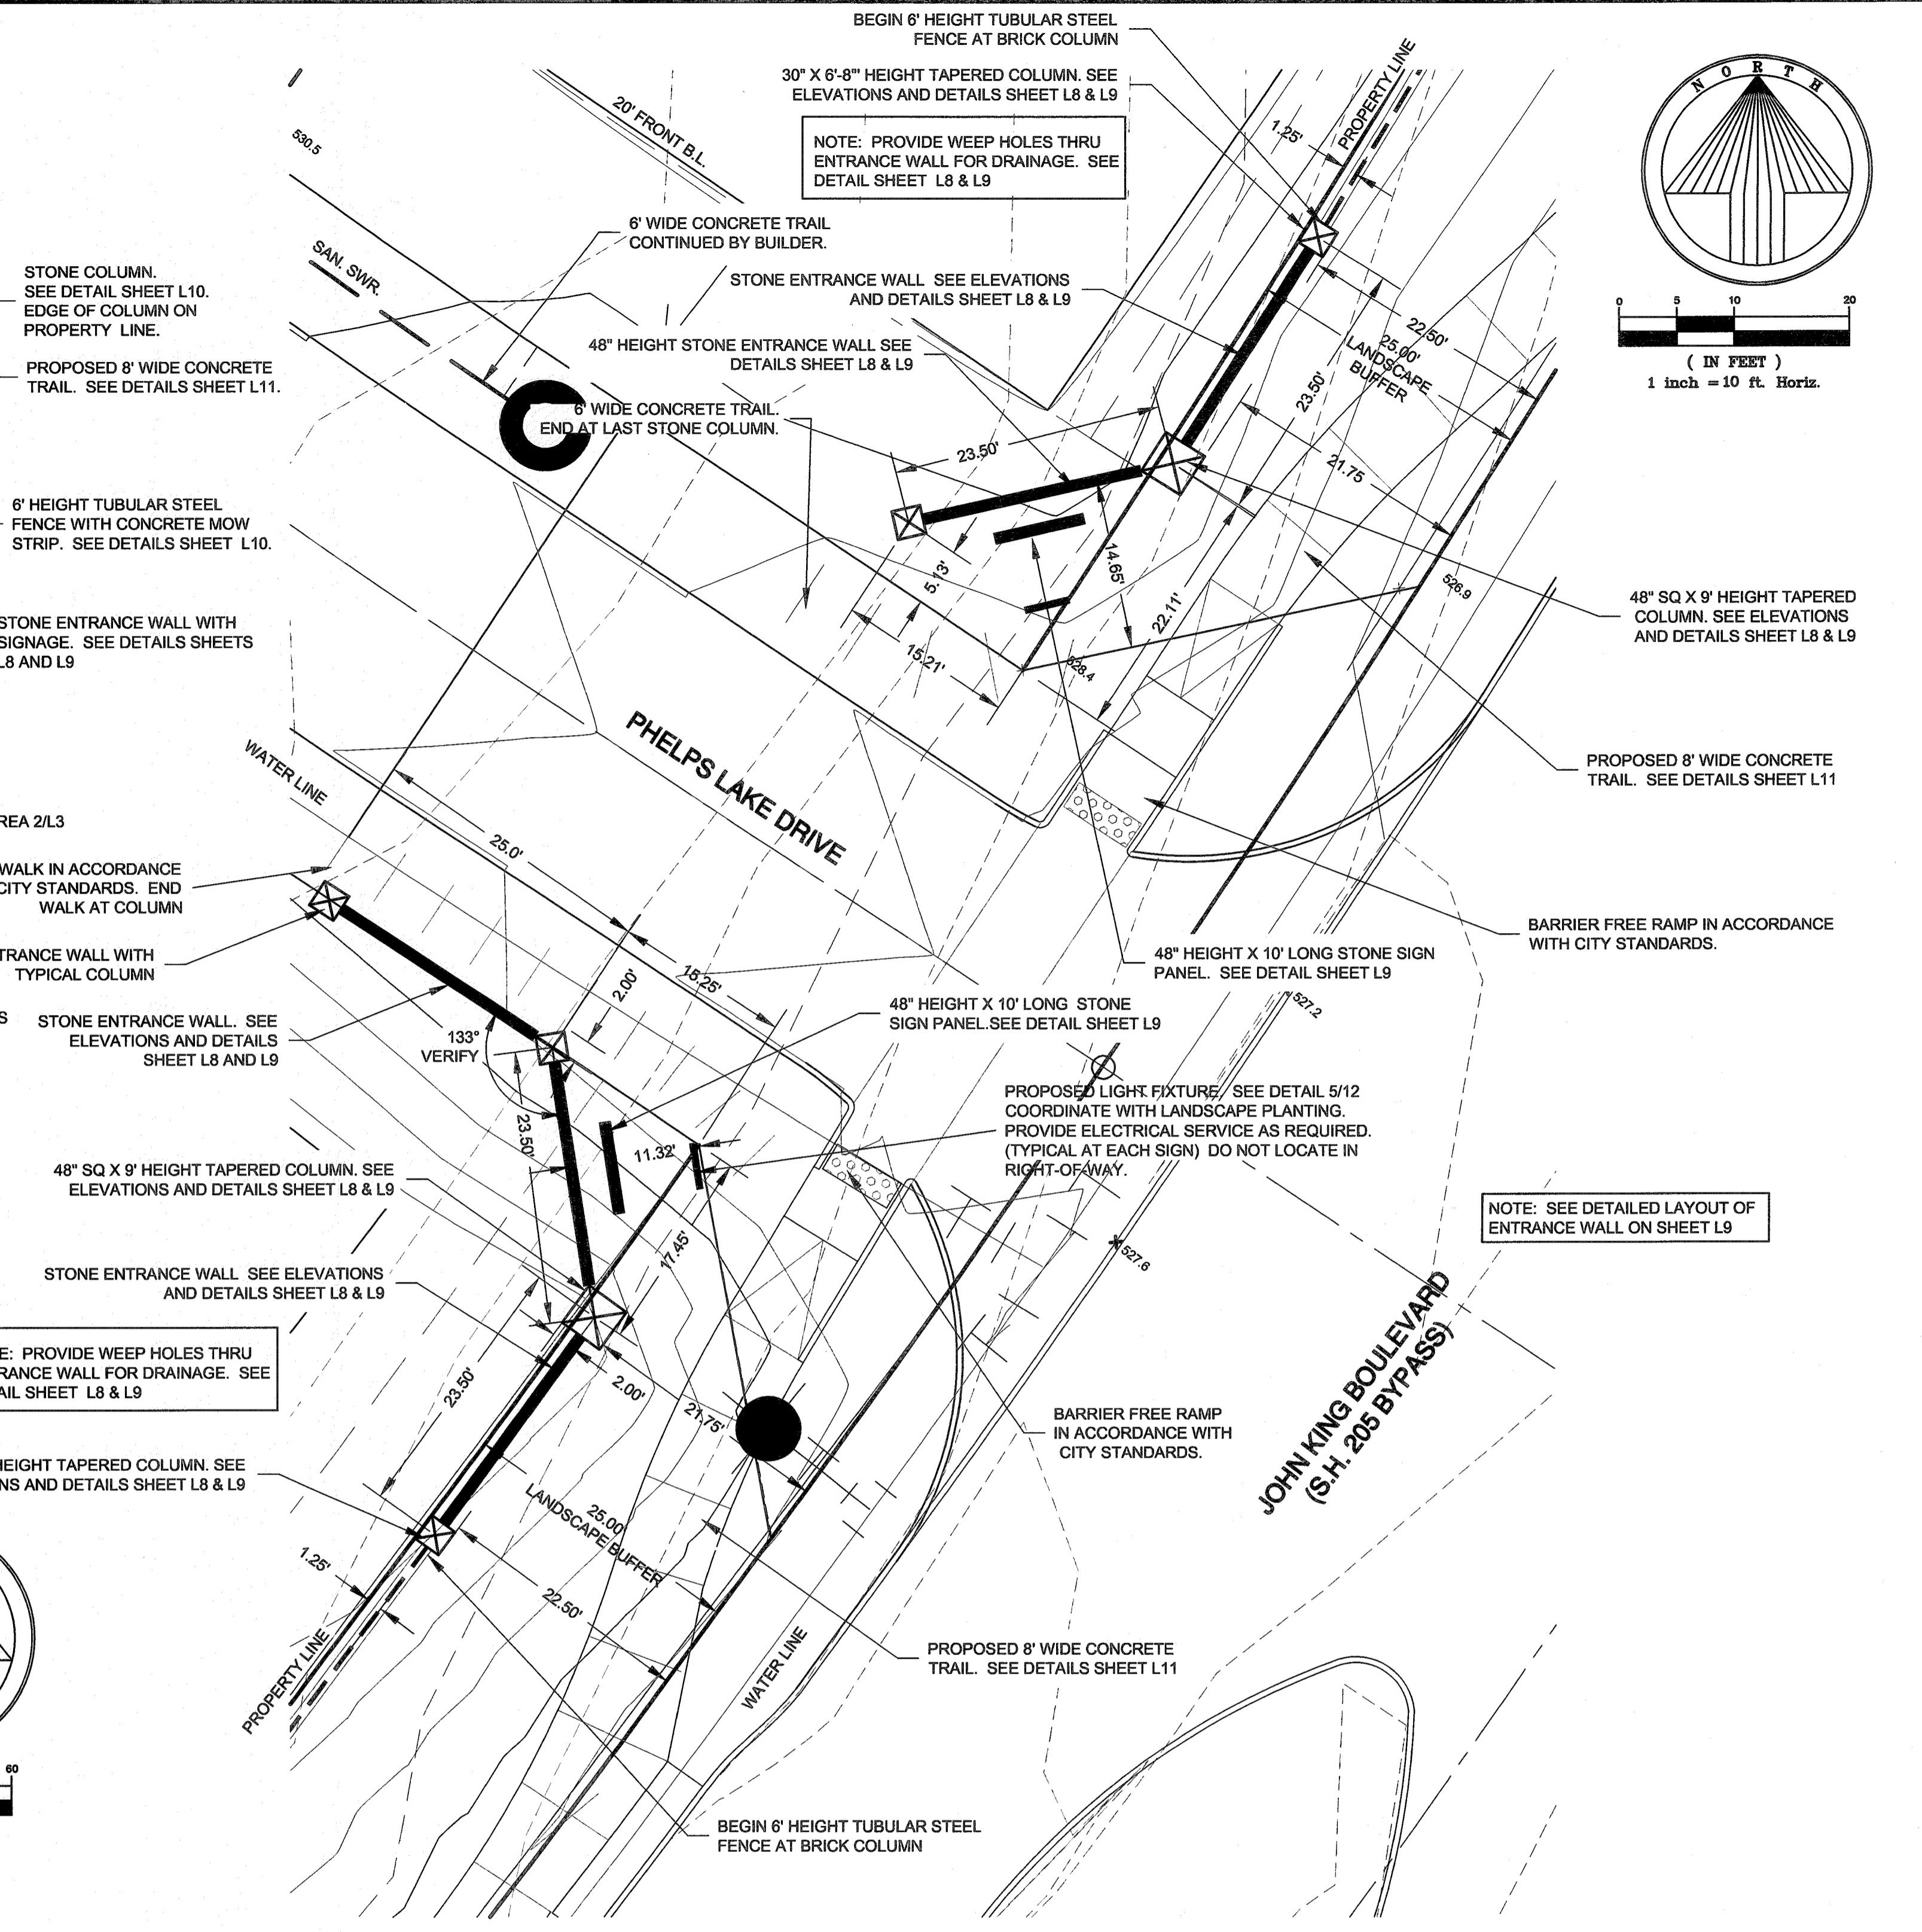

2 ENLARGED PLAN - PHASE 8A ENTRANCE AREA
L3


SCALE: 1" = 10'-0"

AS-BUILT DRAWINGS:
TO THE BEST OF JBI PARTNERS, INC.'S KNOWLEDGE, JBI HEREBY STATES THAT THIS PLAN IS AS-BUILT. THE INFORMATION PROVIDED IS BASED ON CONSTRUCTION STAKING AND PAD VERIFICATION AT THE SITE AND INFORMATION PROVIDED BY THE CONTRACTOR.

Daniel Dewey 4/11/2014
Name Date

NO.	REVISIONS DURING CONSTRUCTION	BY	DATE	NO.	REVISIONS DURING PLAN REVIEW	BY	DATE
				1	PER CITY COMMENTS & REVISED TRAIL RAMP	CBM	5/7/12

DESIGNED BY:
JBI
DRAWN BY:
JBI
CHECKED BY:
CBM

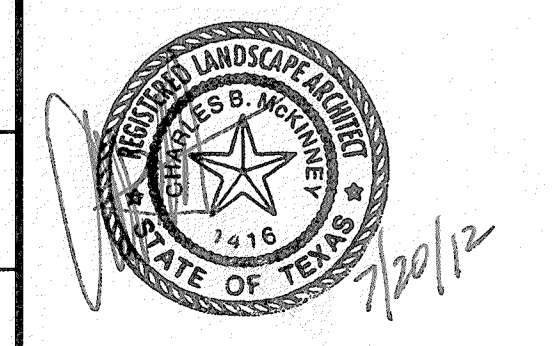

16301 Quorum Drive
Suite 200 B
Addicks, Texas 75240
Main 972.248.7676
Fax 972.248.1414
www.jbipartners.com

SCREENING PLAN		PROJECT NO.
PHASE 8A		HOE132
CARUTH LAKES		SHEET NO.
CITY OF ROCKWALL, TEXAS		L3