




**1 9' STONE COLUMN AT PHASE 8A ENTRANCE WALLS**  
 SECTION  
 SCALE: 3/4" = 1'-0"

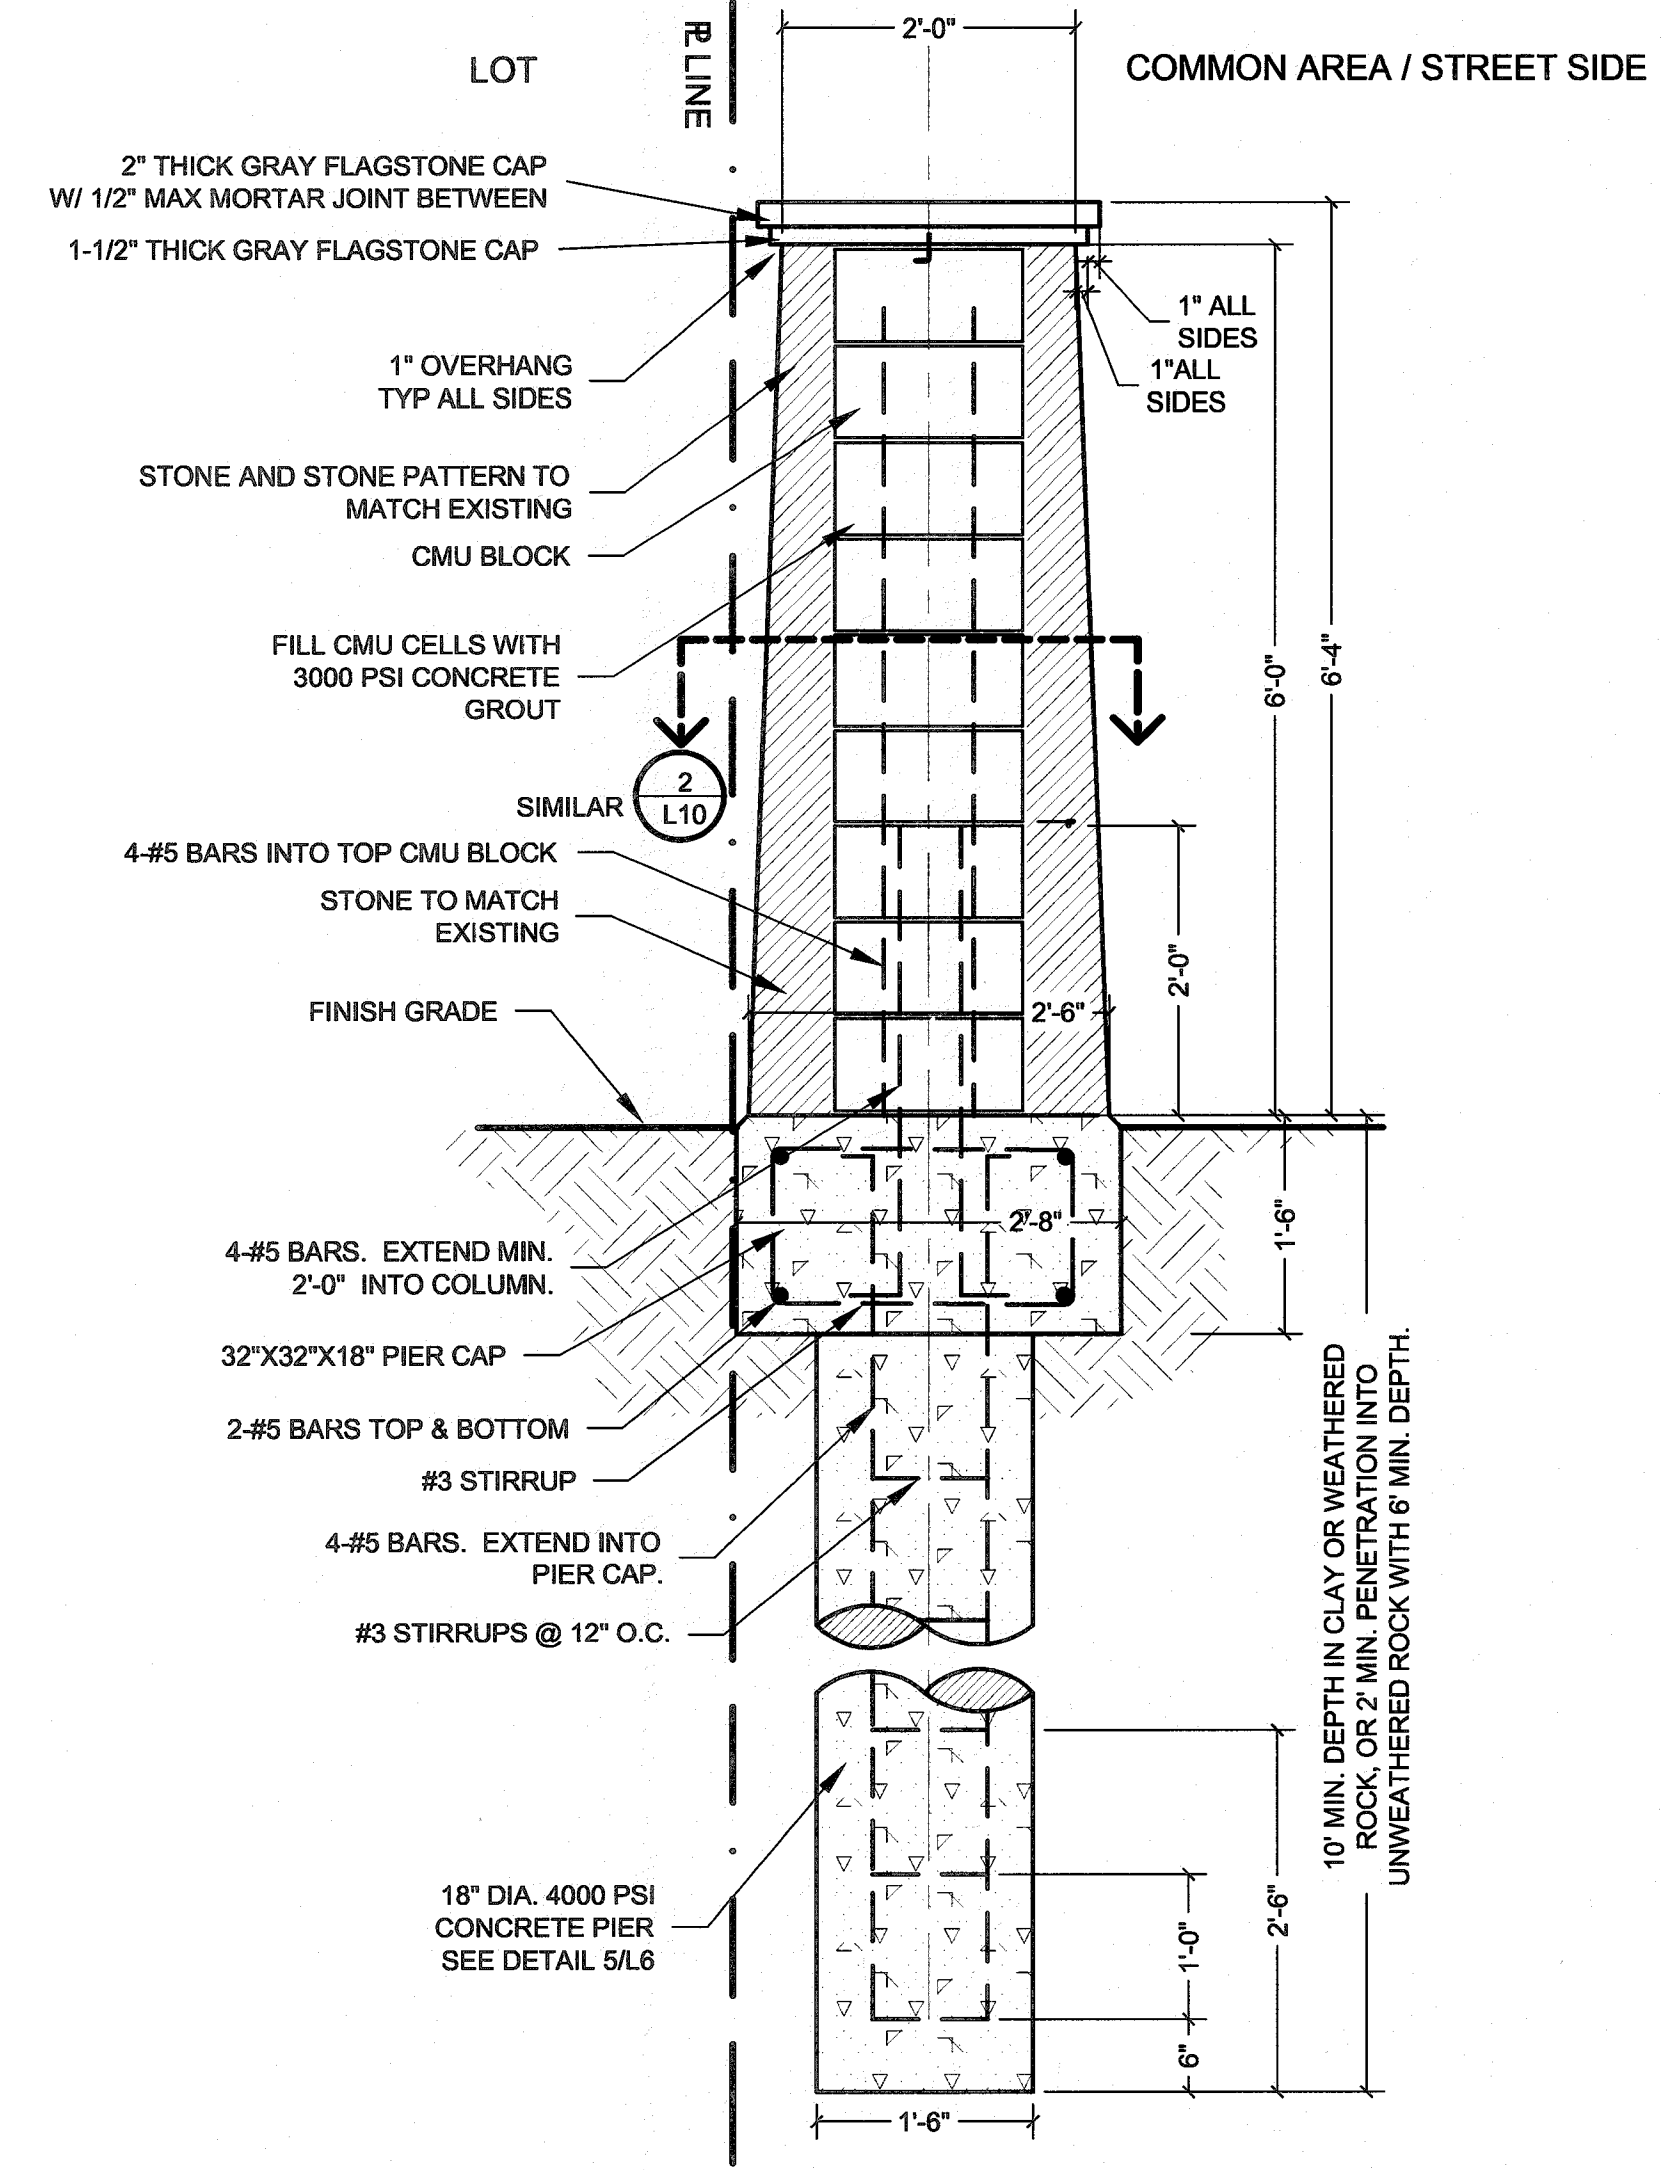


**2 MASONRY COLUMN**  
 SECTION  
 SCALE: 3/4" = 1'-0"

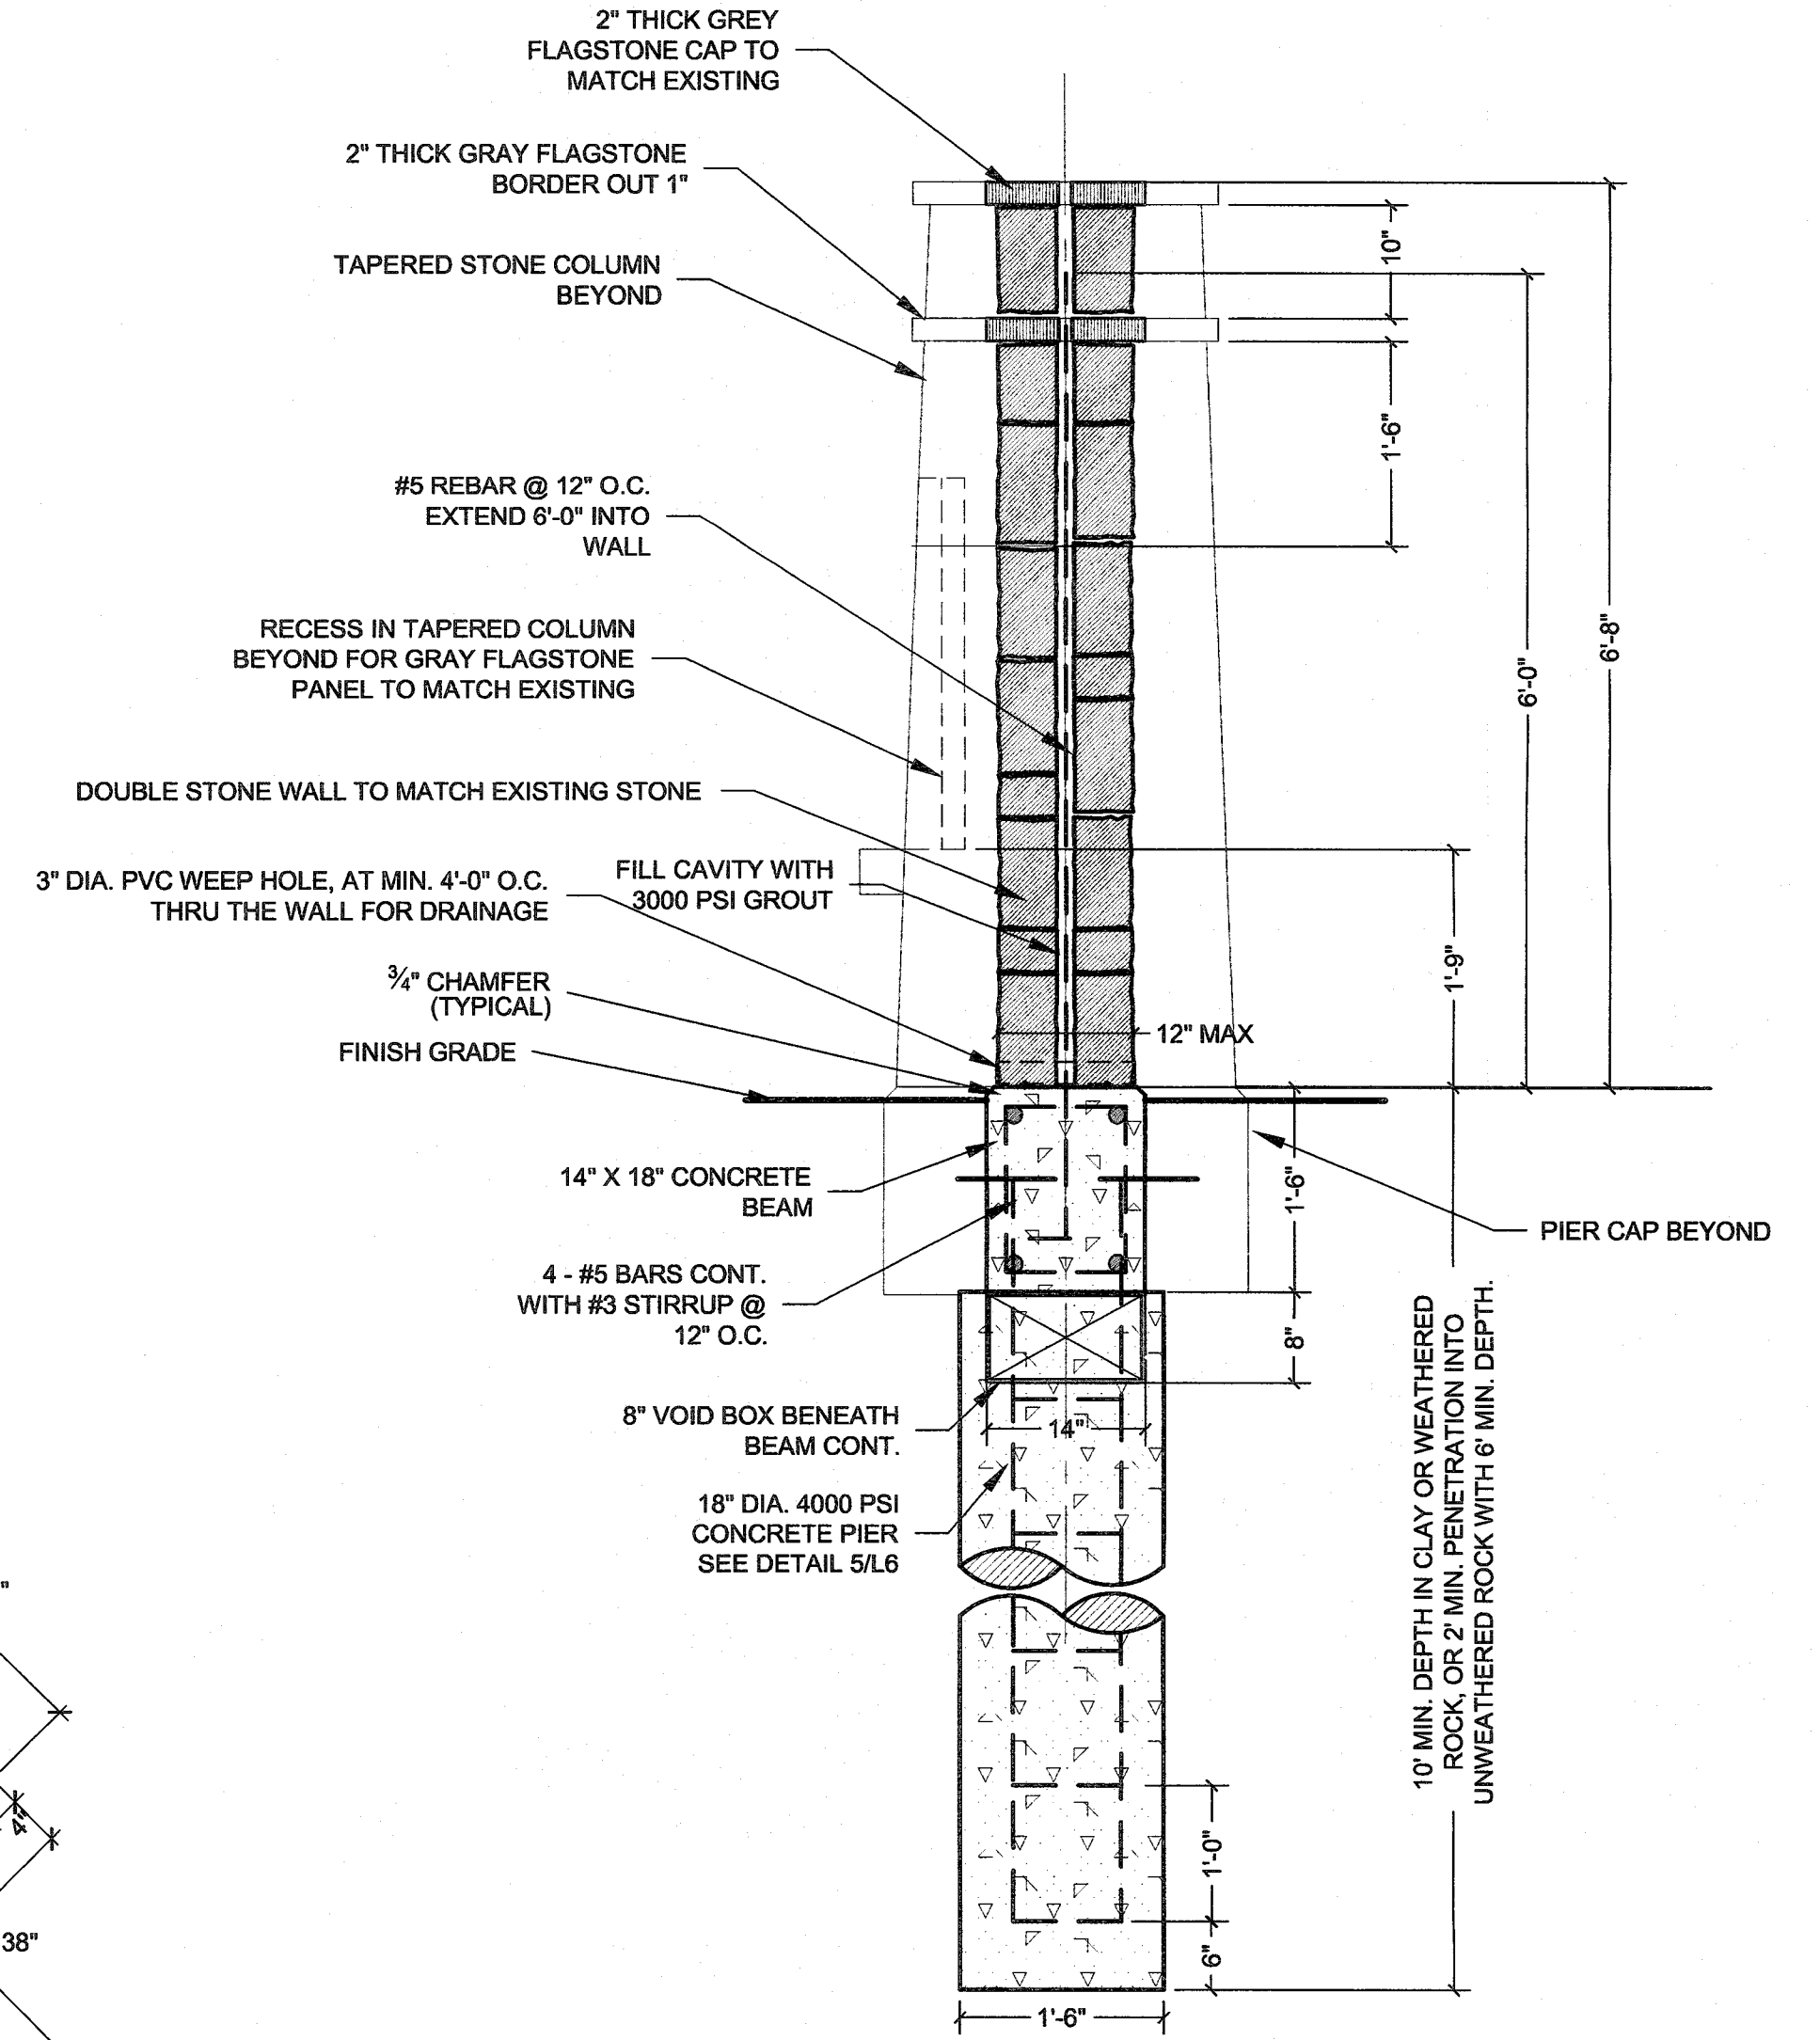

**3 PHASE 8A STONE ENTRANCE WALL**  
 SECTION  
 SCALE: 3/4" = 1'-0"

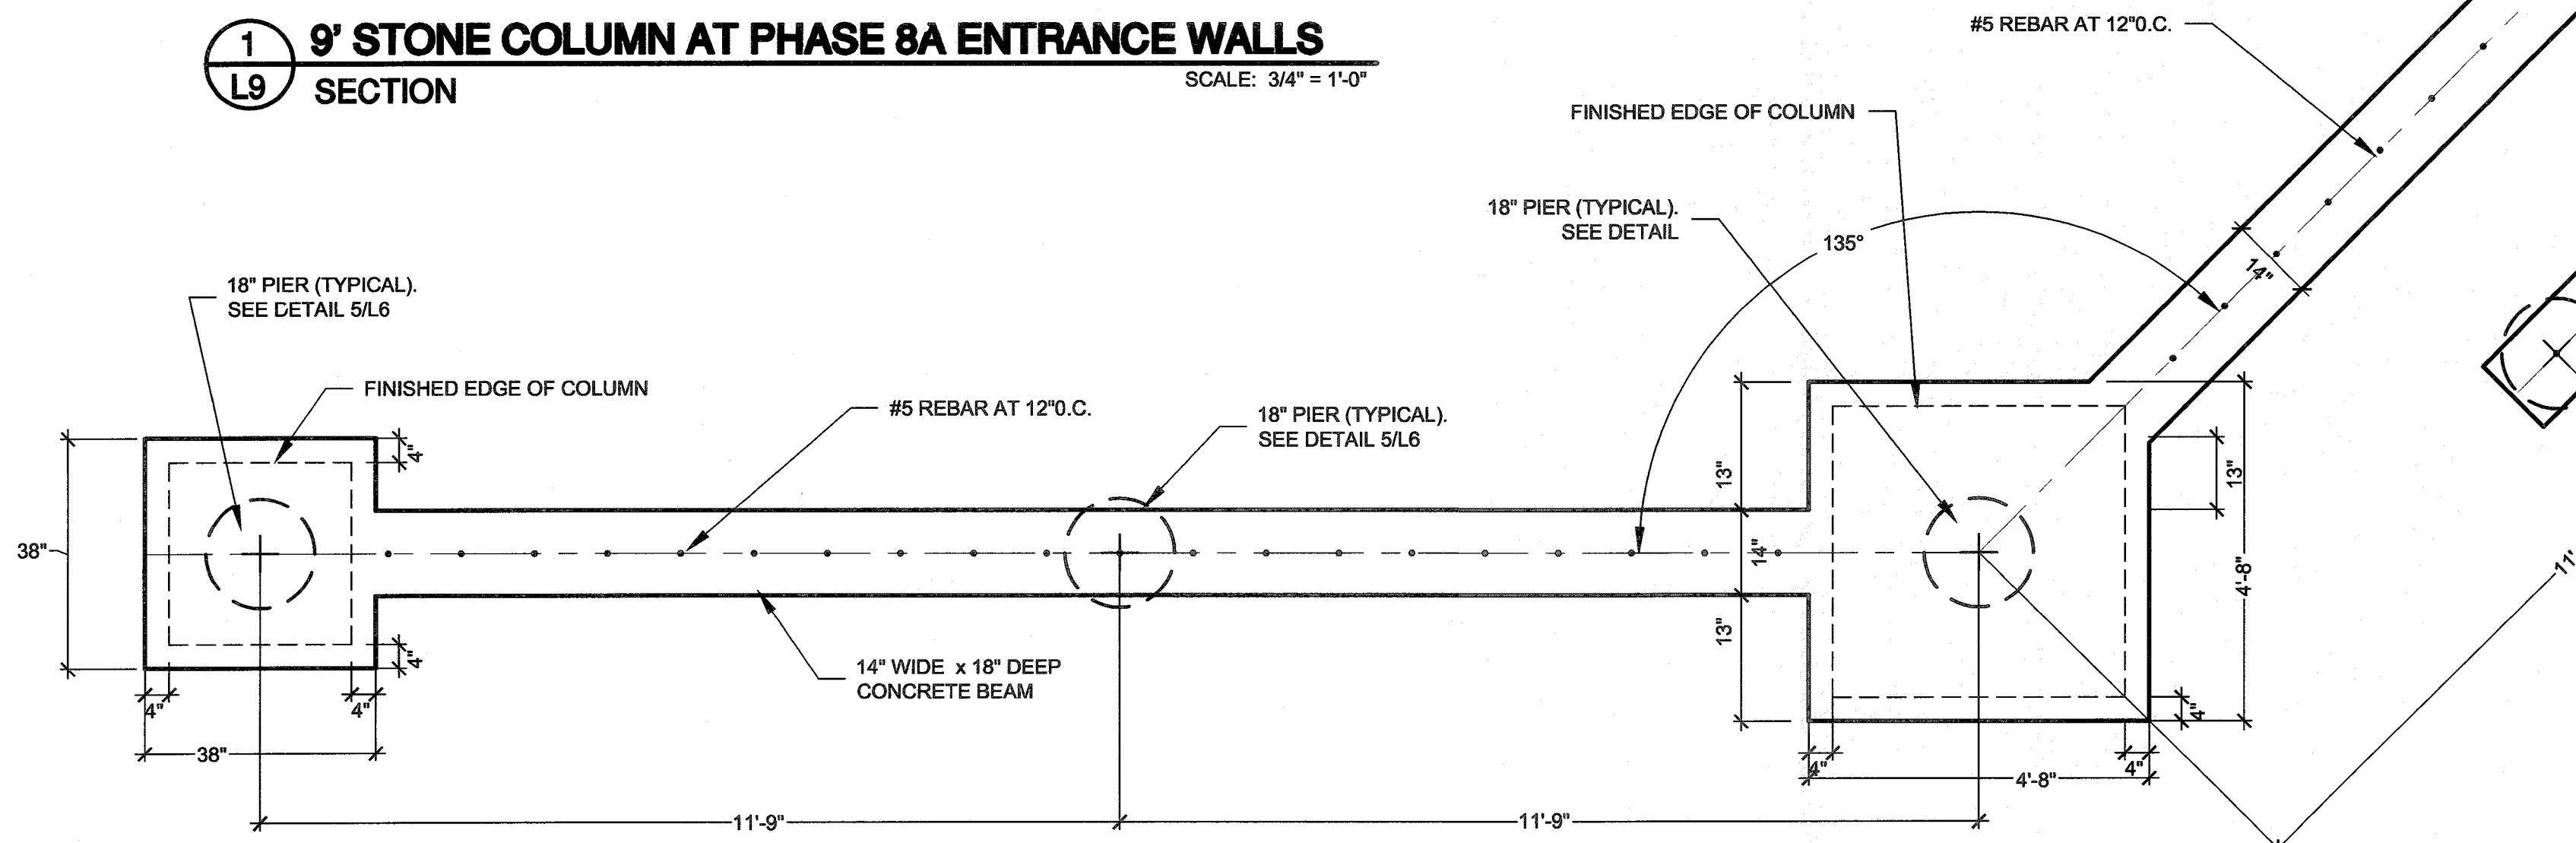

**4 ENTRY WALL WITH PLAN PHASE 8A**  
 PLAN  
 SCALE: 1/2" = 1'-0"

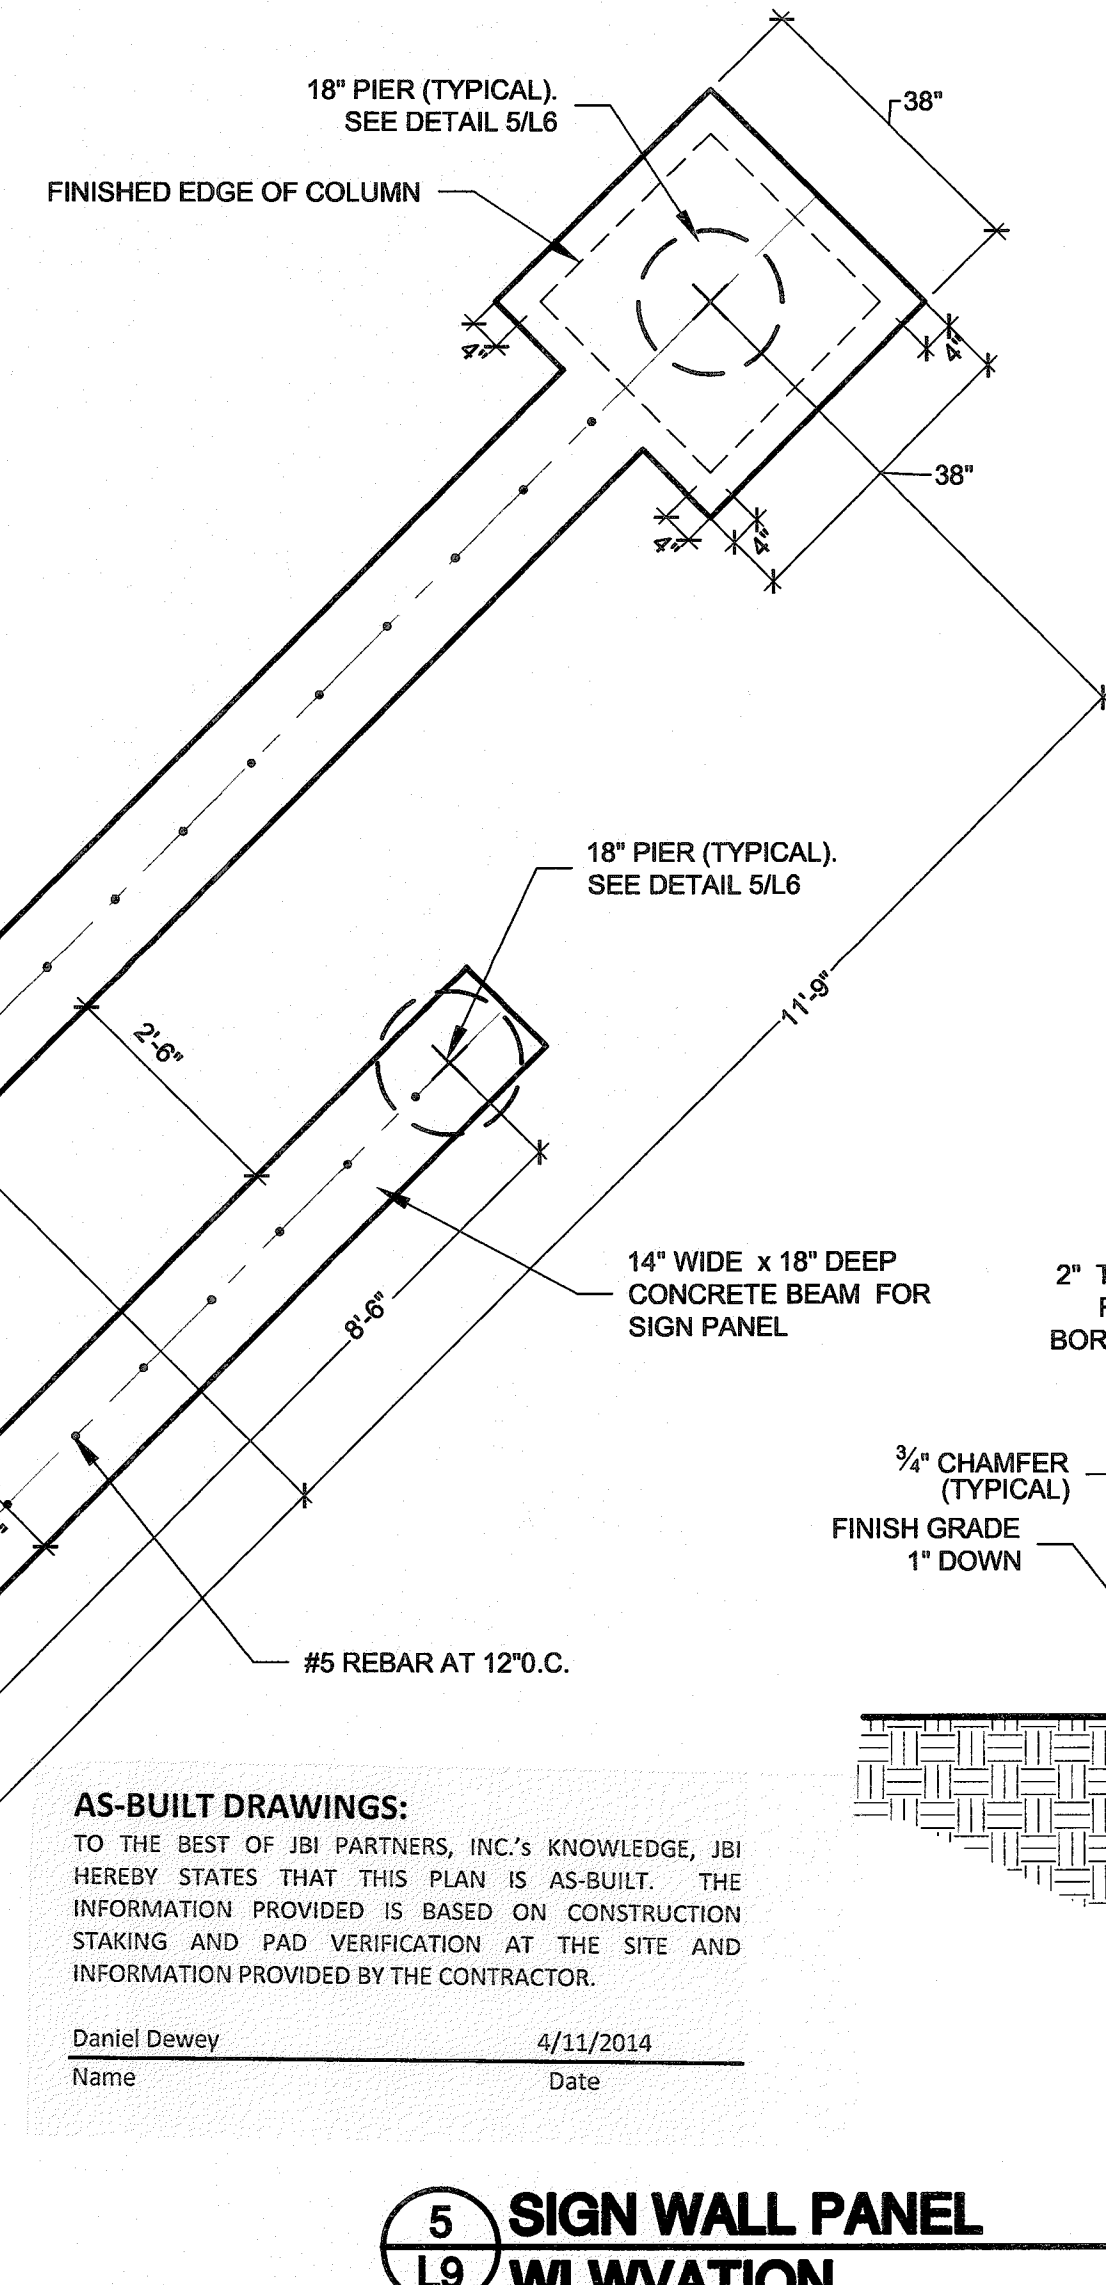

**5 SIGN WALL PANEL WLVVATION**  
 SECTION  
 SCALE: 1/2" = 1'-0"

**AS-BUILT DRAWINGS:**  
 TO THE BEST OF JBI PARTNERS, INC.'S KNOWLEDGE, JBI HEREBY STATES THAT THIS PLAN IS AS-BUILT. THE INFORMATION PROVIDED IS BASED ON CONSTRUCTION STAKING AND PAD VERIFICATION AT THE SITE AND INFORMATION PROVIDED BY THE CONTRACTOR.  
 Daniel Dewey 4/11/2014  
 Name Date

NO.	REVISIONS DURING CONSTRUCTION	BY	DATE	NO.	REVISIONS DURING PLAN REVIEW	BY	DATE
				1	PER CITY COMMENTS & REVISED TRAIL RAMP	CBM	5/7/12

DESIGNED BY:  
 JBI  
 DRAWN BY:  
 JBI  
 CHECKED BY:  
 CBM



16301 Quorum Drive  
 Suite 200 B  
 Addison, Texas 75240  
 Main 972.248.7676  
 Fax 972.248.1414  
 www.jbipartners.com

ENTRANCE WALL DETAILS		PROJECT NO.
PHASE 8A		HOE132
CARUTH LAKES		SHEET NO.
CITY OF ROCKWALL, TEXAS		L9