

ATTACH THE WOVEN FABRIC USING EVENLY SPACED STAPLES OR LOCKING PLASTIC TIES. USE LOCKING PLASTIC TIES OR SEWN VERTICAL POCKETS FOR STEEL POSTS AT SAME SPACING.


ISOMETRIC VIEW

SECTION A-A

SILT FENCE DETAILS
NOT TO SCALE

NOTES

- POSTS WHICH SUPPORT THE SILT FENCE SHALL BE INSTALLED ON A SLIGHT ANGLE TOWARD THE ANTICIPATED RUNOFF SOURCE. THE POST MUST BE EMBEDDED A MINIMUM OF 18 INCHES. NO WOOD POSTS. ALL POST ARE TO BE MADE OF STEEL.
- THE TOE OF THE SILT FENCE SHALL BE TRENCHED IN WITH A SPADE OR MECHANICAL TRENCHER, SO THAT THE DOWN SLOPE FACE OF THE TRENCH IS FLAT AND PERPENDICULAR TO THE LINE OF FLOW. WHERE FENCE CANNOT BE TRENCHED IN (e.g. PAVEMENT), WEIGHT FABRIC FLAP WITH WASHED GRAVEL ON THE UPHILL SIDE TO PREVENT FLOW UNDER FENCE.
- THE TRENCH MUST BE A MINIMUM OF 6 INCHES DEEP AND 6 INCHES WIDE TO ALLOW FOR THE SILT FENCE TO BE LAID IN THE GROUND AND BACKFILLED WITH COMPACTED MATERIAL.
- SILT FENCE SHOULD BE SECURELY FASTENED TO EACH SUPPORT POST OR TO WOVEN WIRE, WHICH IS IN TURN ATTACHED TO THE SUPPORT POST. THERE SHALL BE A 6 INCH DOUBLE OVERLAP, SECURELY FASTENED WHERE ENDS OF FABRIC MEET.
- INSPECTION SHALL BE MADE DAILY OR AFTER EACH RAINFALL. REPAIR OR REPLACEMENT SHALL BE MADE PROMPTLY AS NEEDED.
- SILT FENCE SHALL BE REMOVED WHEN THE SITE IS COMPLETELY STABILIZED SO AS NOT TO BLOCK OR IMPEDE STORM FLOW OR DRAINAGE.
- ACCUMULATED SILT SHALL BE REMOVED WHEN IT REACHES A DEPTH OF 3 INCHES. THE SILT SHALL BE DISPOSED OF AT AN APPROVED SITE AND IN SUCH A MANNER AS TO NOT CONTRIBUTE TO ADDITIONAL SILTATION.

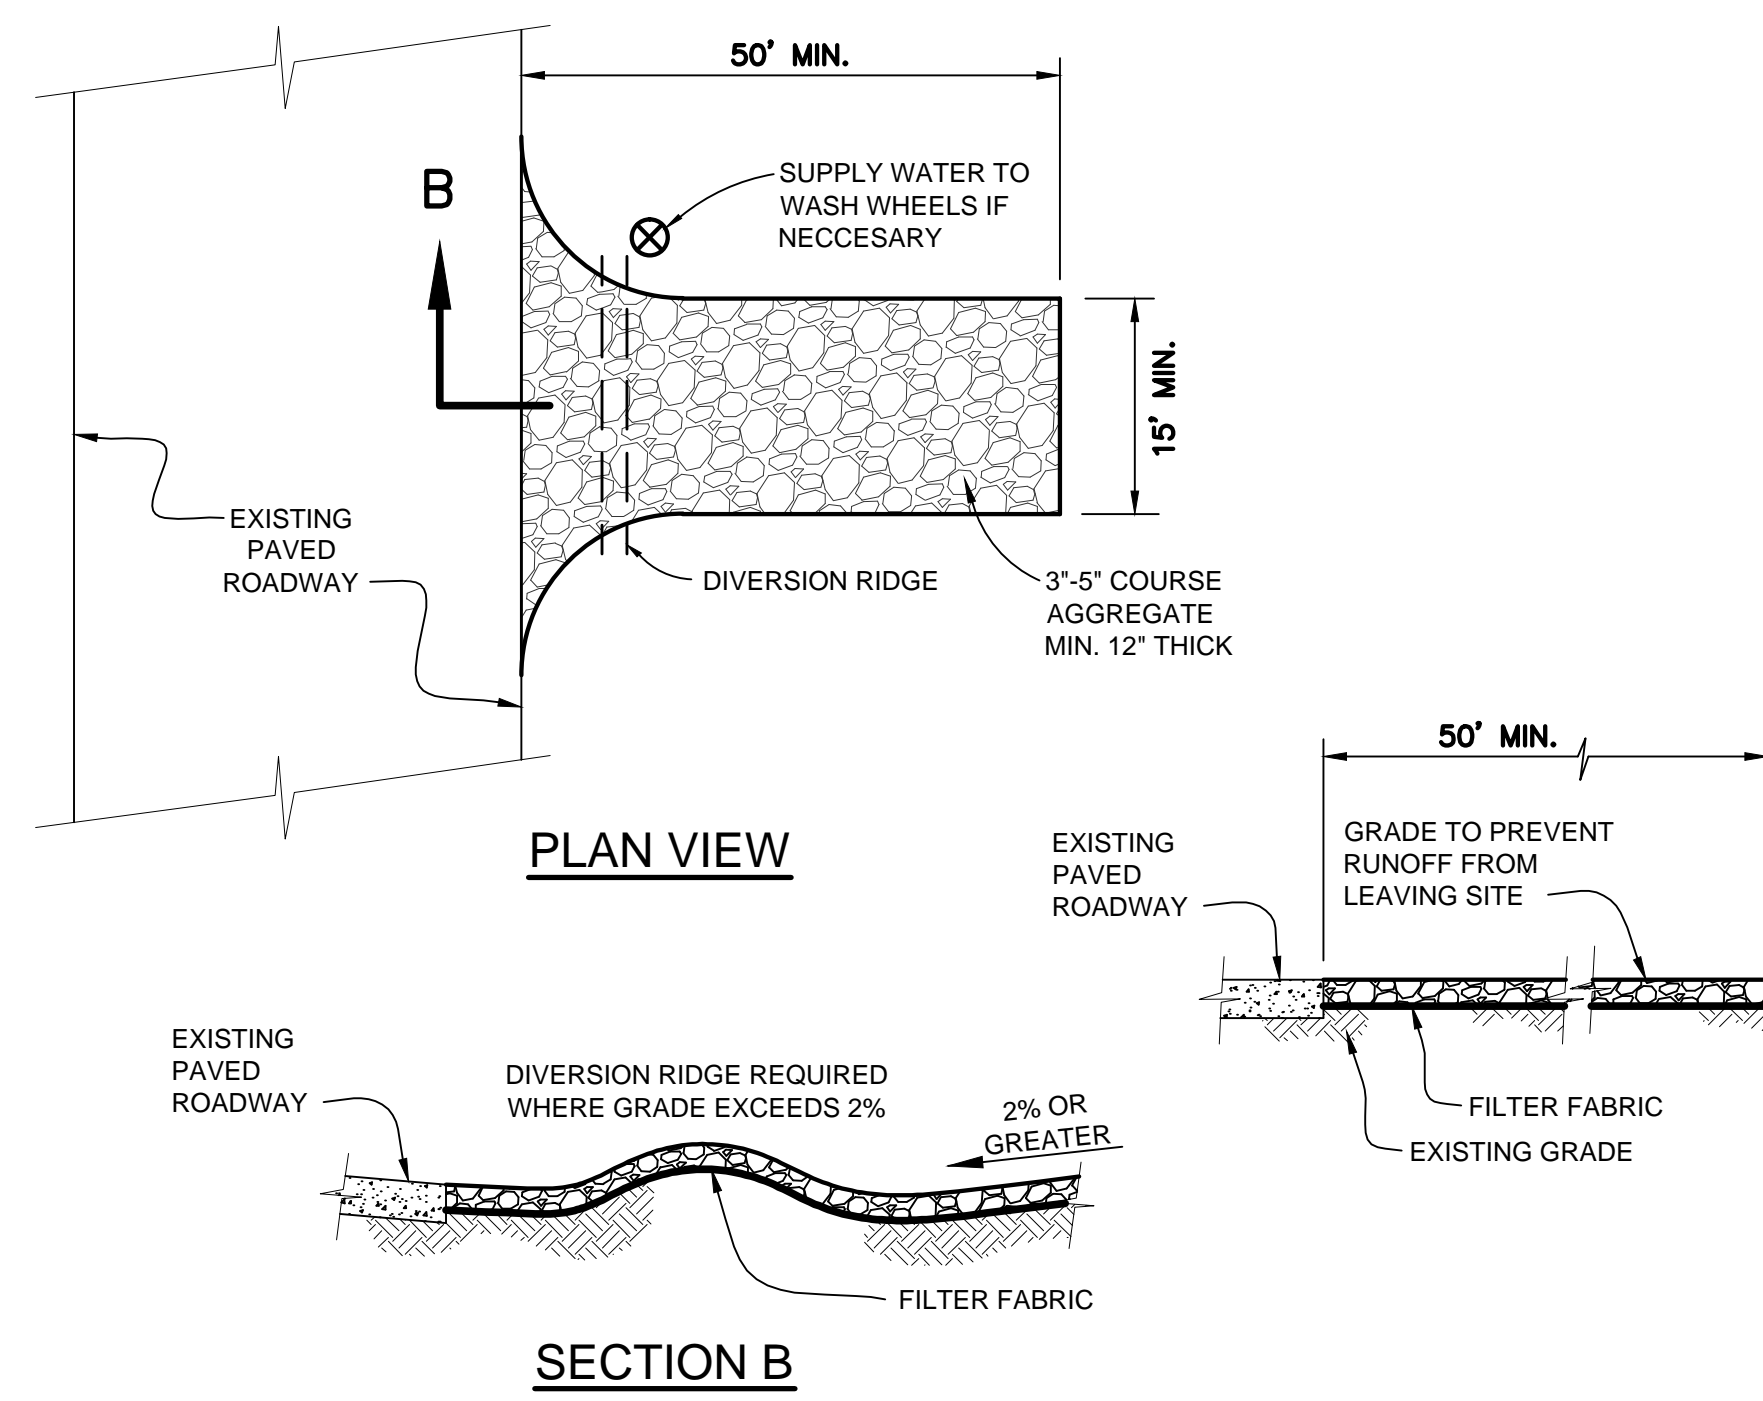


PLAN VIEW

SECTION B


STABILIZED CONSTRUCTION ENTRANCE DETAILS
NOT TO SCALE

NOTES


- CRUSHED STONE FOR CONSTRUCTION ENTRANCE SHALL BE 3'-5" AT GREATEST DIMENSION AND SHALL BE INSTALLED TO A COMPACTED DEPTH OF 12" INCHES.
- NO CRUSHED CONCRETE ALLOWED.
- FILTER FABRIC IS TO BE MARAFI 100X OR EQUAL. (MARAFI, INC.:800-438-1855)
- IF CONSTRUCTION ENTRANCE CROSSES A DRAINAGE DITCH, SWALE, ETC., A DRAINAGE PIPE SHALL BE INSTALLED WITH MIN. 12 INCHES COVER OF CRUSHED STONE.

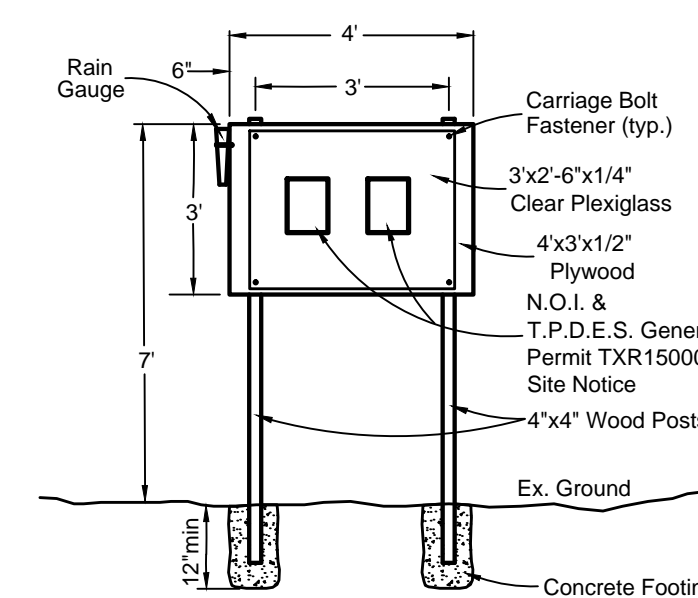

S.W.P.P.P. SIGN BOARD
N.T.S.

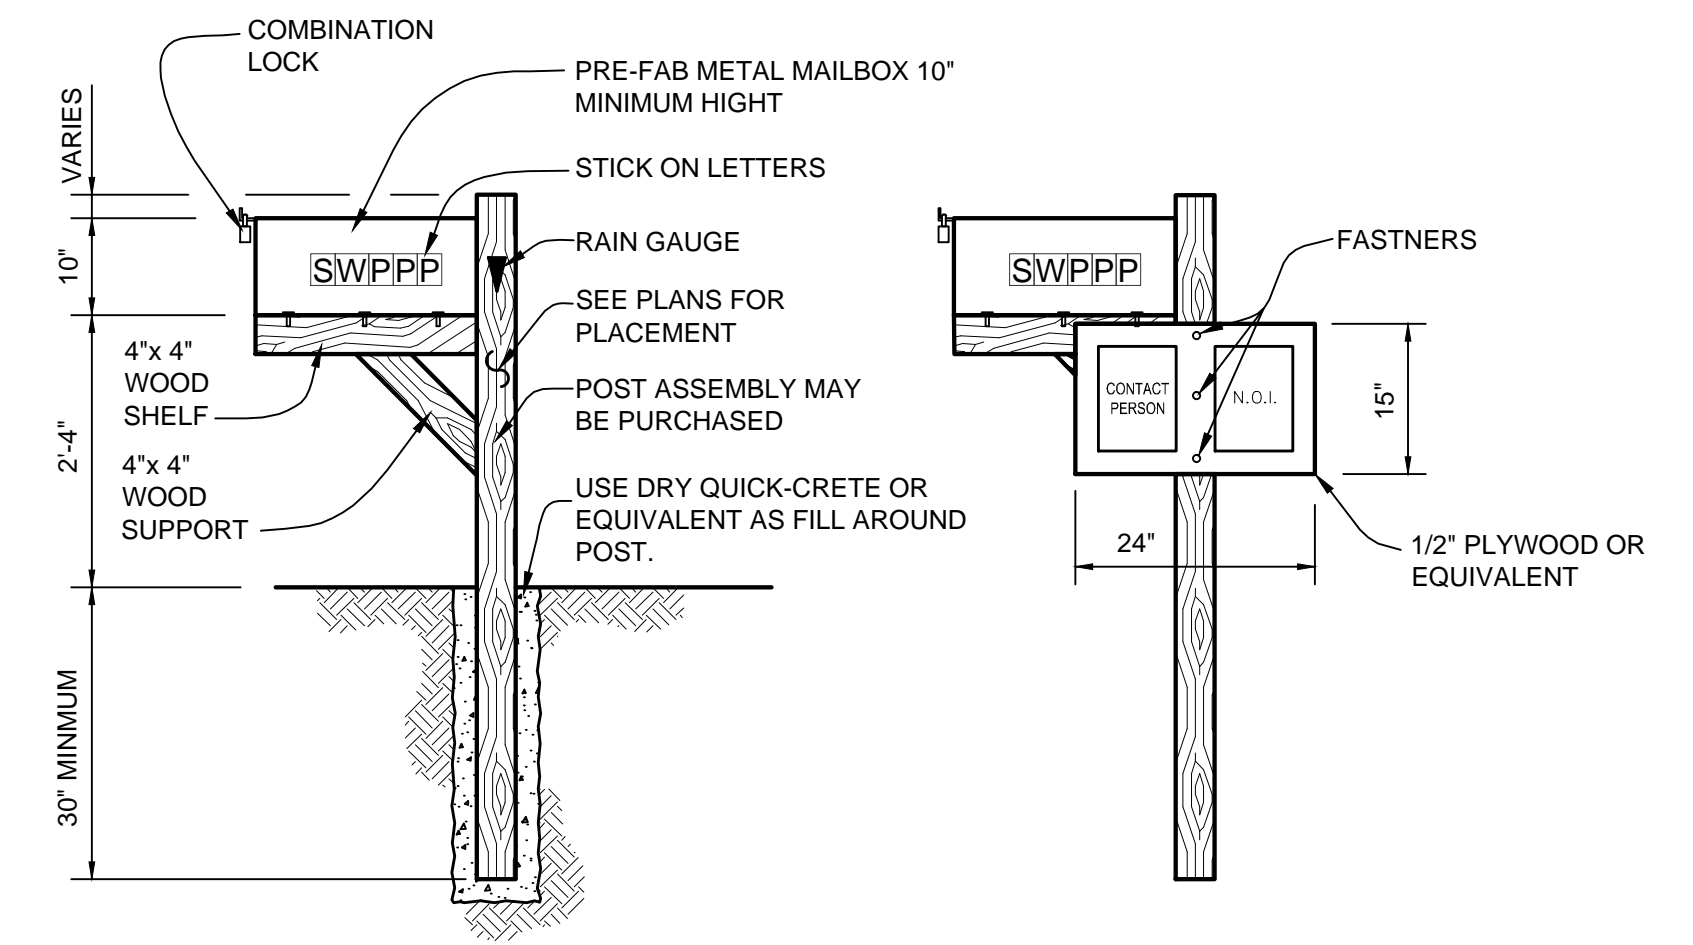

TYPICAL SWPPP POST DETAILS
NOT TO SCALE

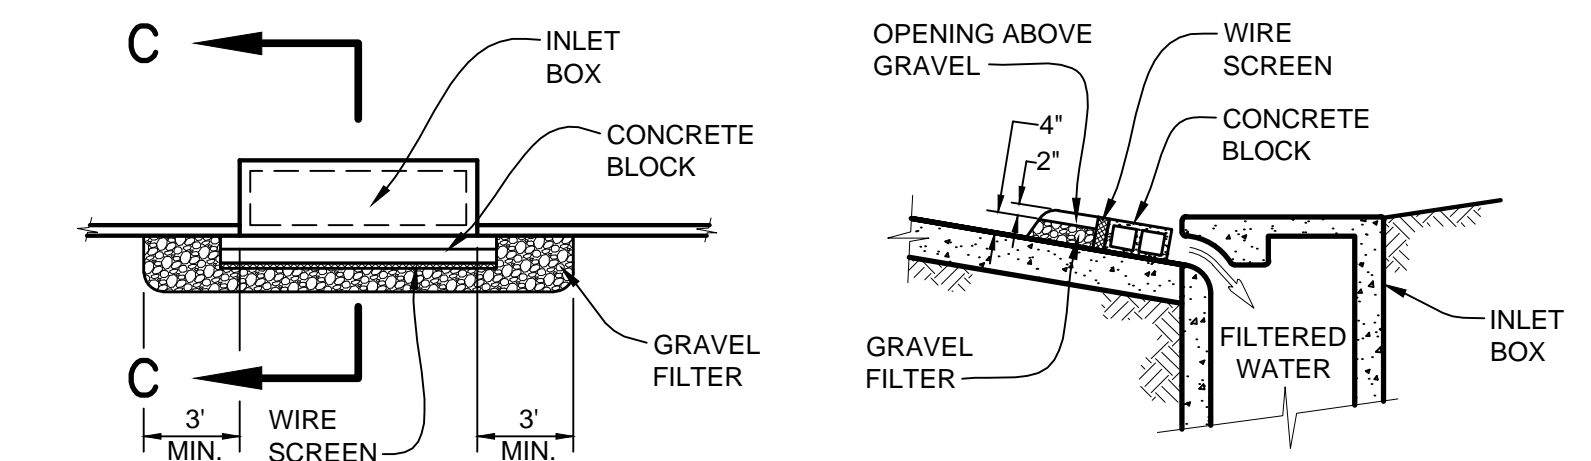

PLAN VIEW

SECTION C-C

SEDIMENT BARRIER AT INLETS
NOT TO SCALE

NOTE

P2 INLET FILTERS REQUIRED WHEN STREET IS OPEN TO VEHICULAR TRAFFIC. SEDIMENT BARRIERS NOT ALLOWED ON OPEN THOROUGHFARES.

BENCHMARKS

- X-chiseled in CL of Alley East of Morningstar Drive within the third lot north of Midnight Pass. Elevation = 513.26
- PK Nail in CL of Caruth Lane & Alley intersection 150 feet +/- east of Morningstar Drive. Elevation = 491.68

NO.	REVISIONS DURING CONSTRUCTION	BY	DATE

AS-BUILT DRAWING

TO THE BEST OF JBI PARTNERS, INC. KNOWLEDGE HEREBY STATES THIS PLAN IS AS-BUILT. THE INFORMATION PROVIDED IS BASED ON CONSTRUCTION STAKING AND PAD VERIFICATION AT THE SITE AND INFORMATION PROVIDED BY THE CONTRACTOR.

NAME: *[Signature]* DATE: 04-13-2015

The seal appearing on this document was authorized by DANIEL DEWEY, P.E. 93961. Alteration of a sealed document without proper notification to the responsible engineer is an offense under the Texas Engineering Practice Act. DATE: 05-17-2013



16301 Quorum Drive Suite 200 B Addison, Texas 75001 Main 972.248.7676 Fax 972.248.1414 www.jbipartners.com

EROSION CONTROL DETAILS		PROJECT NO.
Caruth Lakes Phase 7C		HOE132C
City of Rockwall, Texas		SHEET NO.
		20