

TREE#	TREE TYPE	INCHES	REPLACE INCHES	CREDITS	KEEP-REMOVE-NONPRO.
1154	HACKBERRY	16	8	0	REMOVE
1155	BOIS DE ARC	9	0	0	NON-PROTECTED
1156	BOIS DE ARC	8	0	0	NON-PROTECTED
1157 x1	BOIS DE ARC	15	0	0	NON-PROTECTED
1157 x2	BOIS DE ARC	16	0	0	NON-PROTECTED
1158	BOIS DE ARC	8	0	0	NON-PROTECTED
1159	BOIS DE ARC	8	0	0	NON-PROTECTED
1160	BOIS DE ARC	23	0	0	NON-PROTECTED
1161	BOIS DE ARC	8	0	0	NON-PROTECTED
1162	BOIS DE ARC	13	0	0	NON-PROTECTED
1163	HACKBERRY	9	0	0	NON-PROTECTED
1164	BOIS DE ARC	14	0	0	NON-PROTECTED
1165	HACKBERRY	6	0	0	NON-PROTECTED
1166	BOIS DE ARC	7	0	0	NON-PROTECTED
1167	HACKBERRY	9	0	0	NON-PROTECTED
1168	HACKBERRY	8	0	0	NON-PROTECTED
1169	BOIS DE ARC	12	0	0	NON-PROTECTED
1170	HACKBERRY	8	0	0	NON-PROTECTED
1171	BOIS DE ARC	15	0	0	NON-PROTECTED
1172	BOIS DE ARC	7	0	0	NON-PROTECTED
1173	BOIS DE ARC	12	0	0	NON-PROTECTED
1174	HACKBERRY	11	0	0	GAS
1175	BOIS DE ARC	10	0	0	NON-PROTECTED
1176	BOIS DE ARC	10	0	0	NON-PROTECTED
1177	HACKBERRY	11	0	0	GAS
1178	HACKBERRY	10	0	0	NON-PROTECTED
1179	BOIS DE ARC	10	0	0	NON-PROTECTED
1180	HACKBERRY	12	0	0	GAS
1181	HACKBERRY	9	0	0	NON-PROTECTED
1182	HACKBERRY	6	0	0	NON-PROTECTED
1183 x1	BOIS DE ARC	14	0	0	NON-PROTECTED
1183 x2	BOIS DE ARC	14	0	0	NON-PROTECTED
1184	BOIS DE ARC	7	0	0	NON-PROTECTED
1185	HACKBERRY	6	0	0	NON-PROTECTED
1186	BOIS DE ARC	17	0	0	NON-PROTECTED
1187	HACKBERRY	12	0	0	GAS
1188	HACKBERRY	9	0	0	NON-PROTECTED
1189	HACKBERRY	13	0	0	GAS
1190	HACKBERRY	7	0	0	NON-PROTECTED
1191	HACKBERRY	14	0	0	GAS
1192	BOIS DE ARC	13	0	0	NON-PROTECTED
1193	HACKBERRY	7	0	0	NON-PROTECTED
1194	BOIS DE ARC	10	0	0	NON-PROTECTED
1195	BOIS DE ARC	11	0	0	NON-PROTECTED
1196	HACKBERRY	8	0	0	NON-PROTECTED
1197	BOIS DE ARC	14	0	0	NON-PROTECTED
1198	HACKBERRY	11	0	0	GAS
1199	BOIS DE ARC	14	0	0	NON-PROTECTED
1200	HACKBERRY	16	0	0	GAS
1201 X1	HACKBERRY	10	0	0	NON-PROTECTED
1201 X2	HACKBERRY	10	0	0	NON-PROTECTED
1202	HACKBERRY	7	0	0	NON-PROTECTED
1203	HACKBERRY	17	8.5	0	REMOVE
1204	HACKBERRY	12	6	0	REMOVE
1205 X1	HACKBERRY	8	0	0	NON-PROTECTED
1205 X2	HACKBERRY	8	0	0	NON-PROTECTED
1205 X3	HACKBERRY	12	6	0	REMOVE
1205 X4	HACKBERRY	13	6.5	0	REMOVE
1206	HACKBERRY	17	8.5	0	REMOVE
1207	HACKBERRY	7	0	0	NON-PROTECTED
1208	HACKBERRY	15	7.5	0	REMOVE
1209	HACKBERRY	8	0	0	NON-PROTECTED
1210	HACKBERRY	8	0	0	NON-PROTECTED
1211	HACKBERRY	7	0	0	NON-PROTECTED
1212	HACKBERRY	18	9	0	REMOVE
1213	HACKBERRY	14	7	0	REMOVE
1214	HACKBERRY	6	0	0	NON-PROTECTED
1215	HACKBERRY	8	0	0	REMOVE
1216	HACKBERRY	13	6.5	0	REMOVE
1217	HACKBERRY	13	6.5	0	REMOVE
1218	HACKBERRY	6	0	0	NON-PROTECTED
1219	HACKBERRY	7	0	0	NON-PROTECTED
1220	HACKBERRY	8	0	0	NON-PROTECTED
1221	HACKBERRY	9	0	0	NON-PROTECTED
1222	HACKBERRY	11	5.5	0	REMOVE
1223	HACKBERRY	18	9	0	REMOVE
1224	HACKBERRY	9	0	0	NON-PROTECTED
1225	HACKBERRY	6	0	0	NON-PROTECTED
1226	HACKBERRY	9	0	0	NON-PROTECTED
1227	HACKBERRY	10	0	0	NON-PROTECTED
1228	HACKBERRY	9	0	0	NON-PROTECTED
1229	HACKBERRY	12	6	0	REMOVE
1230	HACKBERRY	13	6.5	0	REMOVE
1231	HACKBERRY	7	0	0	NON-PROTECTED
1232	HACKBERRY	6	0	0	NON-PROTECTED
1233	HACKBERRY	10	0	0	NON-PROTECTED
1234	HACKBERRY	6	0	0	NON-PROTECTED
1235	HACKBERRY	6	0	0	NON-PROTECTED
1236	BOIS DE ARC	19	0	0	NON-PROTECTED
1340	BOIS DE ARC	26	0	0	NON-PROTECTED
1341 X1	HACKBERRY	6	0	0	NON-PROTECTED
1341 X2	HACKBERRY	7	0	0	NON-PROTECTED
1343	HACKBERRY	6	0	0	NON-PROTECTED
1344	HACKBERRY	7	0	0	NON-PROTECTED
1346	HACKBERRY	11	5.5	0	REMOVE
1348	HACKBERRY	10	0	0	NON-PROTECTED
1349 X1	HACKBERRY	11	5.5	0	REMOVE
1349 X2	HACKBERRY	11	5.5	0	REMOVE
1349 X3	HACKBERRY	12	6	0	REMOVE
1349 X4	HACKBERRY	12	6	0	REMOVE
1350	HACKBERRY	10	0	0	NON-PROTECTED

TREE PLANTING TABULATIONS	
156 LOTS x 6" (2-3" TREES)	936 INCHES
TOTAL INCHES TO BE PLANTED	+936 INCHES
TREE CREDIT TABULATIONS	
CREDIT INCHES >24" TREES REMAINING	0 INCHES
REPLACEMENT INCHES	-161.5 INCHES
TOTAL OF TREE PLANTING/CREDIT	774.5" SURPLUS

TREE#	TREE TYPE	INCHES	REPLACE INCHES	CREDITS	KEEP-REMOVE-NONPRO.
1351	HACKBERRY	10	0	0	NON-PROTECTED
1352 X1	HACKBERRY	7	0	0	NON-PROTECTED
1352 X2	HACKBERRY	12	6	0	REMOVE
1352 X3	HACKBERRY	17	8.5	0	REMOVE
1353	HACKBERRY	7	0	0	NON-PROTECTED
1354	HACKBERRY	11	5.5	0	REMOVE
1355 X1	HACKBERRY	9	0	0	NON-PROTECTED
1355 X2	HACKBERRY	10	0	0	NON-PROTECTED
1355 X3	HACKBERRY	12	6	0	REMOVE
1357 X1	BOIS DE ARC	7	0	0	NON-PROTECTED
1357 X2	BOIS DE ARC	7	0	0	NON-PROTECTED
1358 X1	BOIS DE ARC	6	0	0	NON-PROTECTED
1358 X2	BOIS DE ARC	6	0	0	NON-PROTECTED
1358 X3	BOIS DE ARC	6	0	0	NON-PROTECTED
1420	BOIS DE ARC	10	0	0	NON-PROTECTED
1446	HACKBERRY	7	0	0	NON-PROTECTED
1447	HACKBERRY	7	0	0	NON-PROTECTED
1448	HACKBERRY	8	0	0	NON-PROTECTED
1449	HACKBERRY	6	0	0	NON-PROTECTED
1450 X1	HACKBERRY	6	0	0	NON-PROTECTED
1450 X2	HACKBERRY	6	0	0	NON-PROTECTED
1451	BOIS DE ARC	10	0	0	NON-PROTECTED
1452	CEDAR	7	0	0	NON-PROTECTED
1453	ELM	15	0	0	KEEP
1454	ELM	9	0	0	KEEP
1455	ELM	6	0	0	KEEP
1456	COTTONWOOD	13	0	0	NON-PROTECTED
1457	HACKBERRY	11	0	0	KEEP
1458	HACKBERRY	6	0	0	NON-PROTECTED
1459	ELM	13	0	0	KEEP
1460	ELM	13	0	0	KEEP
1461	HACKBERRY	6	0	0	NON-PROTECTED
1462	HACKBERRY	9	0	0	NON-PROTECTED
1463	HACKBERRY	21	0	0	KEEP
1464	ELM	7	0	0	KEEP
1465	ELM	6	0	0	KEEP



LEGEND

 TREES TO BE REMOVED

ALL RESPONSIBILITY FOR ADEQUACY OF DESIGN REMAINS WITH THE DESIGN ENGINEER. THE CITY OF ROCKWALL, IN REVIEWING AND RELEASING PLANS FOR CONSTRUCTION, ASSUMES NO RESPONSIBILITY FOR ADEQUACY OR ACCURACY OF DESIGN.

BENCHMARKS

1. X-chiseled in CL of Alley East of Morningstar Drive within the third lot north of Midnight Pass.
Elevation = 513.26
2. PK Nail in CL of Caruth Lane & Alley intersection 150 feet +/- east of Morningstar Drive.
Elevation = 491.68


NO.	REVISIONS DURING CONSTRUCTION	BY	DATE

AS-BUILT DRAWING

TO THE BEST OF JBI PARTNERS, INC. KNOWLEDGE HEREBY STATES THIS PLAN IS AS-BUILT. THE INFORMATION PROVIDED IS BASED ON CONSTRUCTION STAKING AND PAD VERIFICATION AT THE SITE AND INFORMATION PROVIDED BY THE CONTRACTOR.

NAME 

DATE 04-13-2015

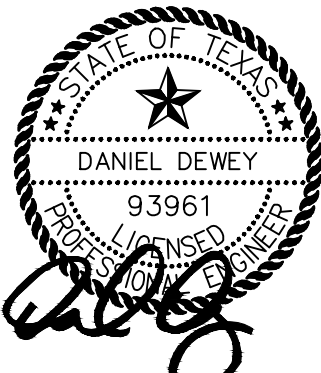

The seal appearing on this document was authorized by DANIEL DEWEY, P.E. 93961. Alteration of a sealed document without proper notification to the responsible engineer is an offense under the Texas Engineering Practice Act.

4-1-13



Texas Registered Engineering Firm F-438

16301 Quorum Drive
Suite 200 B
Addison, Texas 75001
Main 972.248.7676
Fax 972.248.1414
www.jbipartners.com

TREE SURVEY

Caruth Lakes Phase 7D
City of Rockwall, Texas

PROJECT NO.	HOE132
SHEET NO.	20