
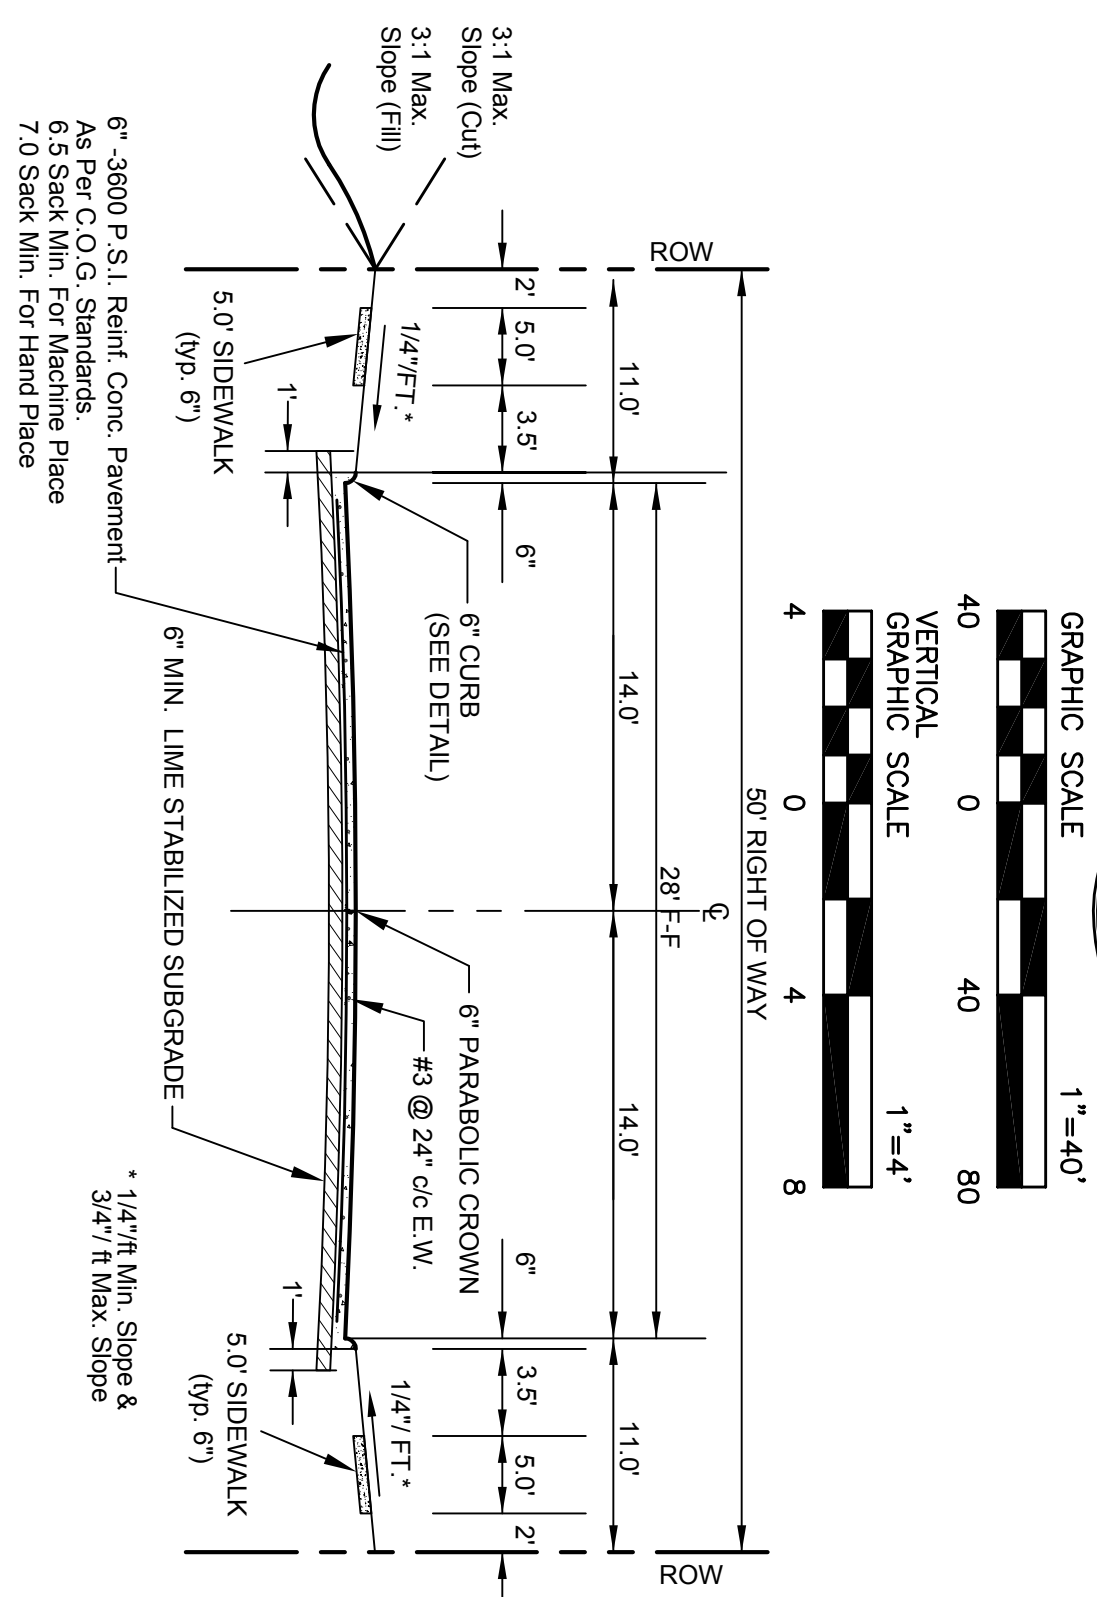
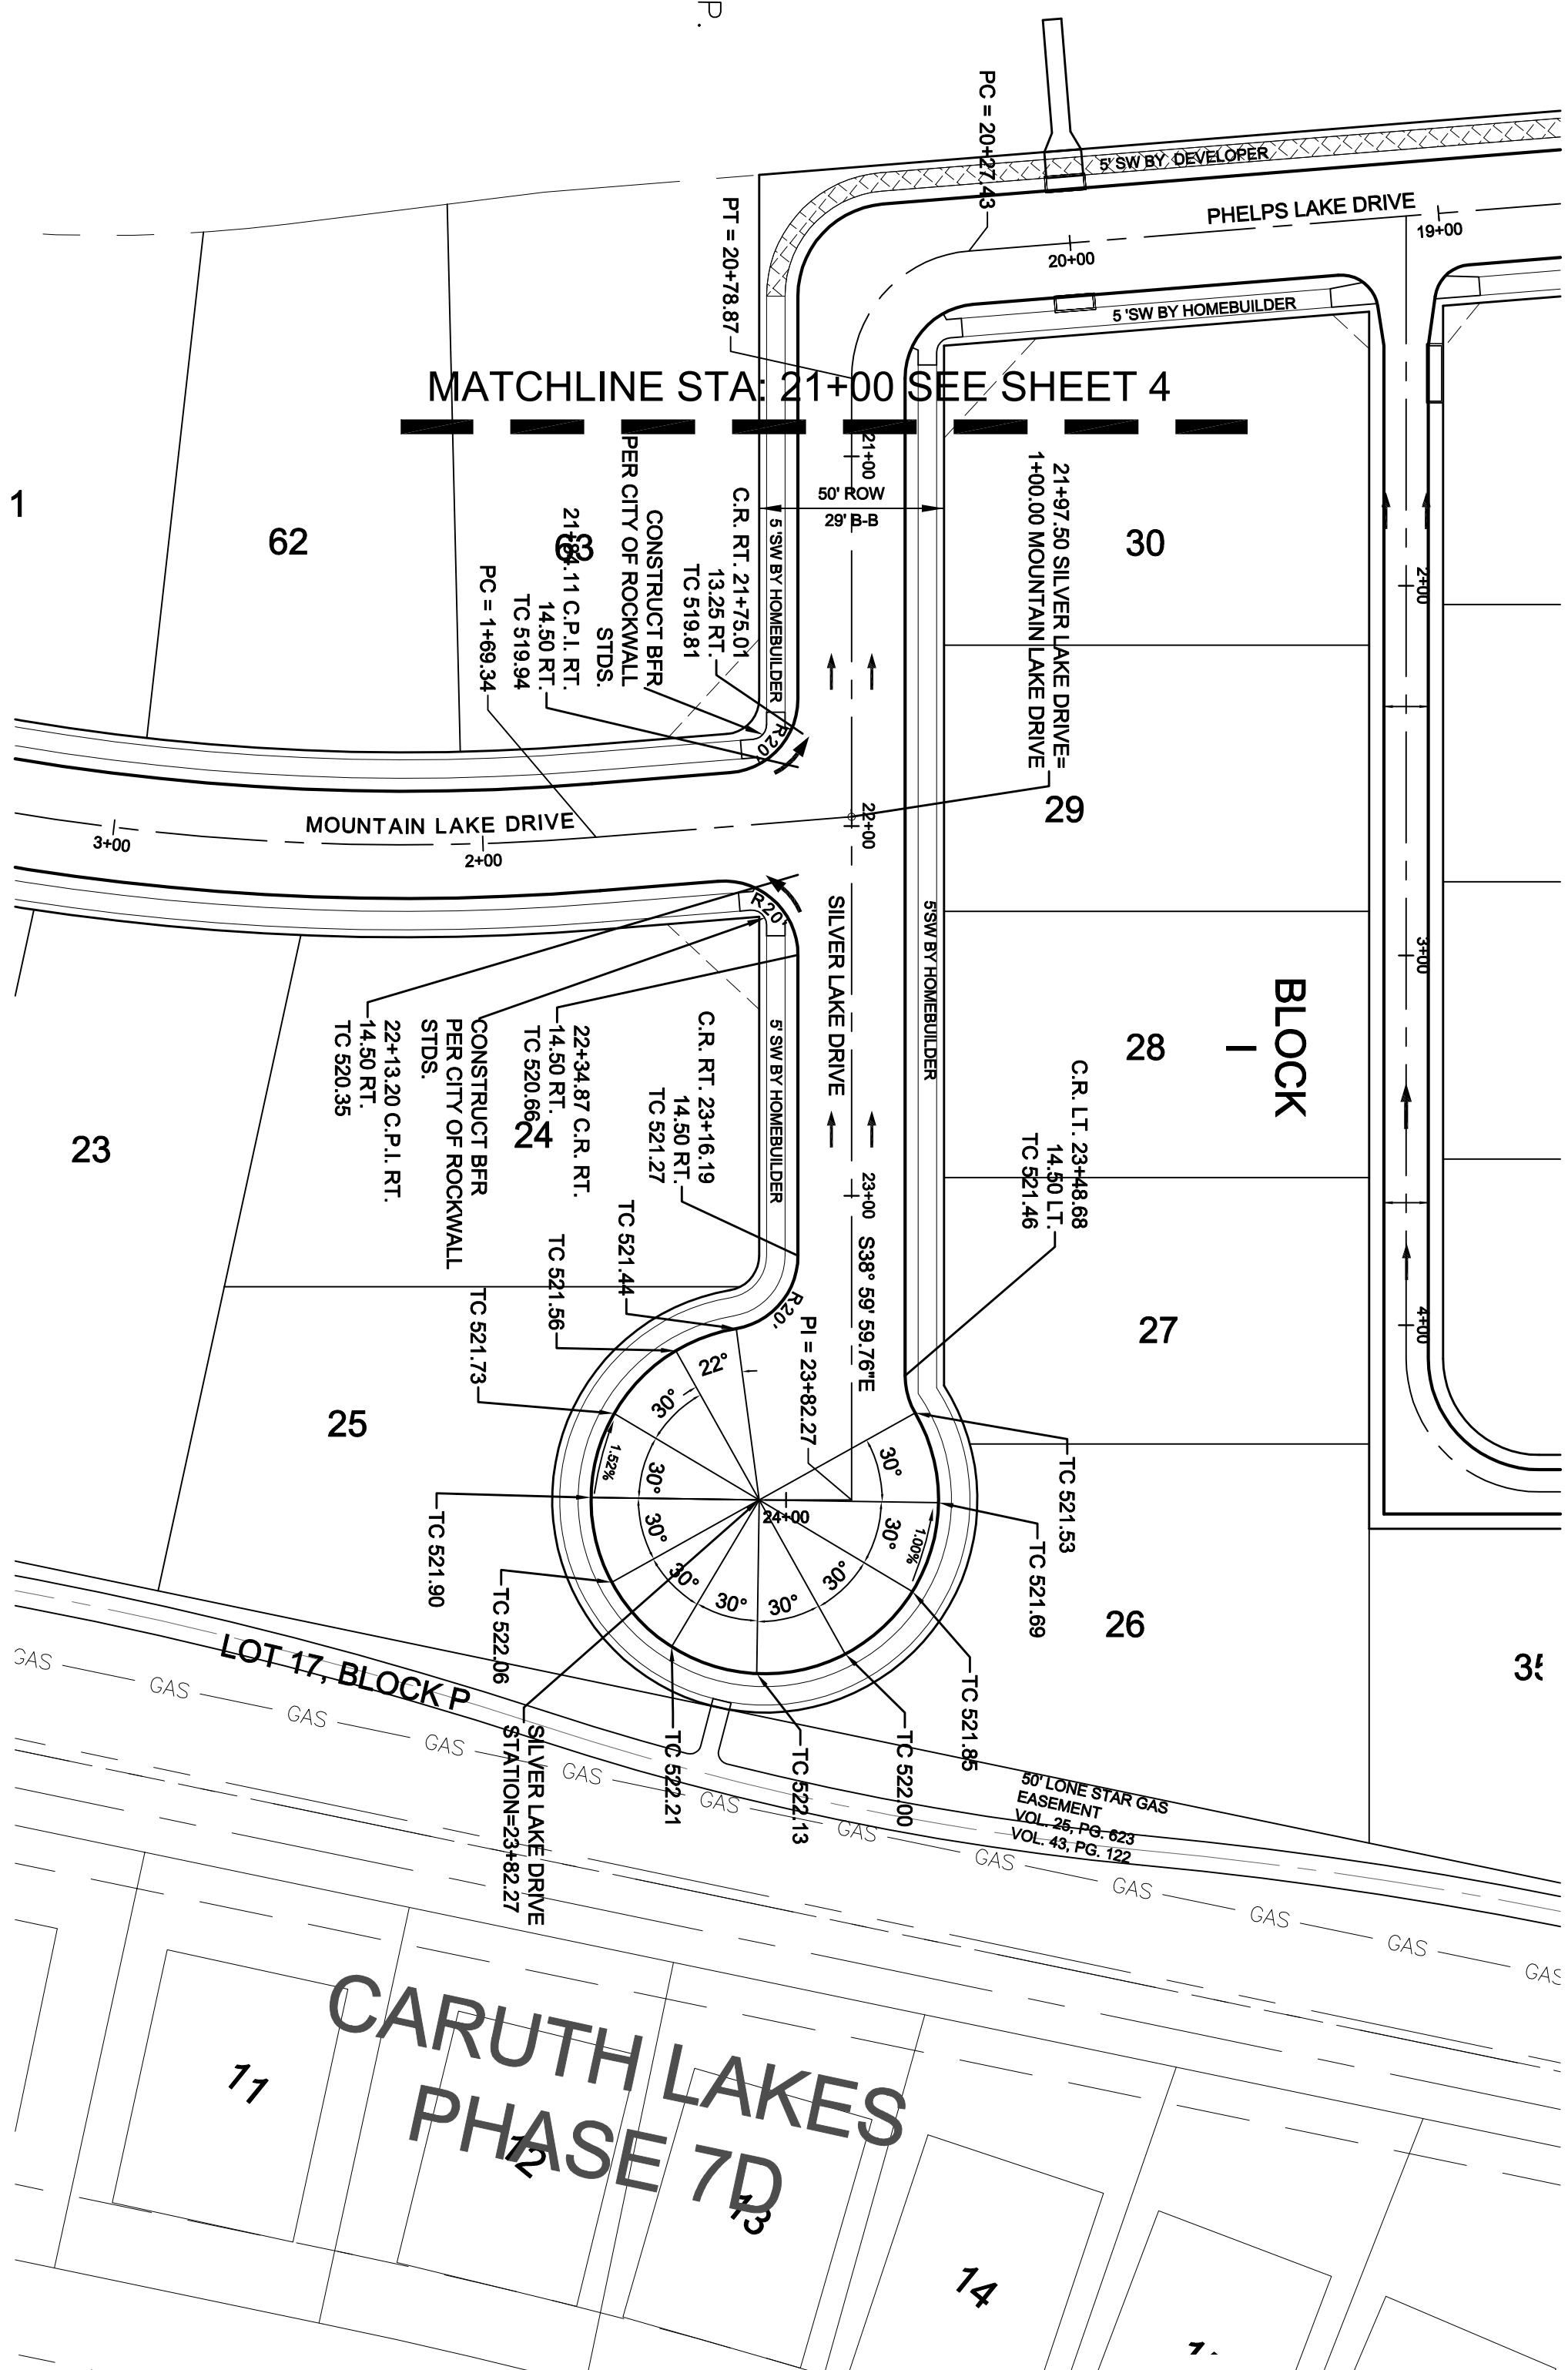


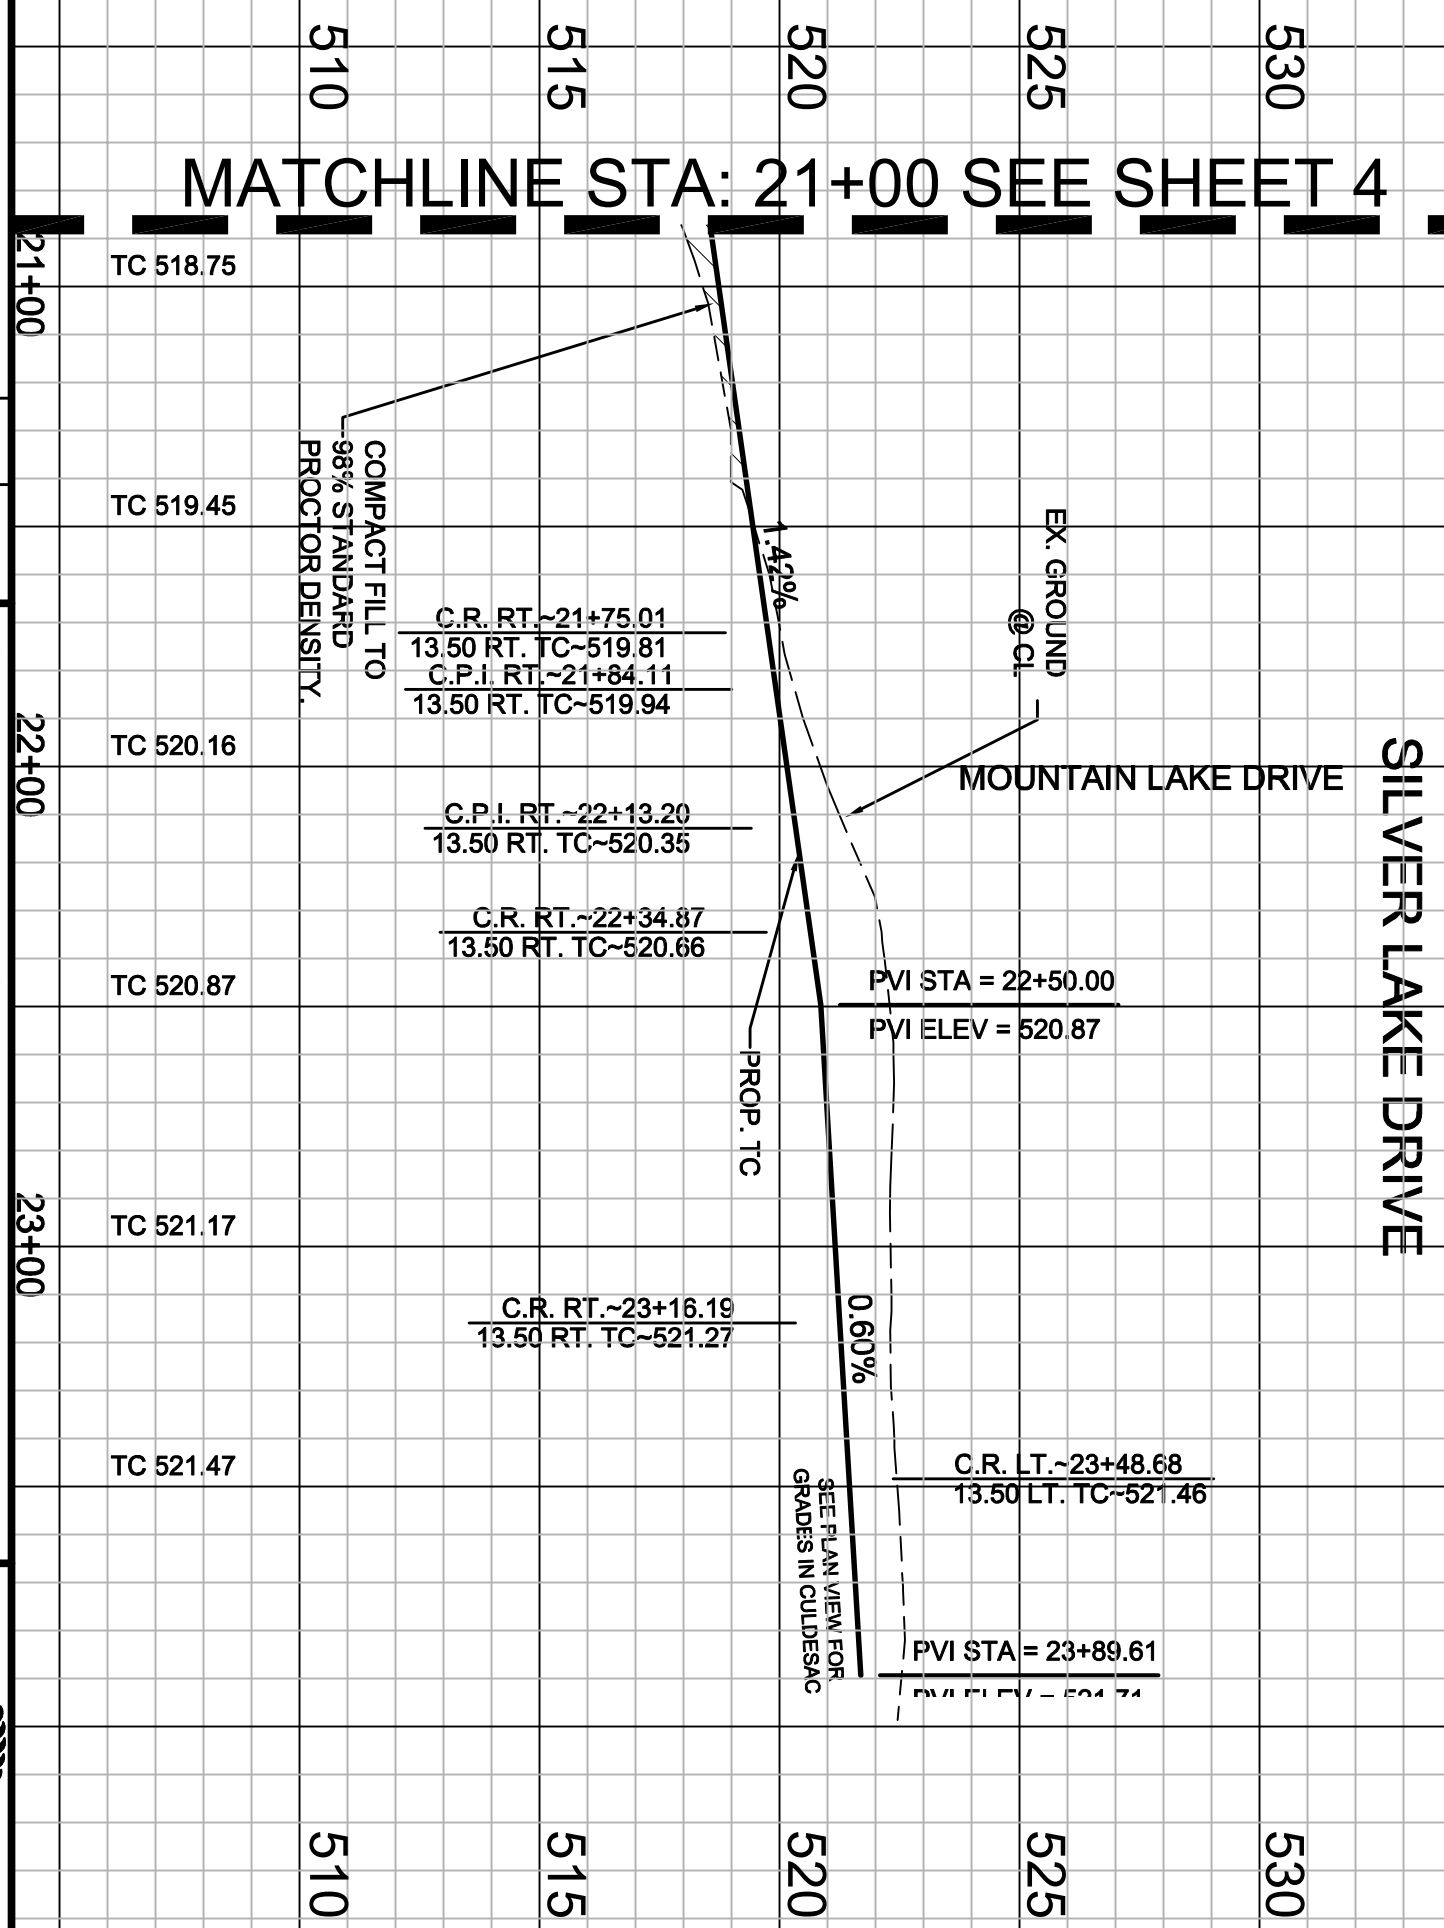


NOTE:

1. PAVEMENT FOR STREETS SHALL CONSIST OF 6" 3600 P.S.I. REINFORCED CONCRETE AND 6" LIME-STABILIZED SUBGRADE WITH 6" PARABOLIC CURVE.
2. PAVEMENT FOR ALLEYS SHALL CONSIST OF 4000 P.S.I. REINFORCED CONCRETE AND 6" LIME-STABILIZED SUBGRADE WITH 5" INVERT. TYPICAL ALLEY SECTION WILL BE 7'-5" TO 7'-7".
3. CONTRACTOR TO RUN LIME SERIES BEFORE CONSTRUCTION.

[illegible]

AS-BUILT DRAWING
TO THE BEST OF JB PARTNERS, INC. KNOWLEDGE, HEREBY STATES
THIS PLAN IS AS-BUILT. THE INFORMATION PROVIDED IS BASED ON
CONSTRUCTION STAKING AND PAD VERIFICATION AT THE SITE AND
INFORMATION PROVIDED BY THE CONTRACTOR.

NAME 
DATE 06-04-2015

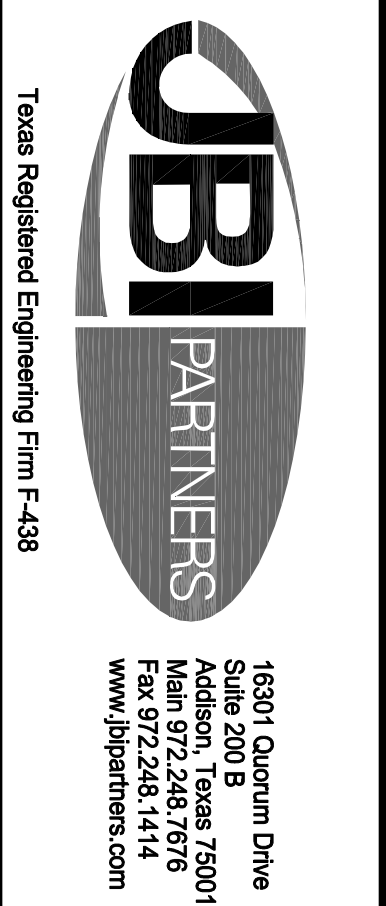

PAVING PLAN & PROFILE	PROJECT NO.
SILVER LAKE DRIVE (STA: 21+00 - END)	HOE 32F
Caruth Lakes Phase 8B	SHEET NO.
City of Rockwall, Texas	5