
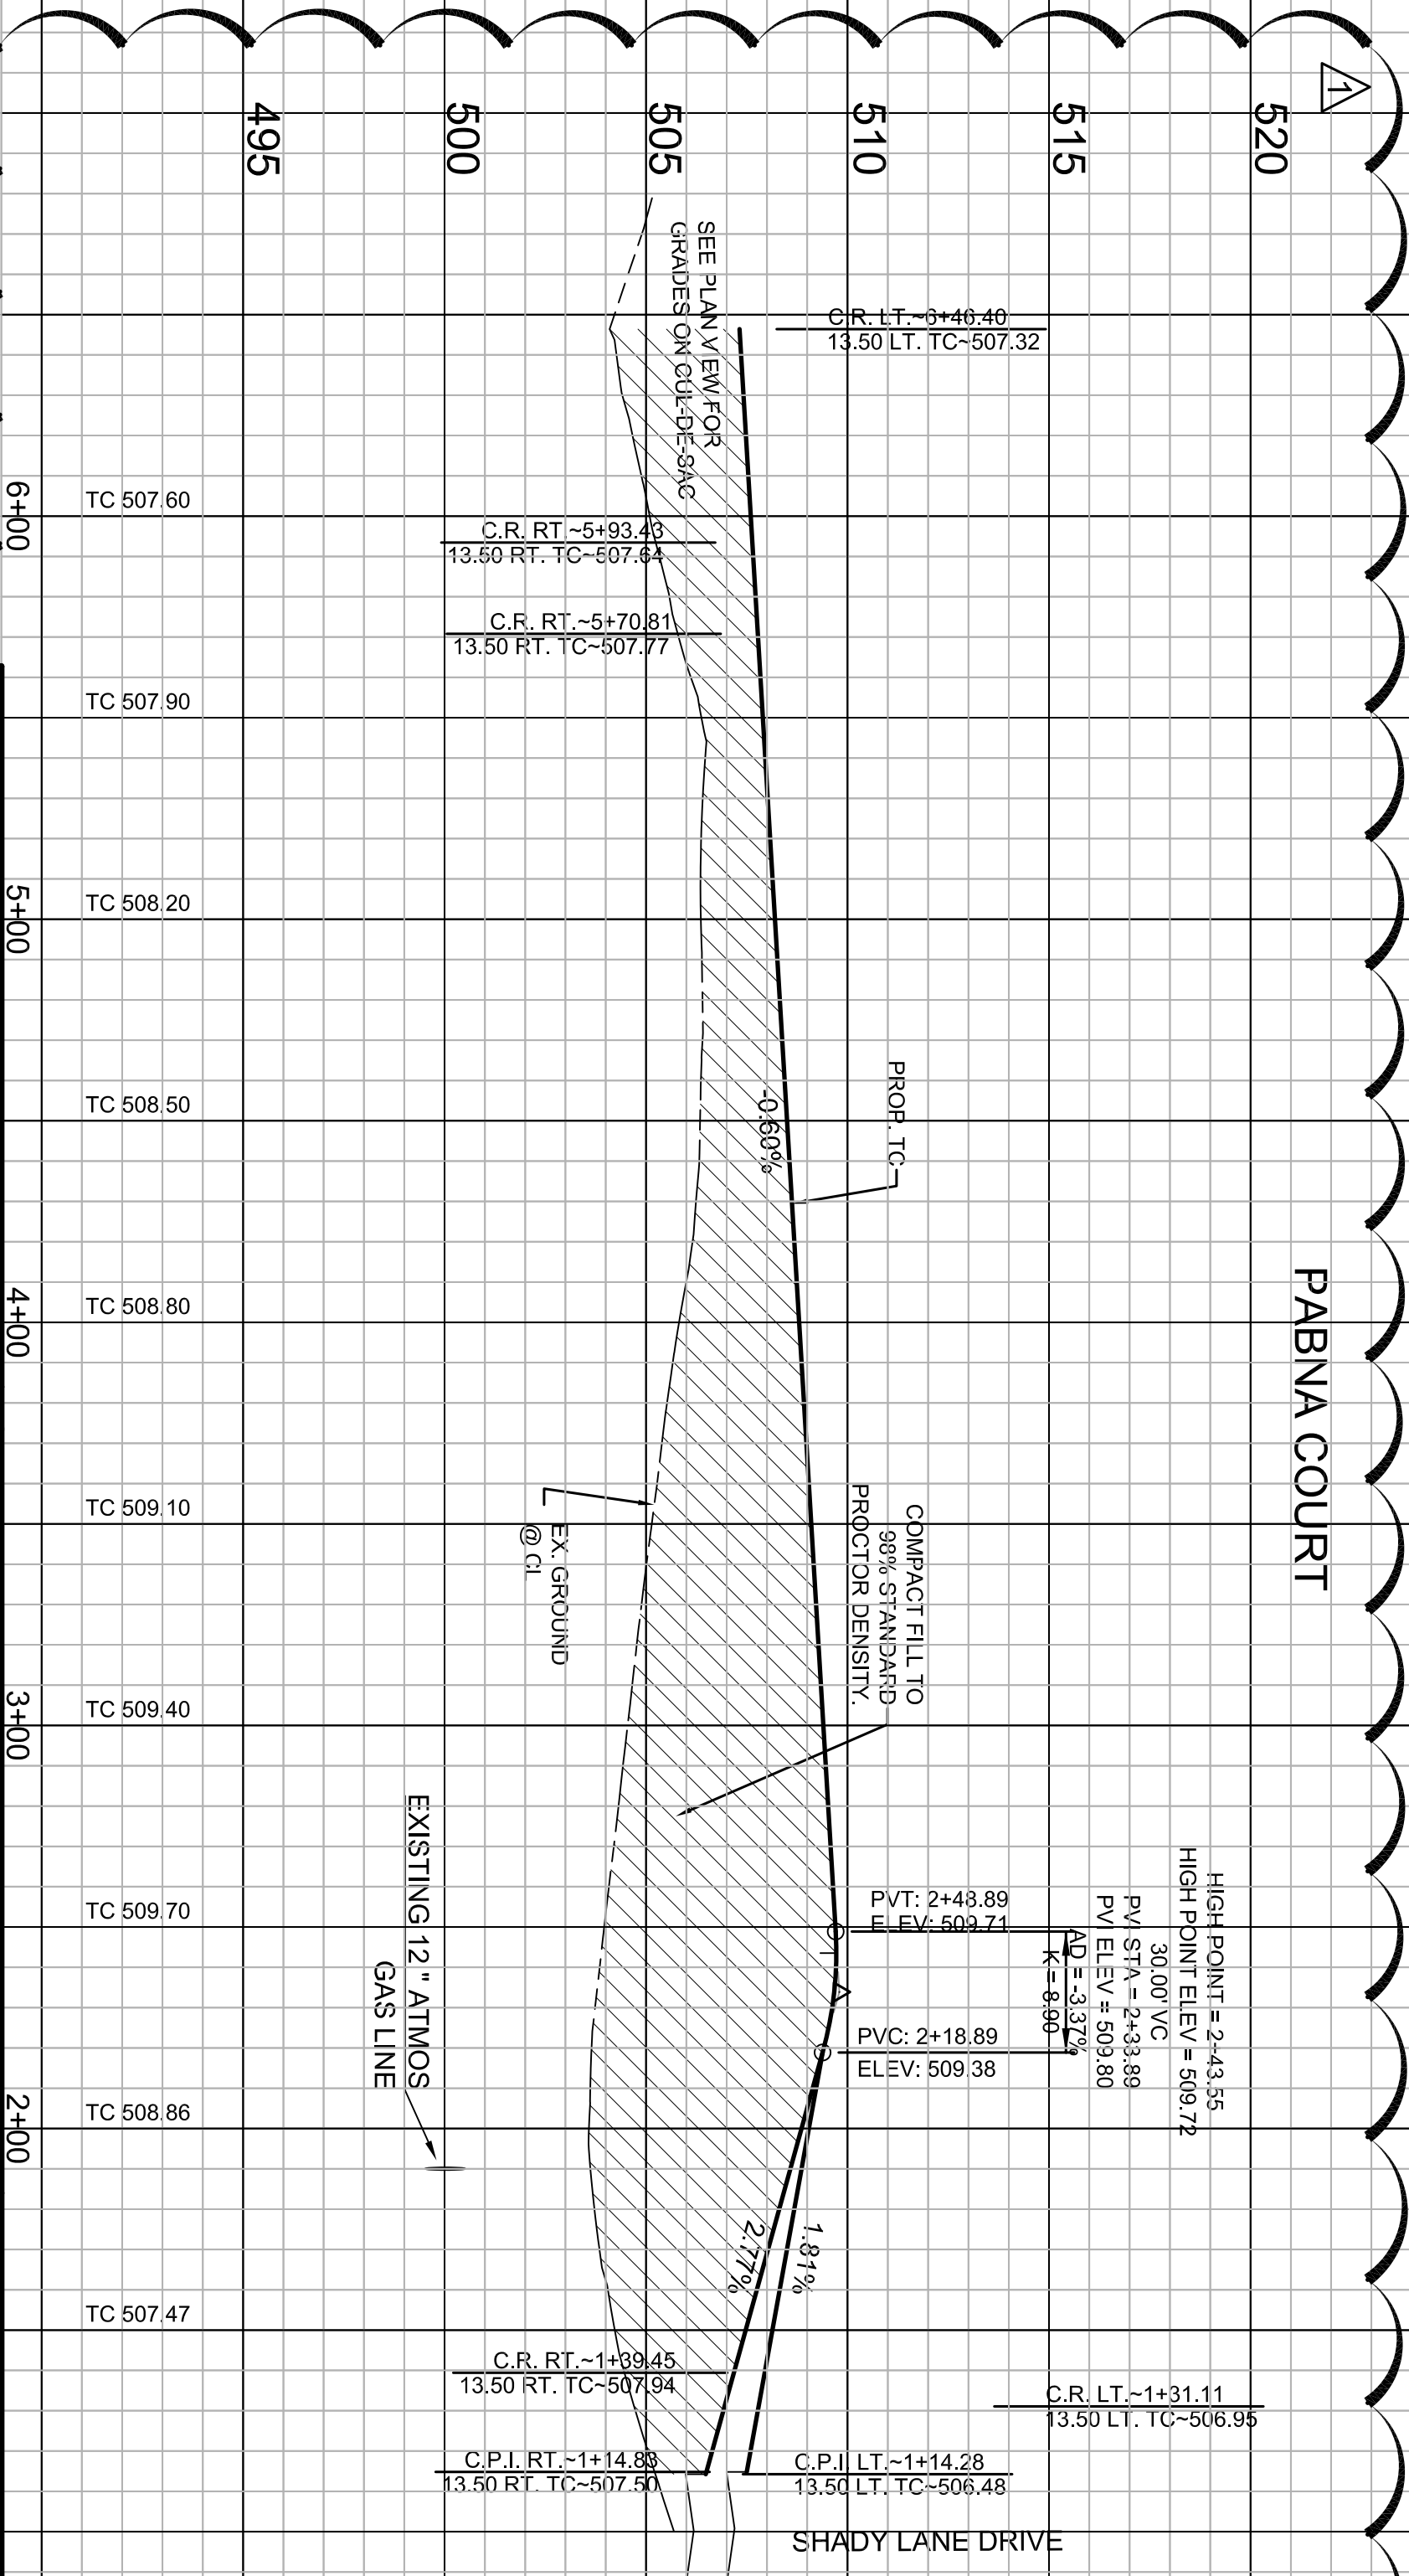
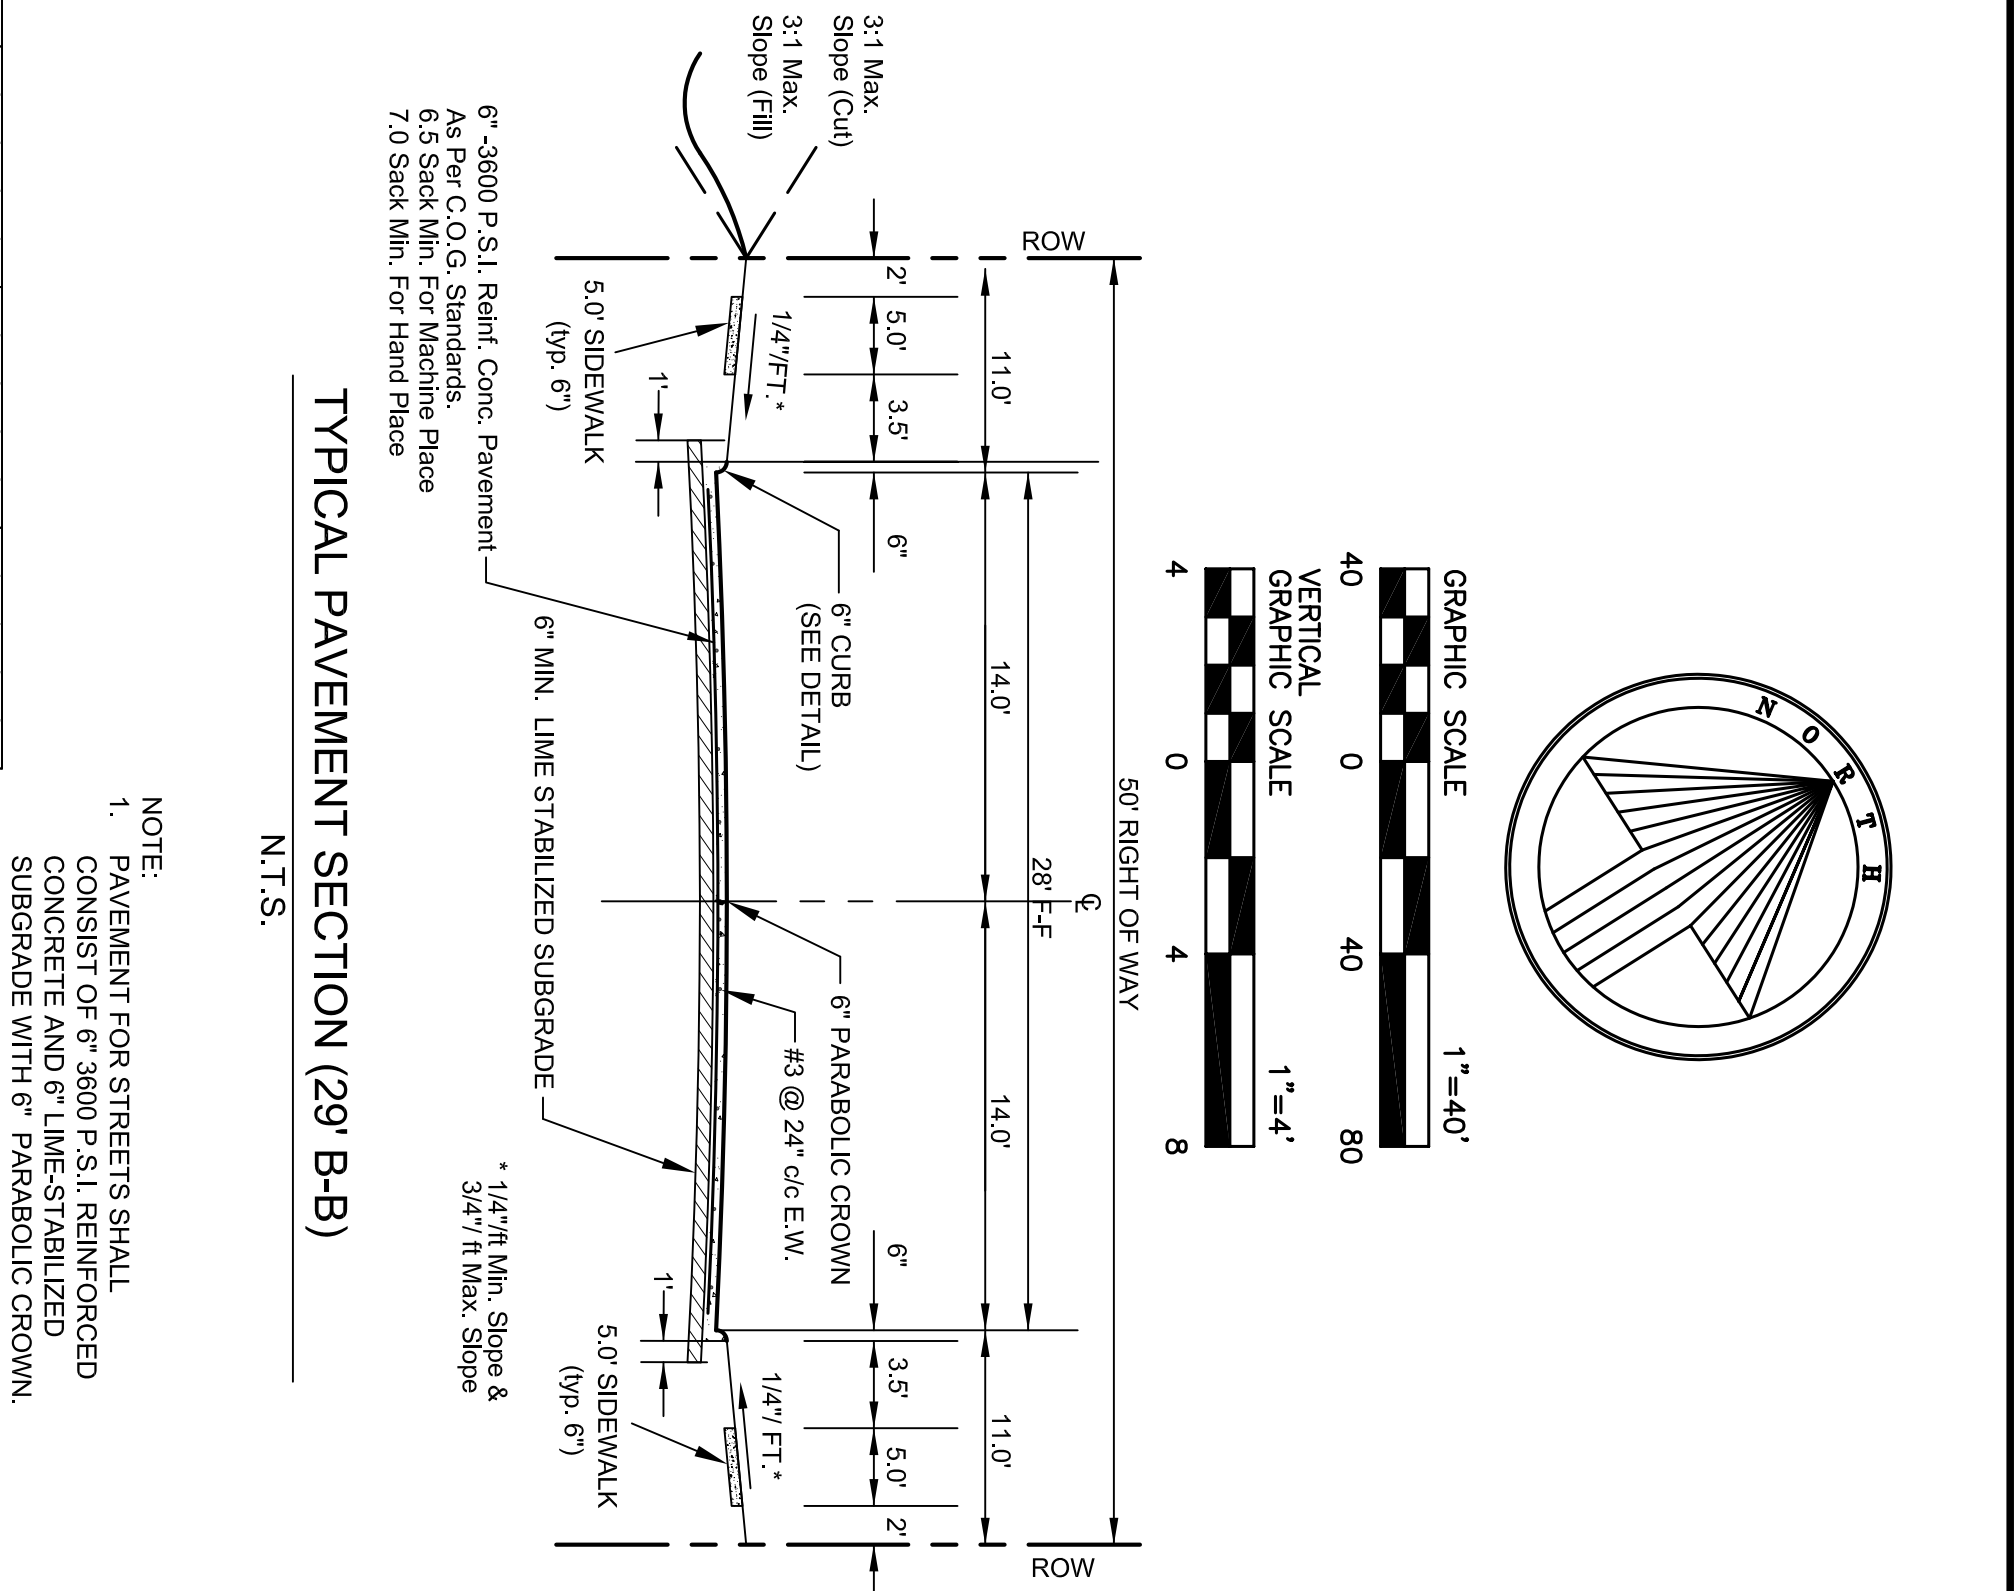


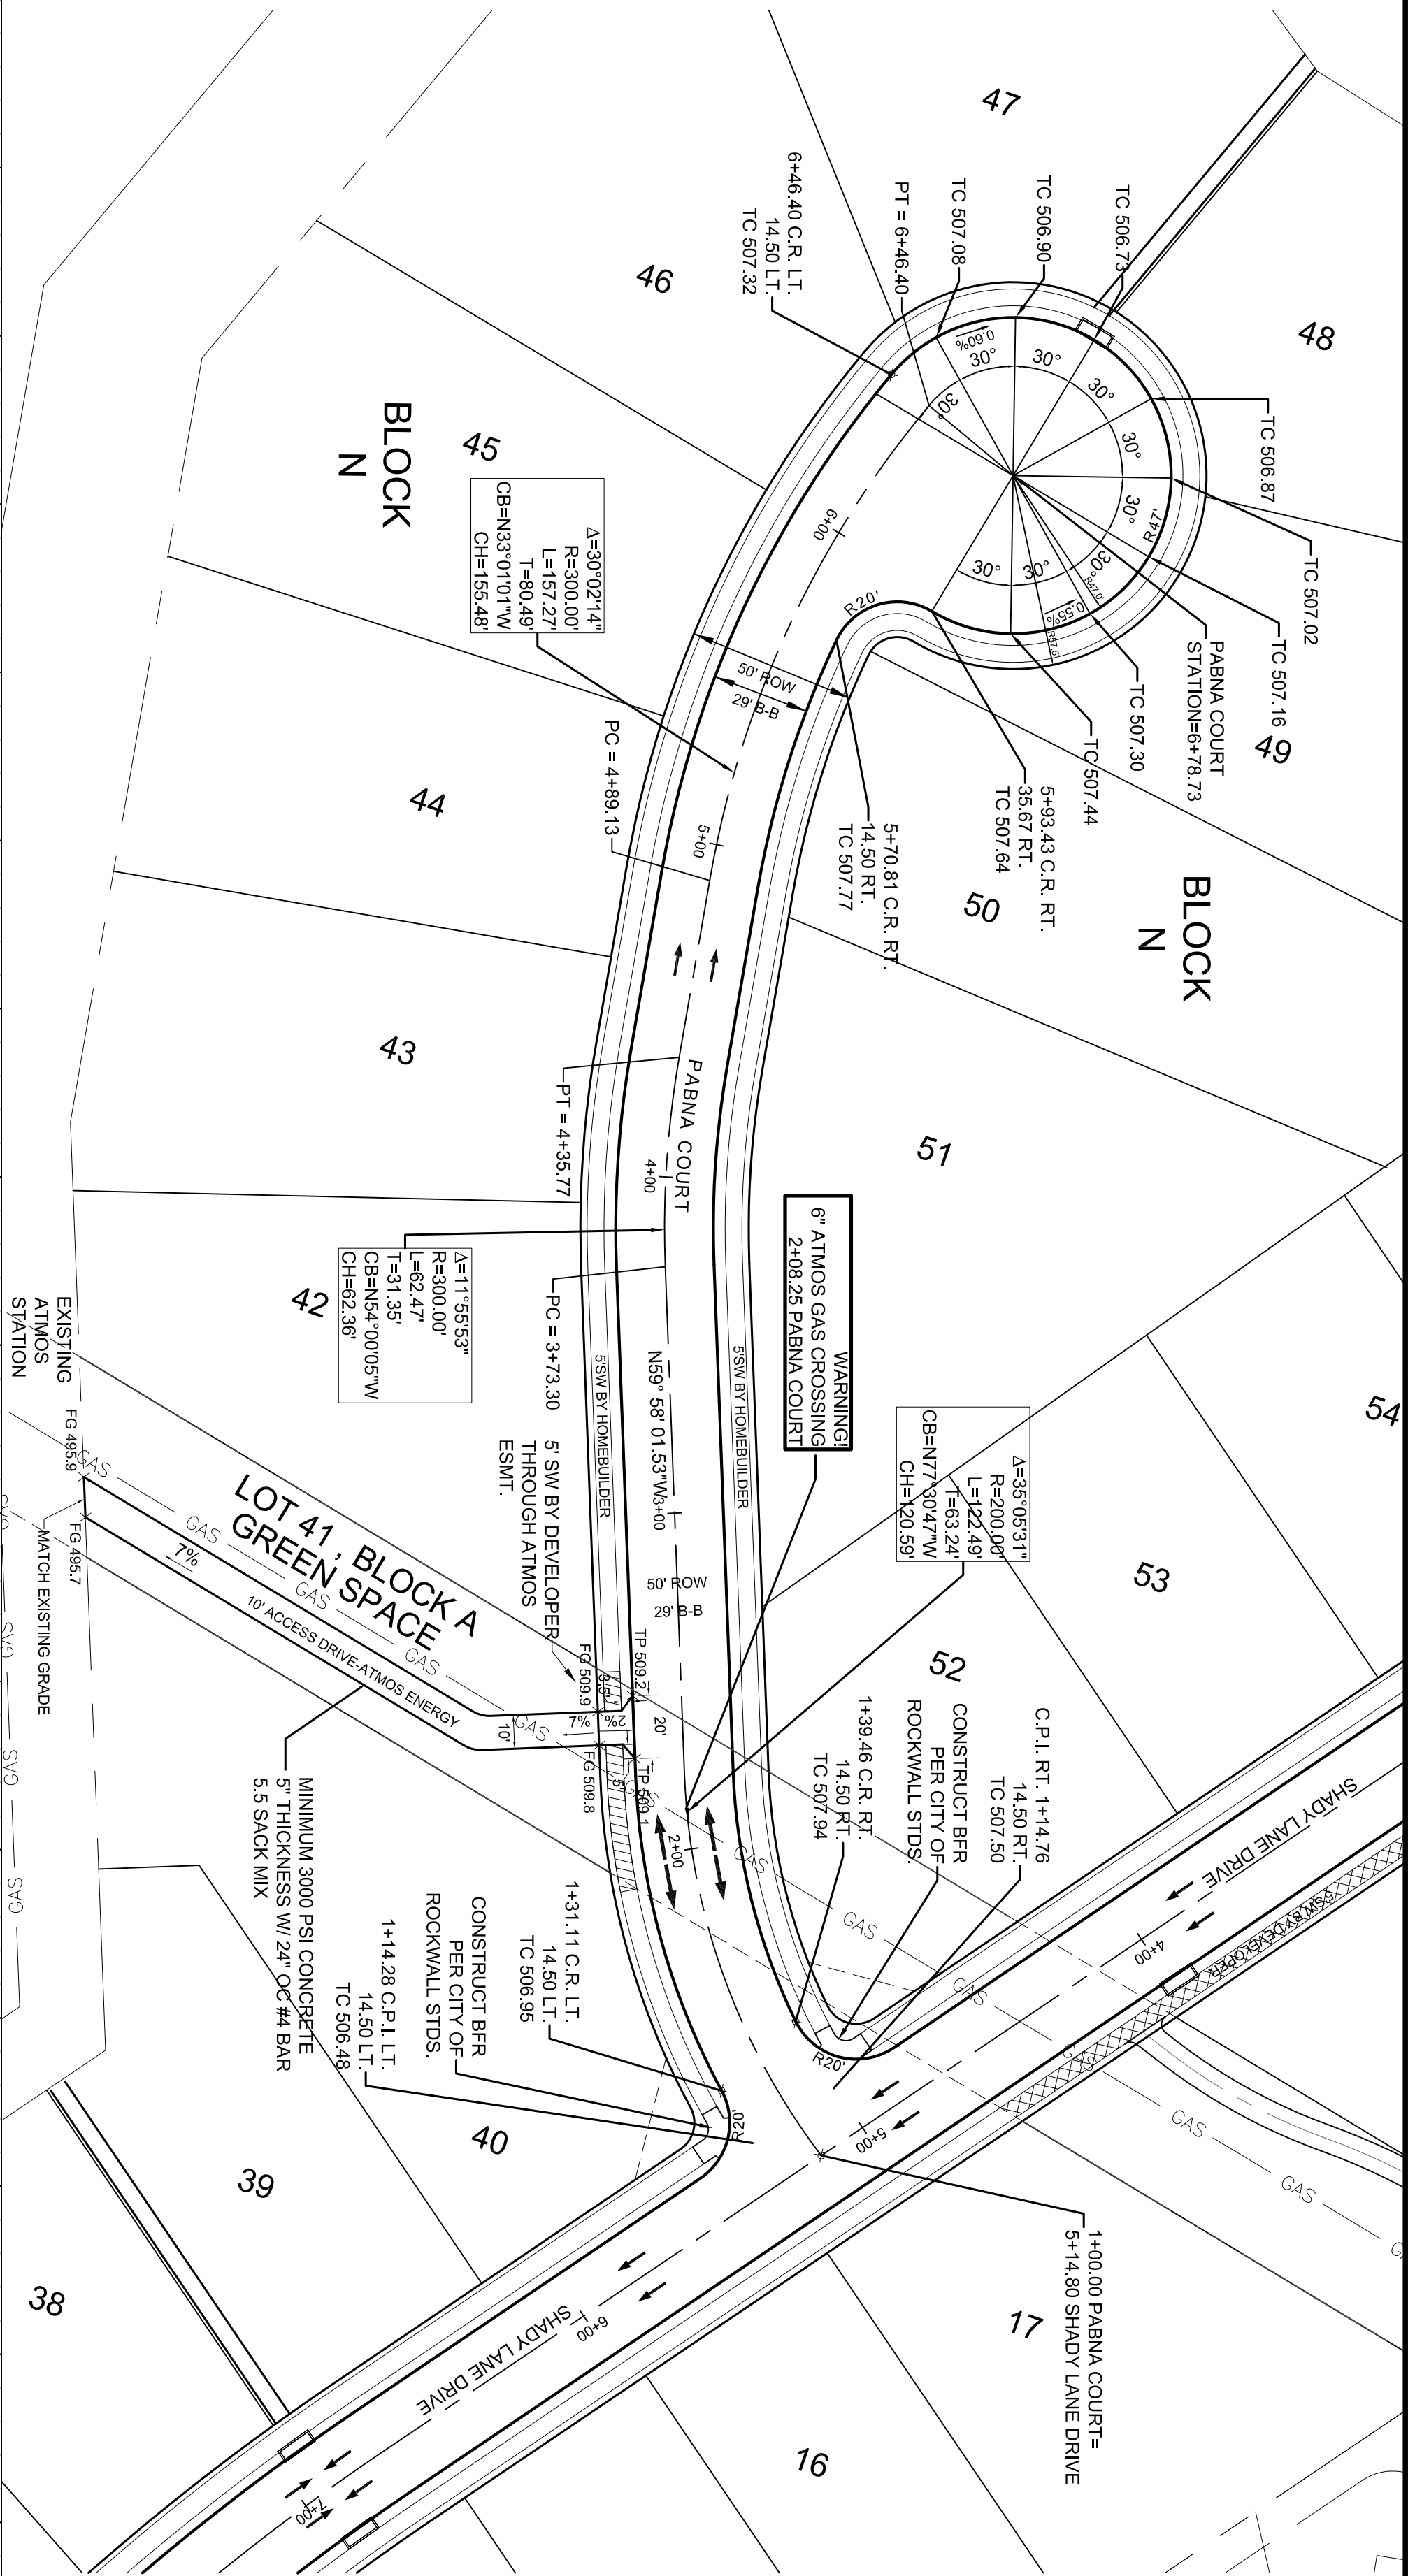

BENCHMARKS

1. X-Installed in C.I. of Alley East of Morningstar Drive within the third lot north of Midnight Pass.
Elevation = 513.28

2. PK Nail in C.I. of Caruth Lane & Alley Intersection
150 feet E. east of Morningstar Drive.
Elevation = 491.68


NO.	REVISIONS DURING CONSTRUCTION	BY	DATE
1.	MODIFIED PROFILE GRADES	DD	07/31/14

AS-BUILT DRAWING

TO THE BEST OF JBI PARTNERS, INC.'S KNOWLEDGE HEREBY STATES THIS PLAN IS AS-BUILT. THE INFORMATION PROVIDED IS BASED ON INFORMATION PROVIDED BY THE CONTRACTOR.

NAME: *DD*

DATE: 06-04-2015

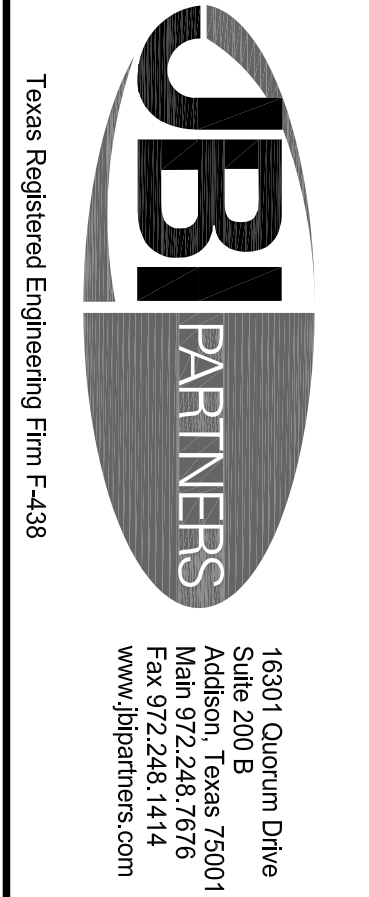

PAVING PLAN & PROFILE		PROJECT NO.
PABNA COURT		HOE132F
Caruth Lakes Phase 8B		SHEET NO.
City of Rockwall, Texas		10

ALL RESPONSIBILITY FOR ADEQUACY OF DESIGN REMAINS WITH THE DESIGN ENGINEER. THE DESIGNER'S PLANS FOR CONSTRUCTION ASSUMES NO RESPONSIBILITY FOR ADEQUACY OR ACCURACY OF DESIGN.

- NOTE:
- PAVEMENT FOR STREETS SHALL CONSIST OF 6" 3800 P.S.I. REINFORCED CONCRETE AND 6" LIME-STABILIZED SUBGRADE WITH 6" PARABOLIC CROWN. PAVEMENT FOR ALLEYS SHALL CONSIST OF 4000 P.S.I. REINFORCED CONCRETE AND 6" LIME-STABILIZED SUBGRADE WITH 5" INVERT. TYPICAL ALLEY SECTION WILL BE 7'-5.7". CONTRACTOR TO FOLLOW THESE BEFORE CONSTRUCTION.