


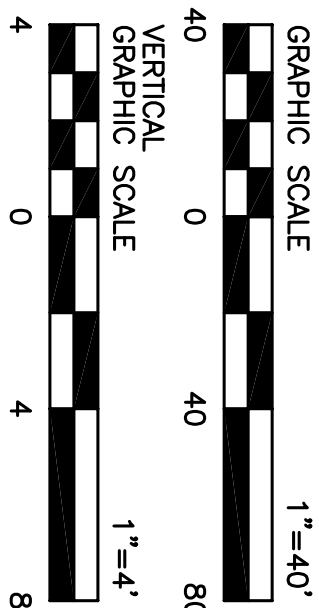

ALL RESPONSIBILITY FOR ADEQUACY OF DESIGN REMAINS WITH THE DESIGN ENGINEER. THE CITY OF ROCKWALL, IN REVIEWING AND RELEASING PLANS FOR CONSTRUCTION, ASSUMES NO RESPONSIBILITY FOR ADEQUACY OR ACCURACY OF DESIGN.

Drawing: H:\Projects\HOE132F\DWG\AS-BUILTS\17-8B STORM SEWER PLAN & PROFILE LINE A2.dwg Saved By: ychoi Save Time: 4/20/2015 3:11 PM

Plotted by: Iradley Plot Date: 6/4/2015 10:08 AM