
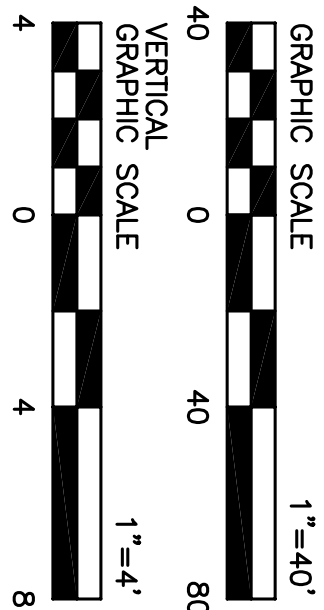


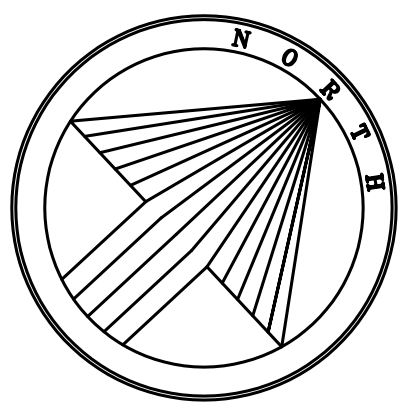

ALL STORM SEWER PIPE SHALL BE CLASS III REINFORCED CONCRETE PIPE.


ALL RESPONSIBILITY FOR ADEQUACY OF DESIGN SHALL REMAIN WITH THE DESIGN ENGINEER. THE CITY OF ROCKWALL IN REVIEWING AND RELEASING PLANS FOR CONSTRUCTION ASSUMES NO RESPONSIBILITY FOR ADEQUACY OR ACCURACY OF DESIGN.

STORM PLAN & PROFILE

STM C

Caruth Lakes Phase 8B

City of Rockwall, Texas

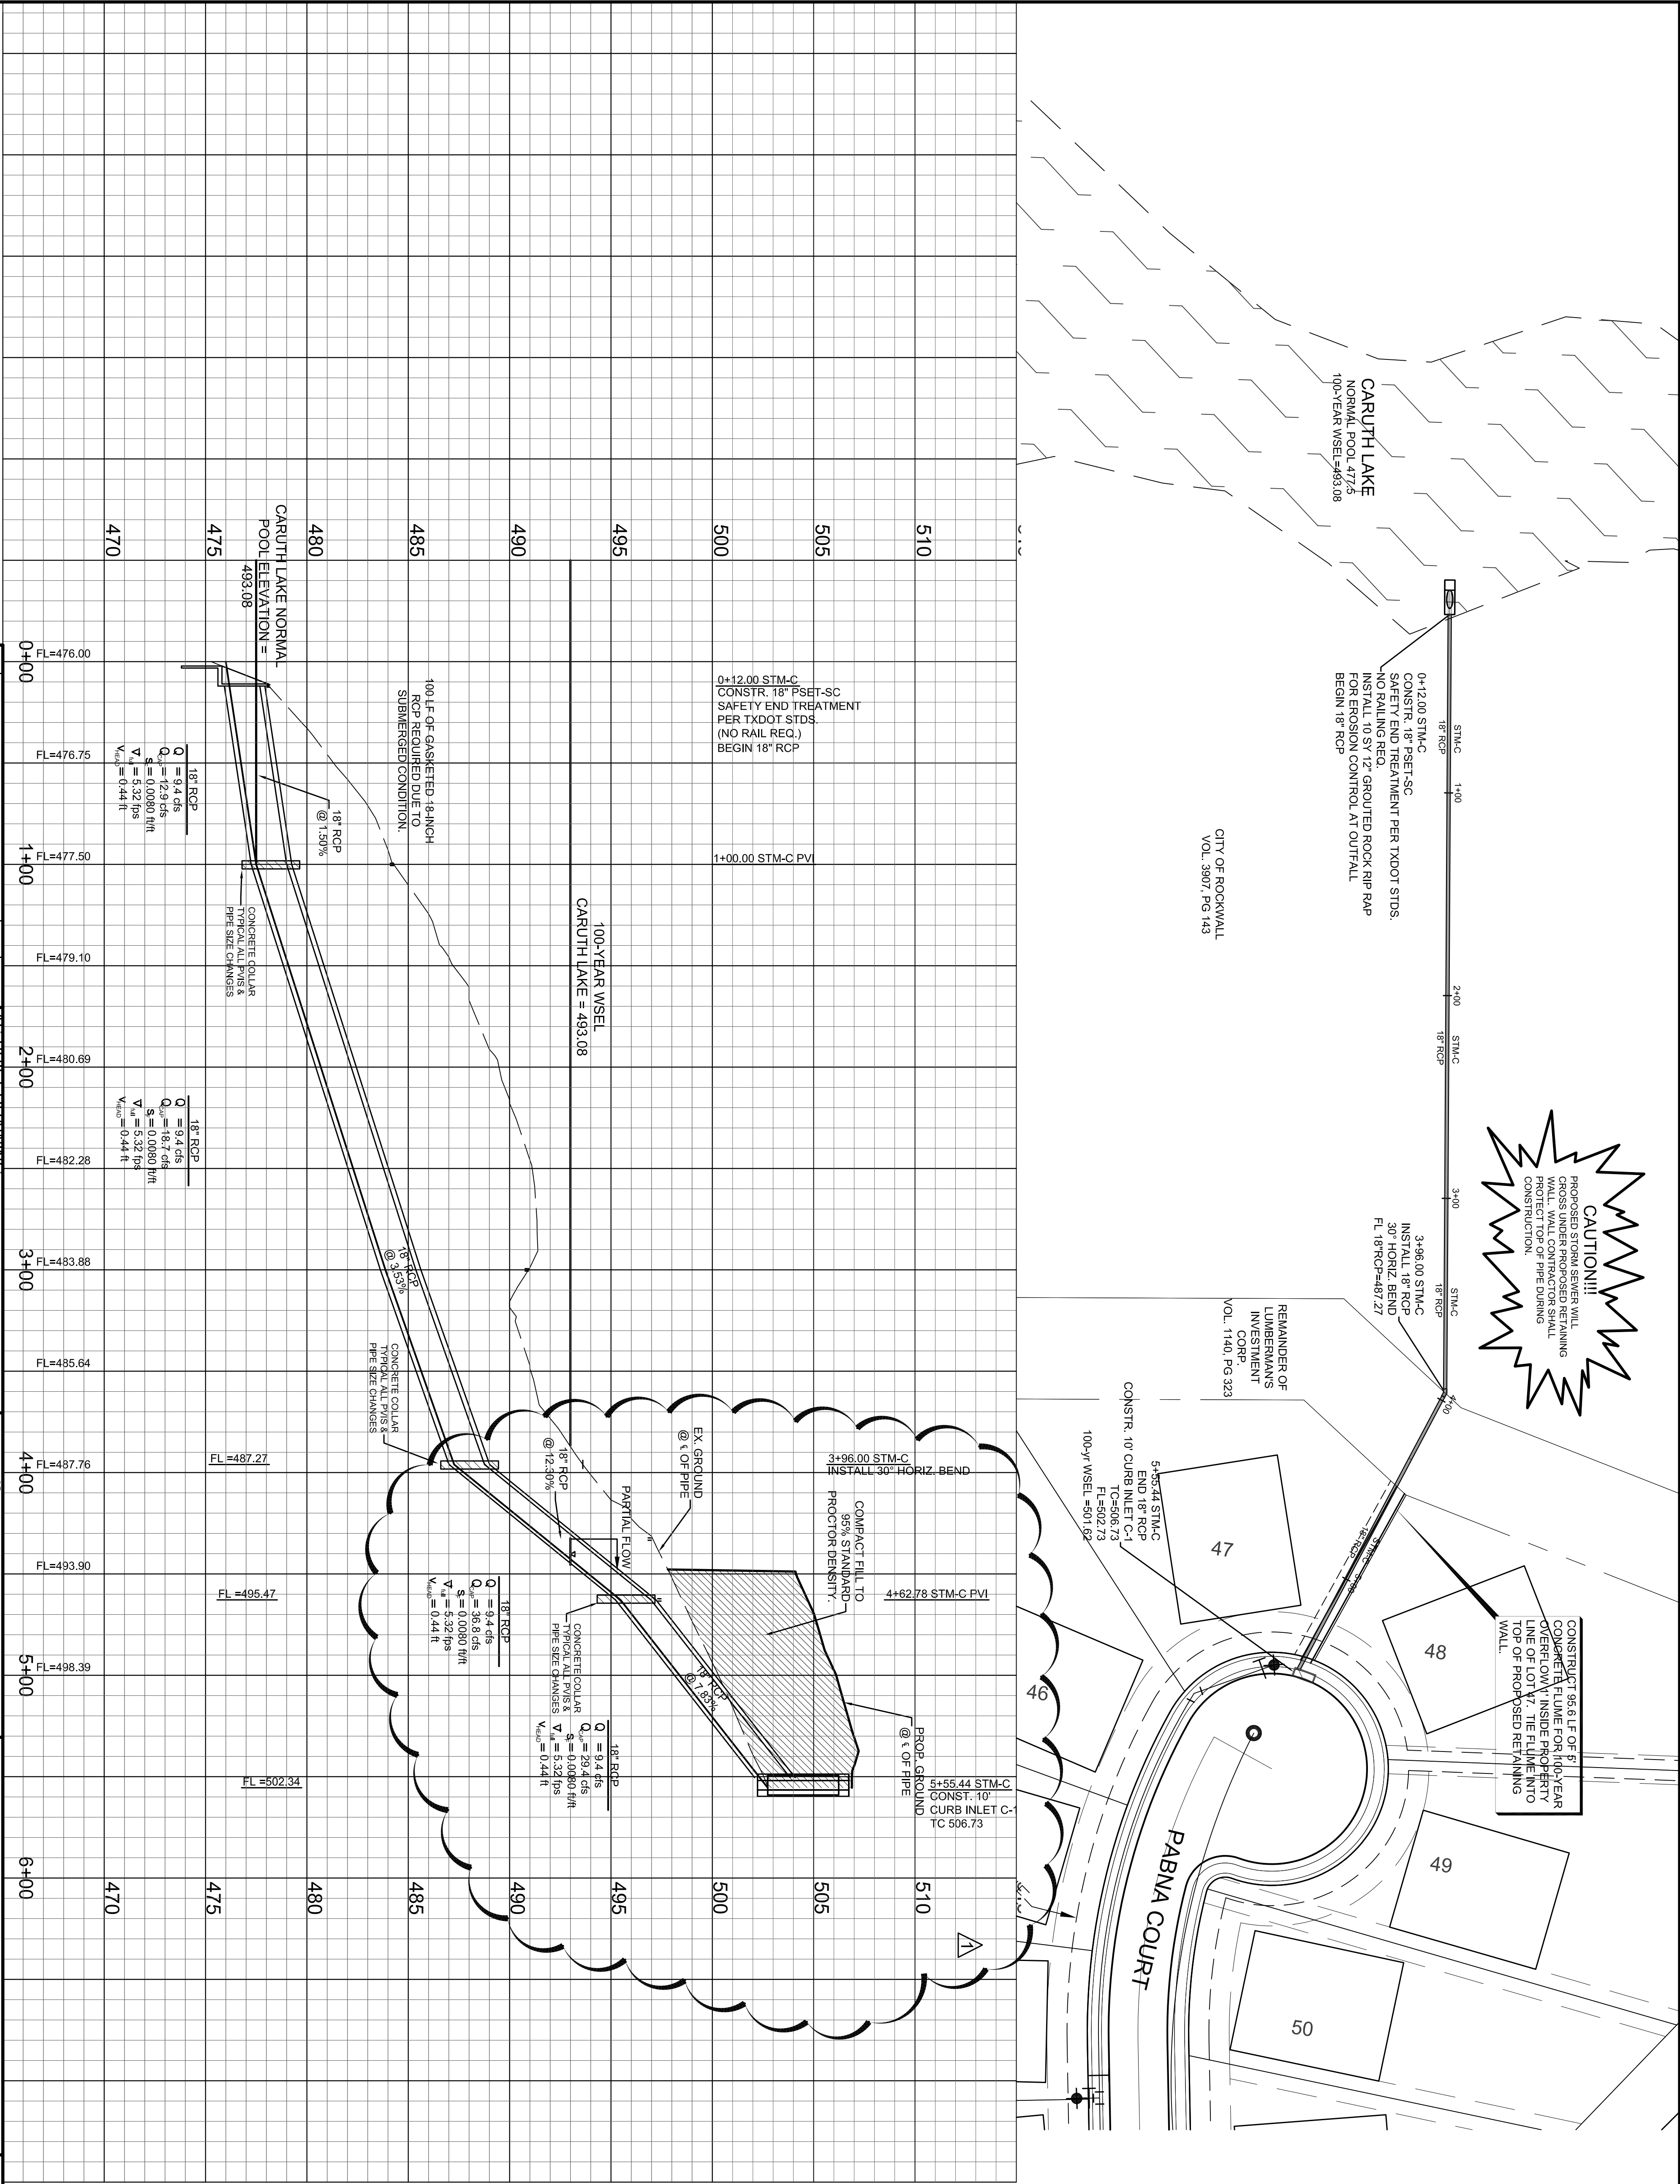

BENCHMARKS

1. X-Marked in CL of Alley East of Morningstar Drive
Within the third lot north of Midnight Pass.
Elevation = 515.28

2. PK Nail in CL of Caruth Lane & Alley Intersection
150 feet +/- east of Morningstar Drive.
Elevation = 491.68

NO.	REVISIONS DURING CONSTRUCTION	BY	DATE
1.	MODIFIED STORM PROFILE	DD	07/31/14

TO THE BEST OF JBI PARTNERS, INC. KNOWLEDGE HEREBY STATES THIS PLAN IS AS-BUILT. THE INFORMATION PROVIDED IS BASED ON CONSTRUCTION STAKING AND FLD VERIFICATION AT THE SITE AND INFORMATION PROVIDED BY THE CONTRACTOR.

NAME: *DD*

DATE: 06-04-2015

The seal appearing on this document was authorized by DANIEL DEWEY, P.E. 93961. Alteration of a sealed document without proper notification to the responsible engineer is an Engineering Practice Act.

07-31-2014



PROJECT NO. HOE132F

SHEET NO. 19