


B.M. ~ "1" CUT ON EAST TOP OF CURB AT THE END OF HOLDEN DRIVE BEING N.E. A DISTANCE OF 21' FROM THE CENTERLINE INTERSECTION OF HOLDEN DRIVE AND HUNT LANE  
ELEVATION 508.49

B.M. ~ "2" CUT IN THE NORTH SIDE OF ALLEY IN THE MIDDLE OF LOT 17 OF HARLAN PARK PHASE 1  
ELEVATION 513.23

**AS BUILT PLANS**  
05/11/07

The alignment and grade were set on the ground for construction per the plans. The engineer did not verify alignment or grades after construction. We are not aware of any changes or revisions to these plans during construction except as noted.

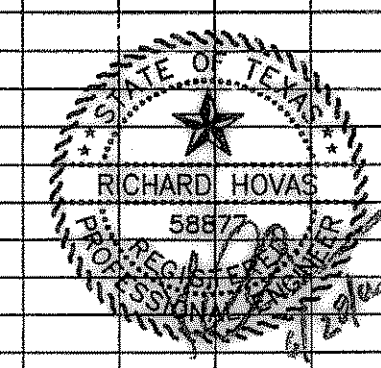

PAVING PLAN					
CASTLE RIDGE ESTATES PHASE 1					
CITY OF ROCKWALL, TEXAS					
TIPTON ENGINEERING, INC.					
ENGINEERING • SURVEYING • PLANNING					
6330 Broadway Blvd. • Suite C • Garland, Texas 75043 • (972) 228-2987					
DESIGN	DRAWN	DATE	SCALE	NOTES	FILE
TE, Inc.	TE, Inc.	10-13-05	1"=40' H. 1"=5' V.	TE, Inc.	4802
					<b>4</b>