
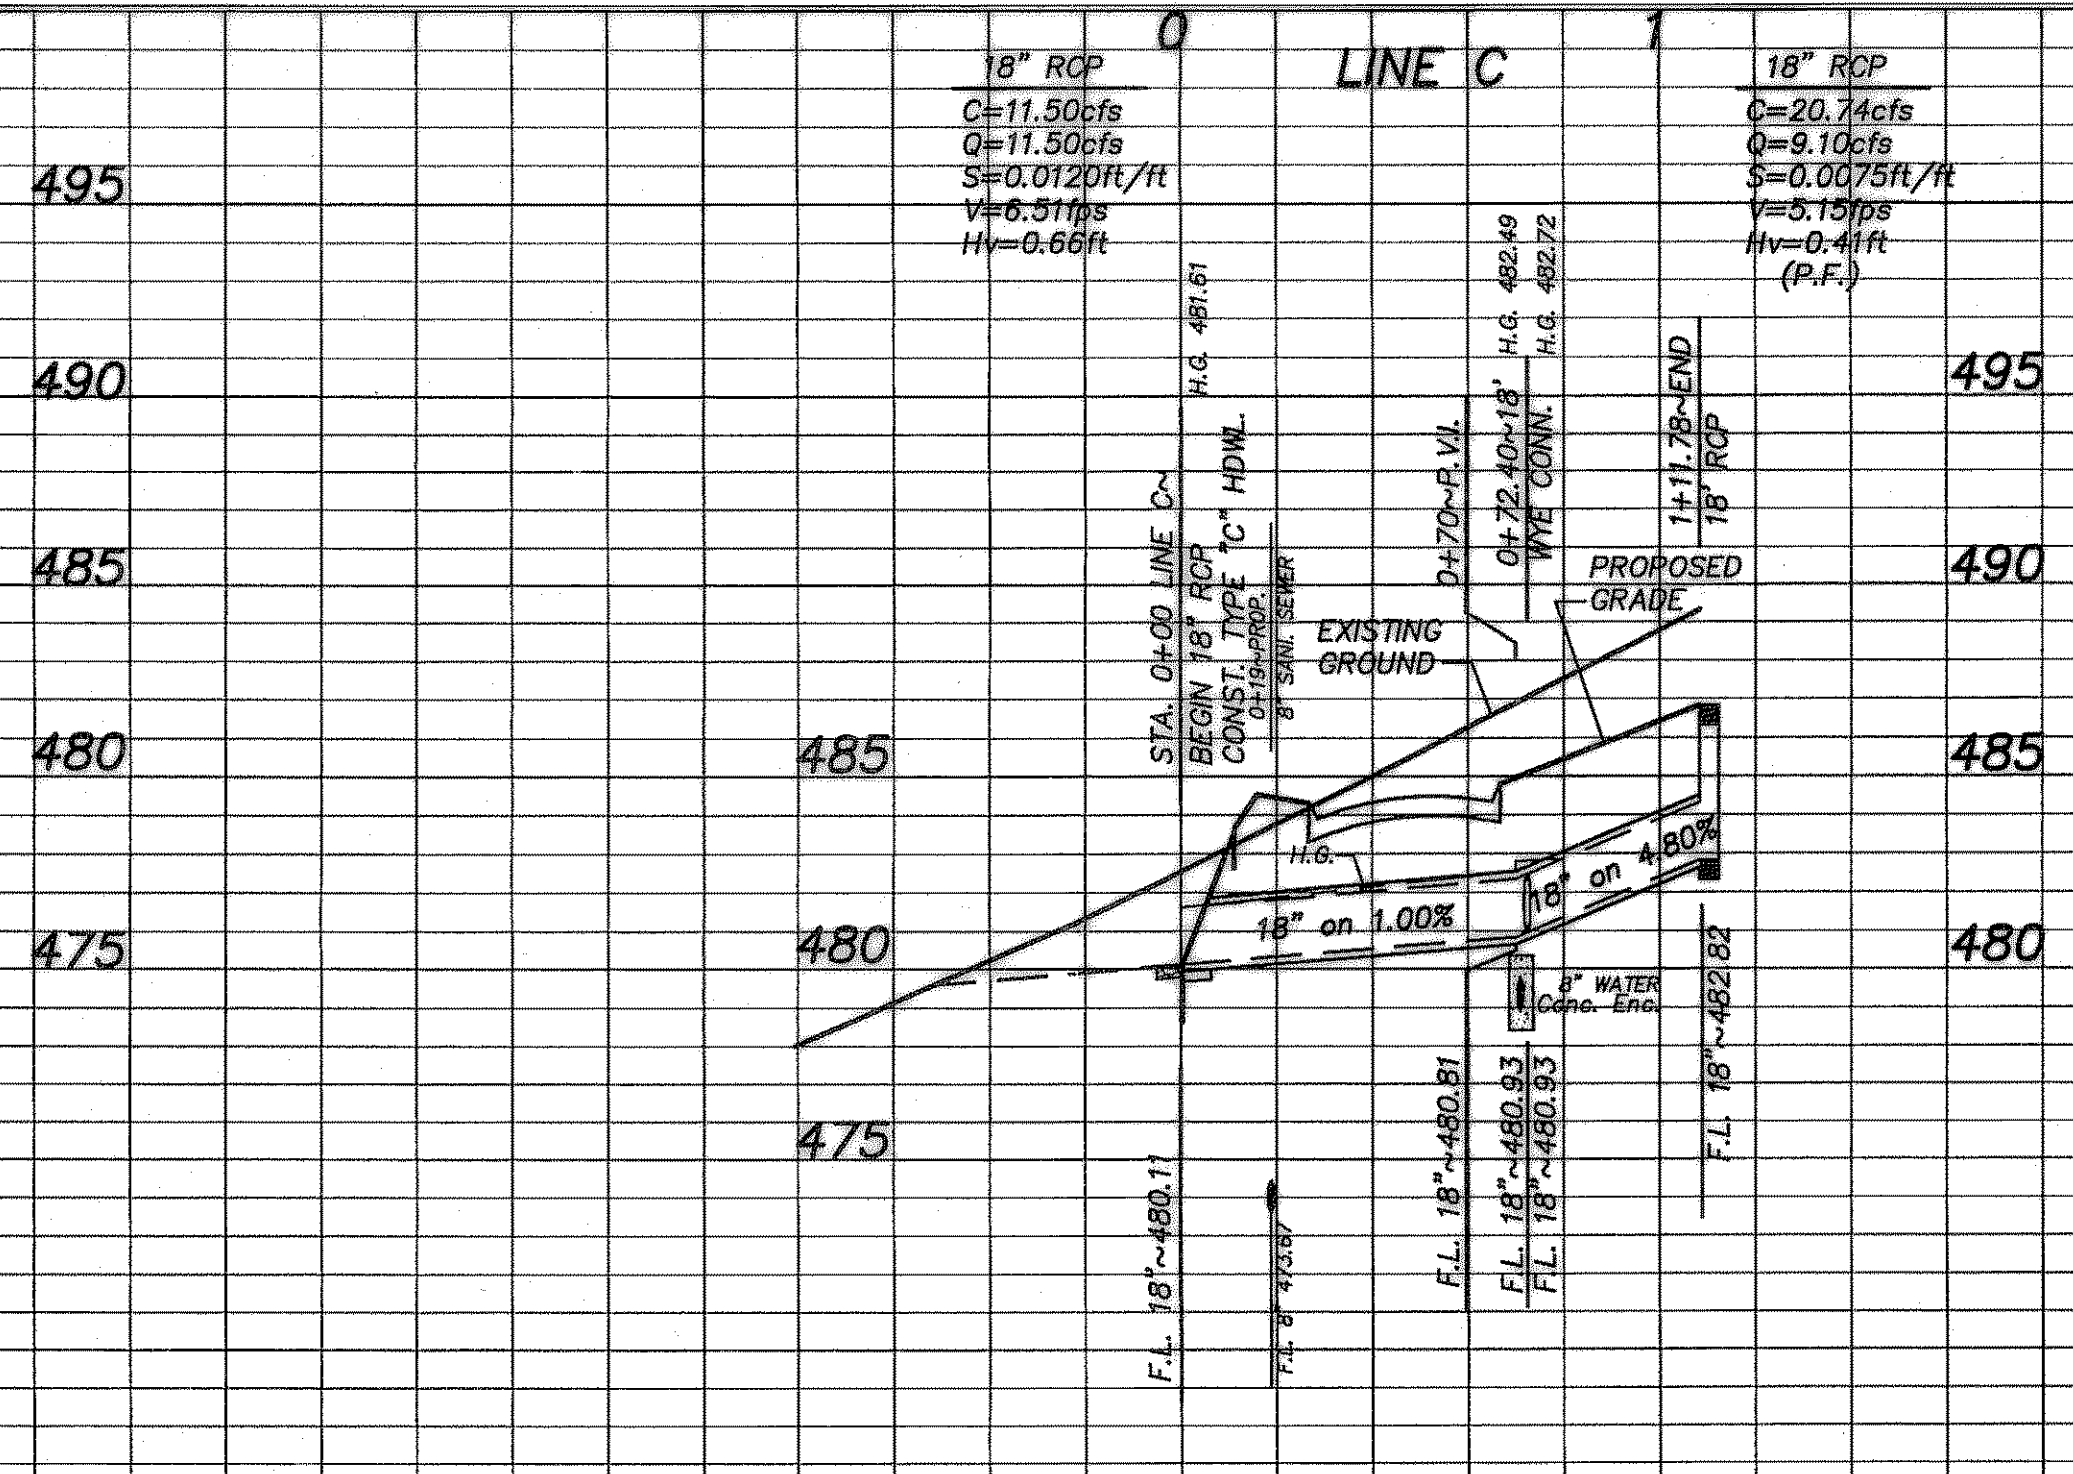


PRIOR TO CUTTING SWALE~ CONTRACTOR TO MEET WITH ENGINEER TO DETERMINE FINAL ALIGNMENT

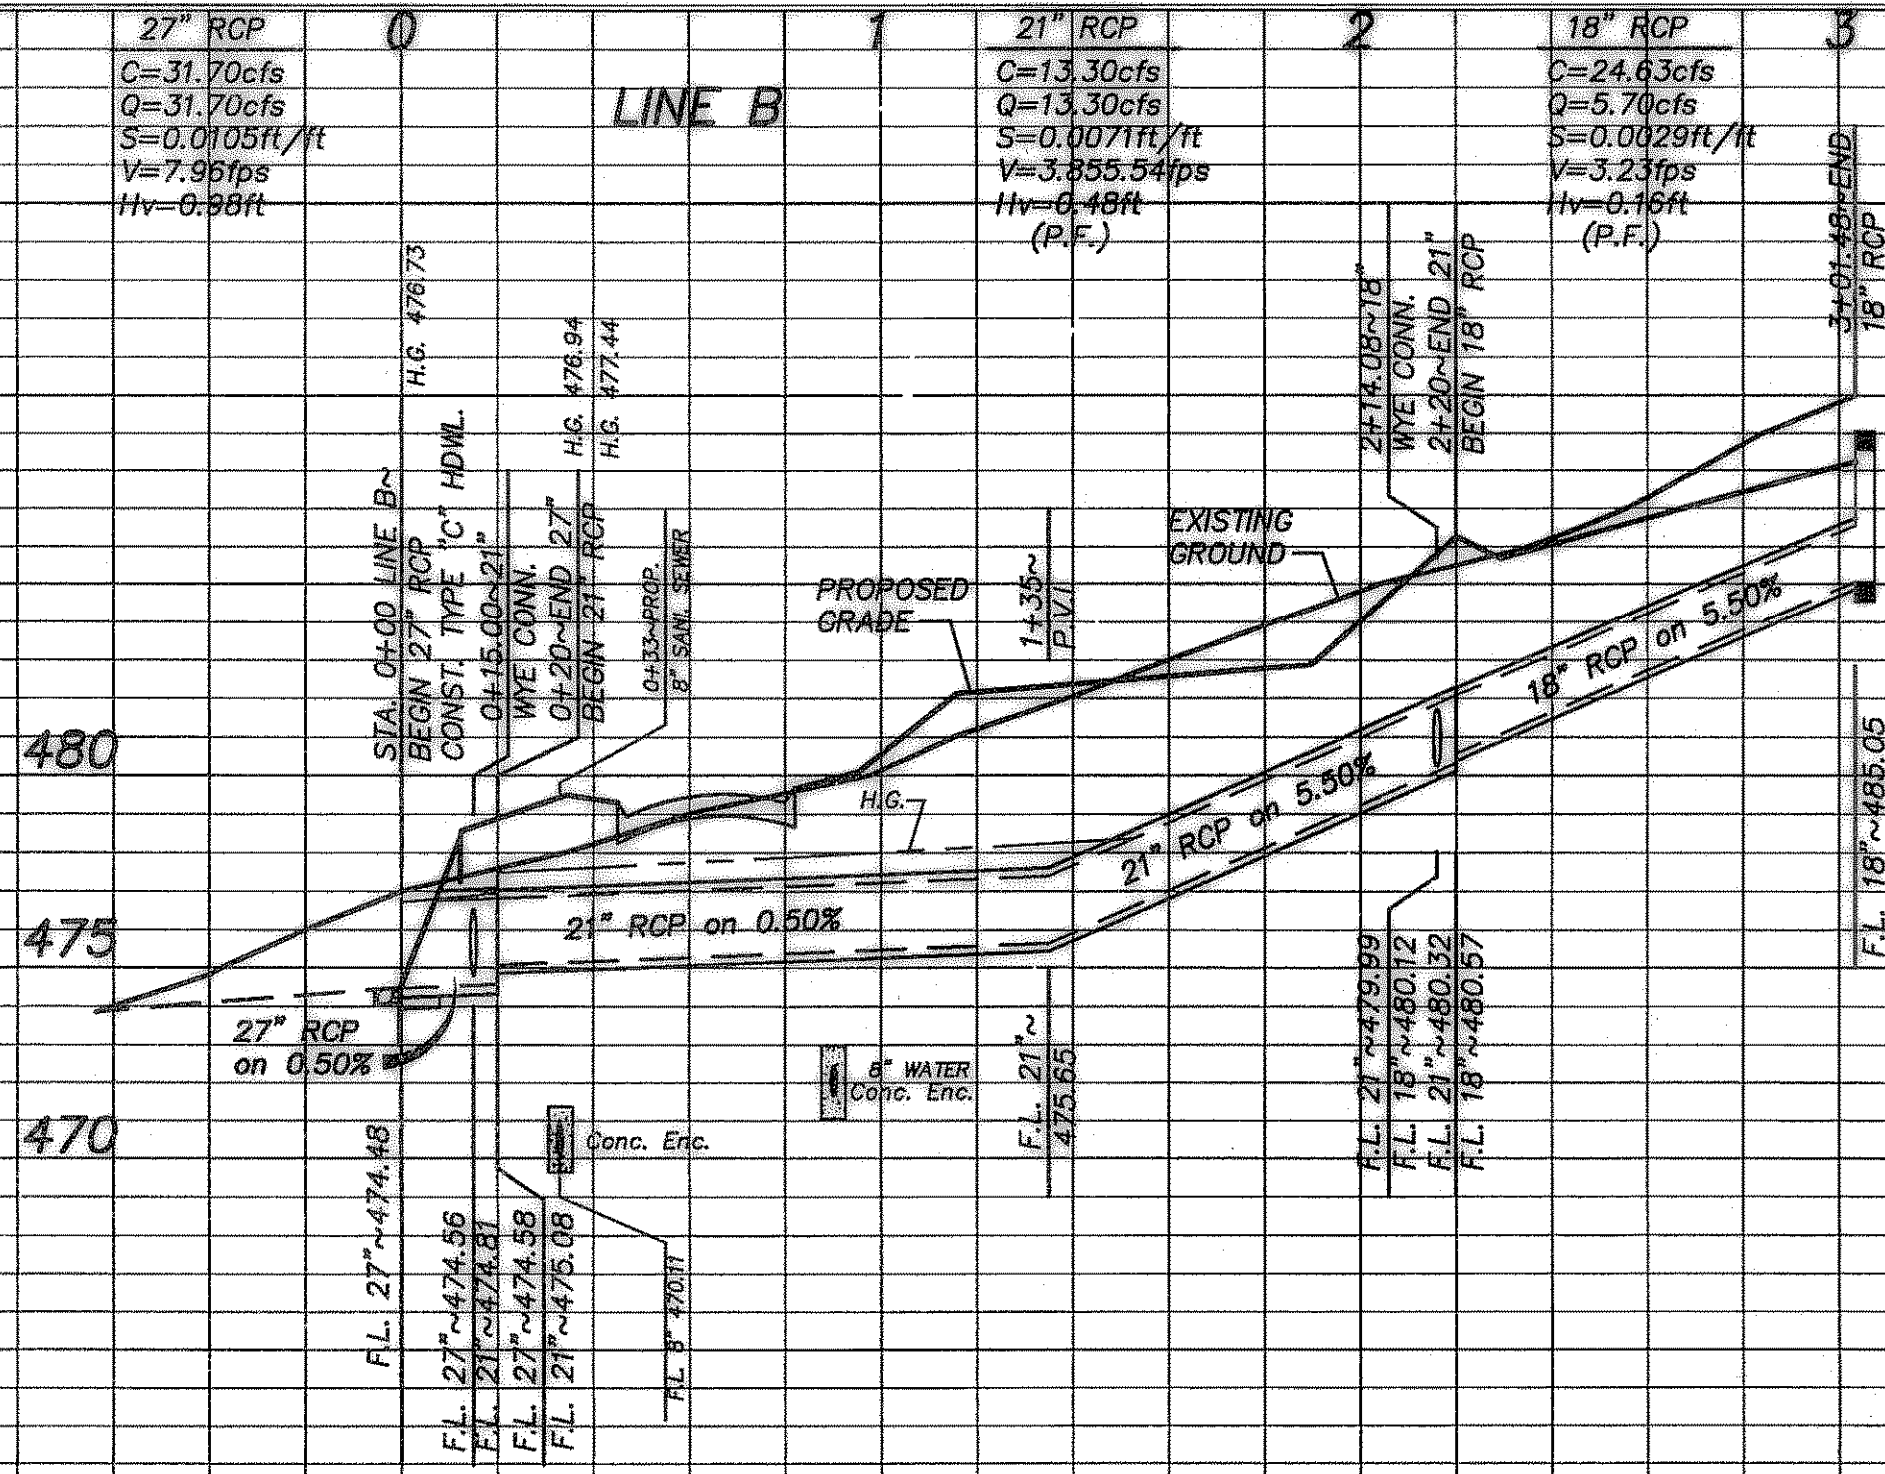

B.M. ~ 1" CUT ON EAST TOP OF CURB AT THE END OF HOLDEN DRIVE BEING N31°E A DISTANCE OF 27' FROM THE CENTERLINE INTERSECTION OF HOLDEN DRIVE AND HUNT LANE. ELEVATION 508.49

B.M. ~ 1" CUT IN THE NORTH SIDE OF ALLEY IN THE MIDDLE OF LOT 17 OF HARLAN PARK PHASE 1 ELEVATION 513.23

LINES B&C

STORM SEWER PLAN
CASTLE RIDGE ESTATES PHASE 1
CITY OF ROCKWALL, TEXAS
TIPTON ENGINEERING, INC.
 ENGINEERING • SURVEYING • PLANNING
 6330 Broadway Blvd. • Suite C • Garland, Texas 75043 • (972) 226-2967

DESIGN	DRAWN	DATE	SCALE	NOTES	FILE	NO.
TE, Inc.	TE, Inc.	10-13-05	1"=40' H. 1"=5' V.	TE, Inc.	4802	11

AS BUILT PLANS
05/11/07

ALL STORM SEWER TO BE R.C.P.

The alignment and grade were set on the ground for construction per the plans. The engineer did not verify alignment or grades after construction. We are not aware of any changes or revisions to these plans during construction except as noted.

