

- TREE TYPE LEGEND:
TWO LETTER ABBREVIATIONS
1. BOIS-D'-ARC - BO
 2. CEDAR - CE
 3. COTTONWOOD - CW
 4. ELM - EL
 5. HACKBERRY - HA
 6. MESQUITE - ME
 7. OAK - OA
 8. PECAN - PE
 9. PERCORNION - PC
 10. PINE - PI
 11. WILLOW - WI
- EXAMPLE - 10PE (10" PECAN)
1. TWIN - TW
 2. TRIPPLE - TR
 3. CLUSTER - CL
- EXAMPLE - TWIOPE (TWIN 10" PECAN)


6,701" of Total Trees
819" of Trees to be Removed
664" of Trees to be Mitigated
477" of Trees to be Planted
on Lots (3 Trees Per Lot)
159" of 3" Trees to be Planted
in the Open Space Areas



OPEN SPACE AREA
0.95 ACRES

PRENTICE CHARLES HICKMAN
Vol. 173, Pg. 795

Tree Preservation Plan						
CASTLE RIDGE ESTATES PHASE 1						
City Of Rockwall, Texas						
TIPTON ENGINEERING, INC.						
6330 Broadway Blvd. ~ Suite C ~ Garland, Texas 75043						
DESIGN	DRAWN	DATE	SCALE	NOTES	FILE	NO.
T.E. Inc.	T.E. Inc.	1-06	1"=100'		4802	23

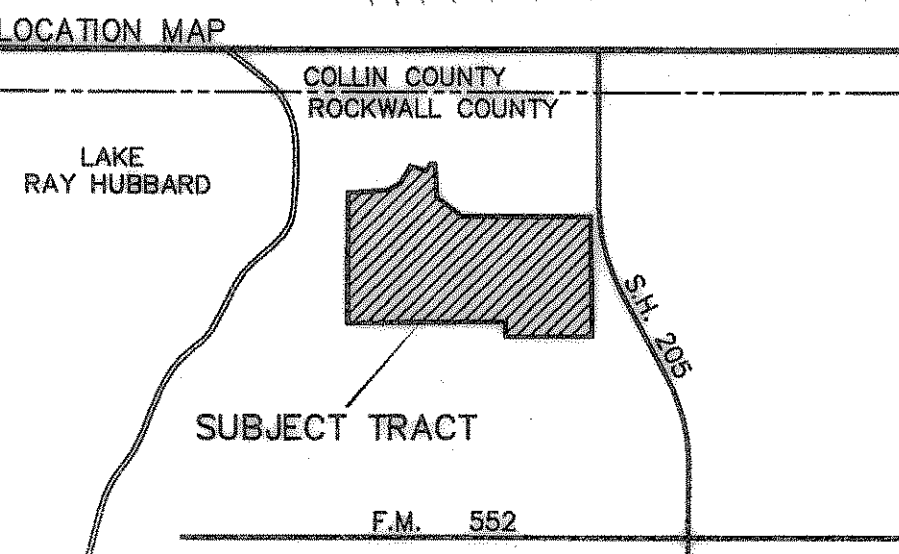

HERITAGE HEIGHTS ADDITION
Cab. B, Slide 88

AS BUILT PLANS
05/11/07

The alignment and grade were set on the ground for construction per the plans. The engineer did not verify alignment or grades after construction. We are not aware of any changes or revisions to these plans during construction except as noted.

HARLAN PARK PHASE I
Cab. B, Slide 227
SF - 10