

NOTE: NO SERVICES TO BE CONNECTED UNTIL EXISTING GROUND IS 10' OR LESS FROM SEWER.

**CAUTION !!!**  
EXISTING UTILITIES

EXISTING UTILITIES AND UNDERGROUND FACILITIES INDICATED ON THESE PLANS HAVE BEEN LOCATED FROM REFERENCE INFORMATION. IT SHALL BE THE RESPONSIBILITY OF THE CONTRACTOR TO VERIFY BOTH HORIZONTALLY AND VERTICALLY THE LOCATION OF ALL EXISTING UTILITIES AND UNDERGROUND FACILITIES PRIOR TO CONSTRUCTION. TO TAKE NECESSARY PRECAUTIONS IN ORDER TO PROTECT ALL FACILITIES ENCOUNTERED. THE CONTRACTOR SHALL PRESERVE AND PROTECT ALL EXISTING UTILITIES FROM DAMAGE DURING CONSTRUCTION.


LINES A B & C

B.M. " " CUT ON EAST TOP OF CURB AT THE END OF HOLDEN DRIVE BEING N31° E A DISTANCE OF 27' FROM THE CENTERLINE INTERSECTION OF HOLDEN DRIVE AND HUNT LANE. ELEVATION 508.49

B.M. " " CUT IN THE NORTH SIDE OF ALLEY IN THE MIDDLE OF LOT 17 OF HARLAN PARK PHASE 1. ELEVATION 513.23

AS BUILT PLANS  
05/11/07

The alignment and grade were set on the ground for construction per the plans. The engineer did not verify alignment or grades after construction. We are not aware of any changes or revisions to these plans during construction except as noted.

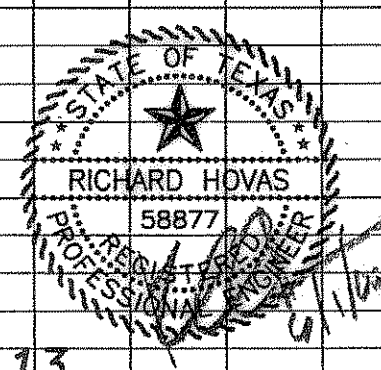

**SANITARY SEWER PROFILES**  
CASTLE RIDGE ESTATES PHASE 1  
CITY OF ROCKWALL, TEXAS

**TIPTON ENGINEERING, INC.**  
ENGINEERING • SURVEYING • PLANNING  
6330 Broadway Blvd. • Suite C • Garland, Texas 75043 • (972) 226-2967

| DESIGN   | DRAWN    | DATE  | SCALE                  | NOTES    | FILE | NO. |
|----------|----------|-------|------------------------|----------|------|-----|
| TE, Inc. | TE, Inc. | 01/06 | 1"=100' H.<br>1"=5' V. | TE, Inc. | 4802 | 15  |