




SCALE : 1" = 200'

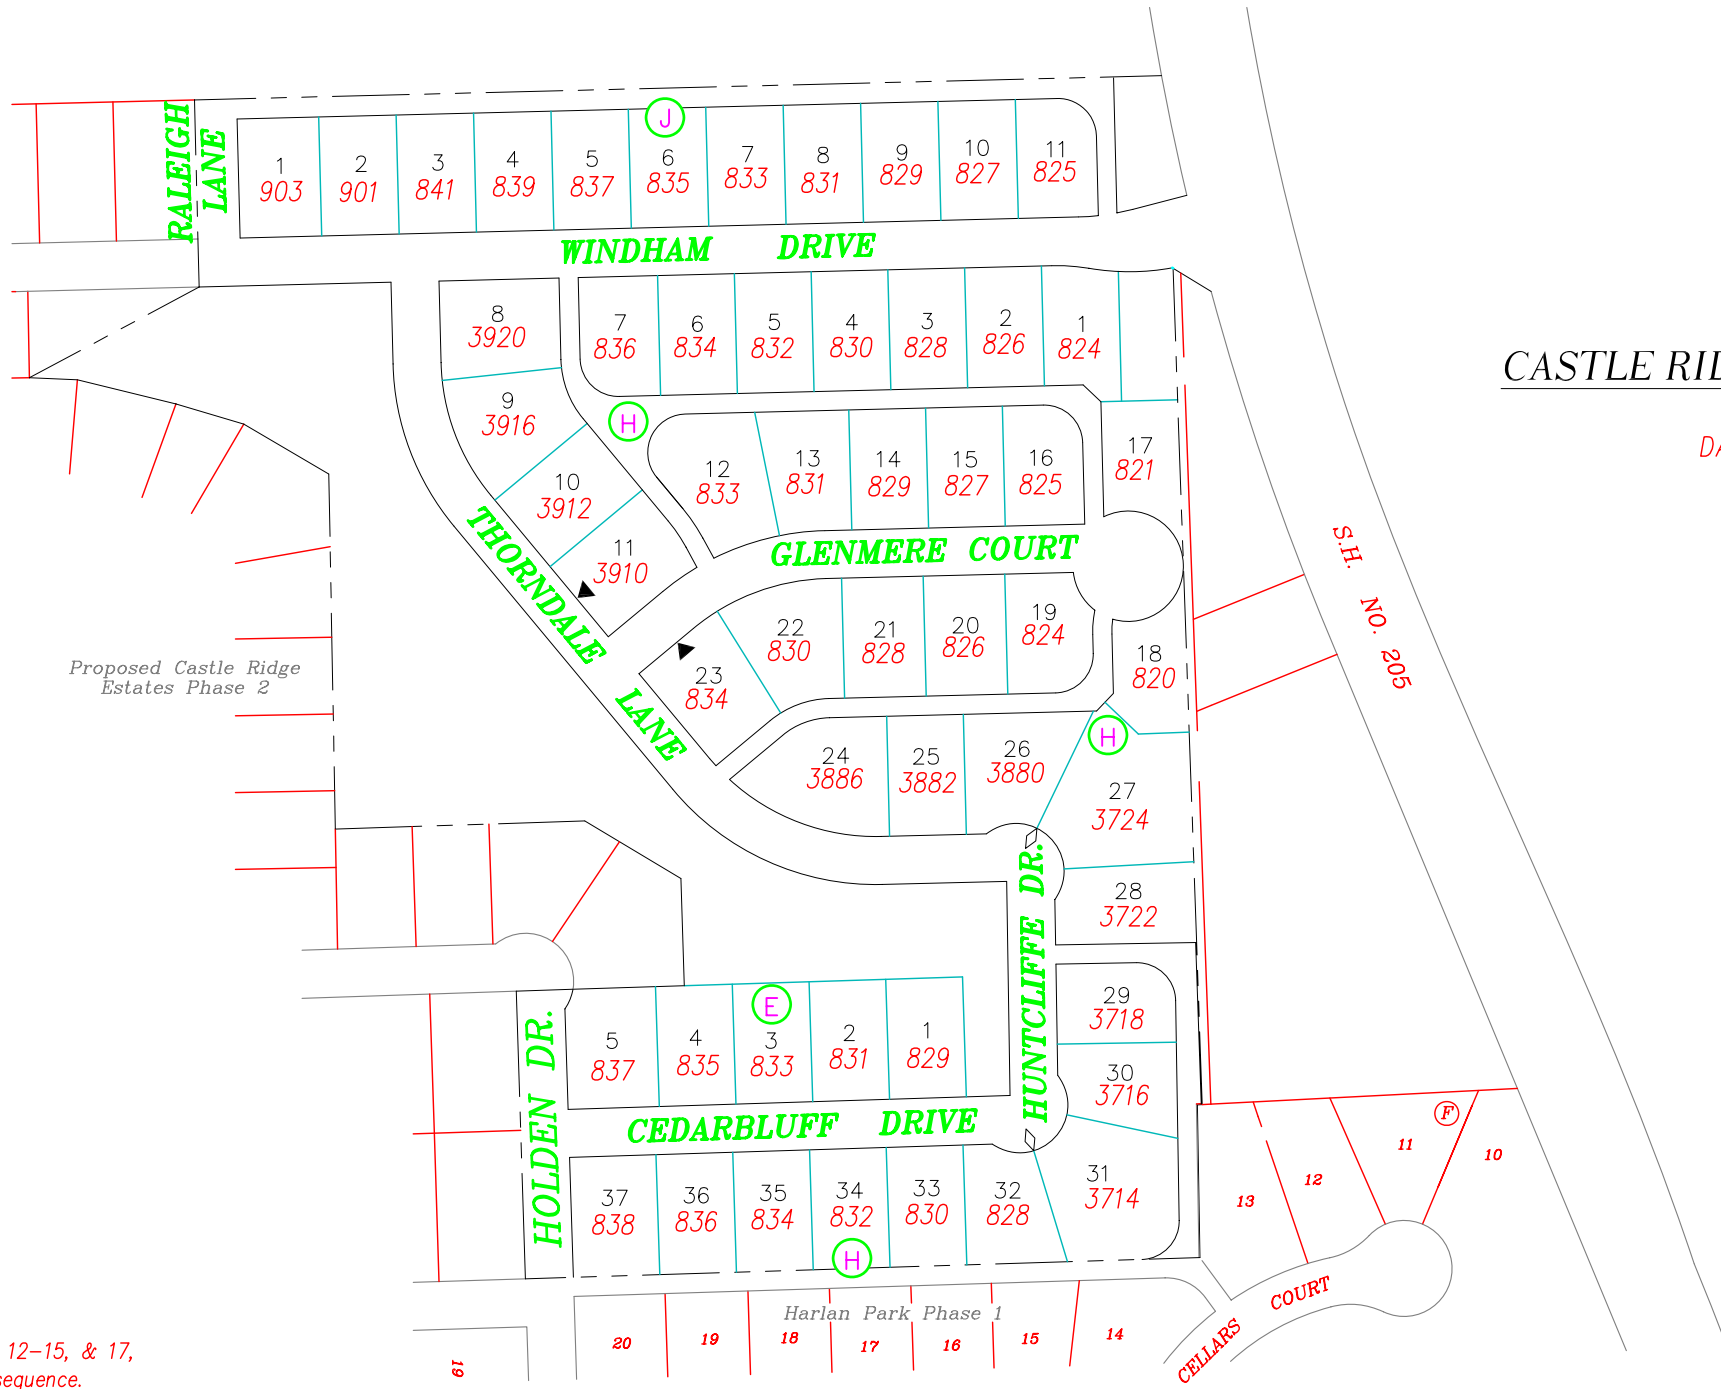

Proposed Castle Ridge Estates Phase 2

CASTLE RIDGE ESTATES PHASE 1

ADDRESS MAP

DATE: MARCH 28, 2007

53 LOTS

- LEGEND**
- 3 LOT NUMBER
 - 849 STREET ADDRESS
 - (H) CITY BLOCK NUMBER
 - ◇ STREET NAME CHANGE
 - ▲ STREET ADDRESS FACES

Rev. 4/26/07
 Changed addresses for Lots 12-15, & 17,
 Block H. Addresses out of sequence.