


B.M. "X" CUT ON EAST TOP OF CURB AT THE END OF HOLDEN DRIVE BEING 135' A DISTANCE OF 27' FROM THE CENTERLINE INTERSECTION OF HOLDEN DRIVE AND HUNT LANE. ELEVATION 508.49

B.M. "X" CUT IN THE NORTH SIDE OF ALLEY IN THE MIDDLE OF LOT 17 OF HARRAN PARK PHASE 1. ELEVATION 513.23

AS BUILT PLANS  
12/08/2008

The alignment and grade were set on the ground for construction per the plans. The engineer did not verify alignment or grades after construction. We are not aware of any changes or revisions to these plans during construction except as noted.

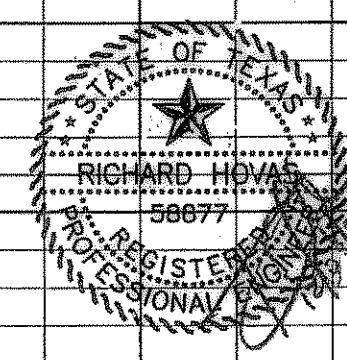

**BETTY STREET**

**PAVING PLAN**  
**CASTLE RIDGE ESTATES PHASE 2**  
**CITY OF ROCKWALL**  
**TIPTON ENGINEERING, INC.**

ENGINEERING • SURVEYING • PLANNING  
 6330 Broadway Blvd. • Suite C • Garland, Texas 75043 • (972) 226-2967

DESIGN	DRAWN	DATE	SCALE	NOTES	FILE	NO.
TE, Inc.	TE, Inc.	12-06	1"=40' H. 1"=8' V.	TE, Inc.	4803	4

4803PAV1 12/03/07