




SCALE : 1" = 200'

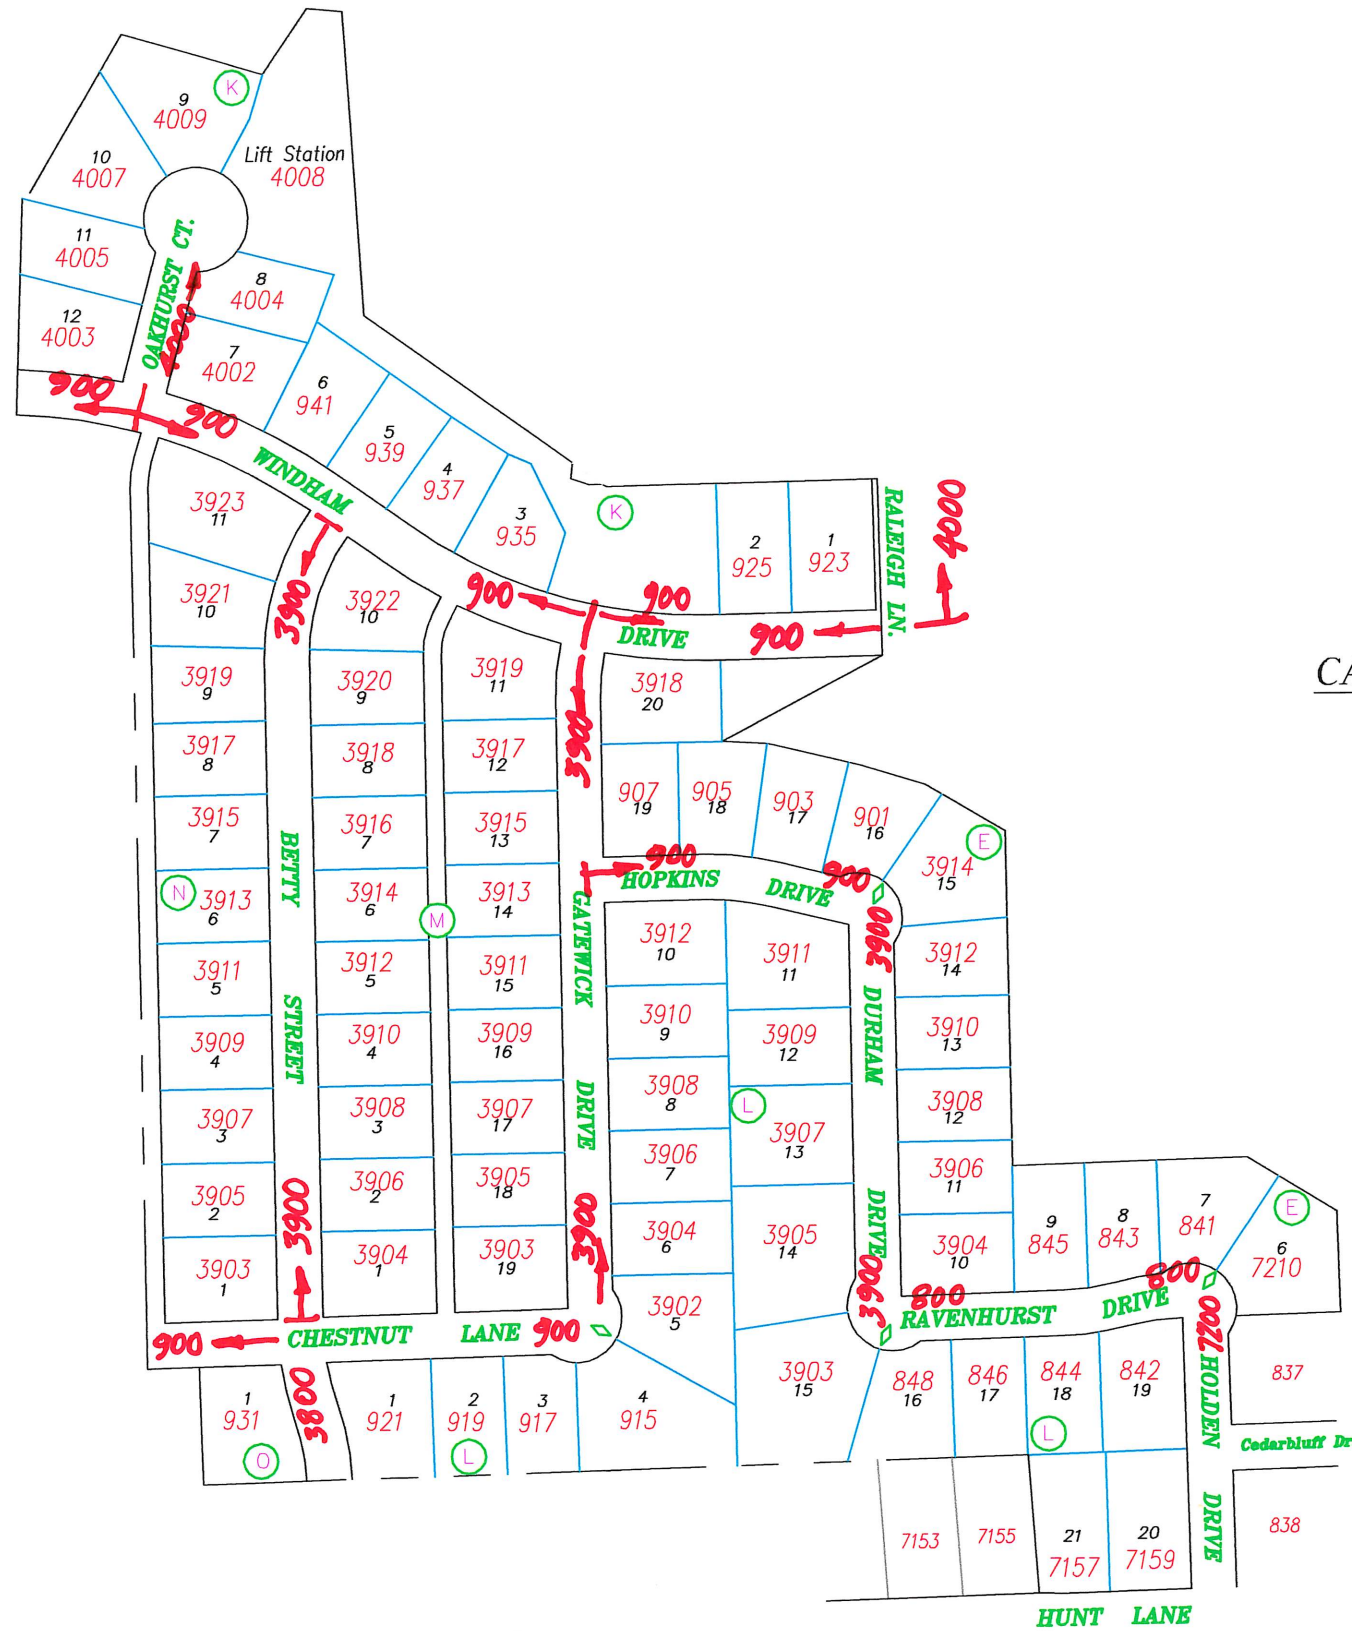

CASTLE RIDGE ESTATES PHASE 2

ADDRESS MAP

DATE: MAY 13, 2008

79 LOTS

LEGEND

3 LOT NUMBER

1250 STREET ADDRESS

(A) CITY BLOCK NUMBER

◇ STREET NAME CHANGE