


AS BUILT PLANS
12/08/2008

The alignment and grade were set on the ground for construction per the plans. The engineer did not verify alignment or grades after construction. We are not aware of any changes or revisions to these plans during construction except as noted.

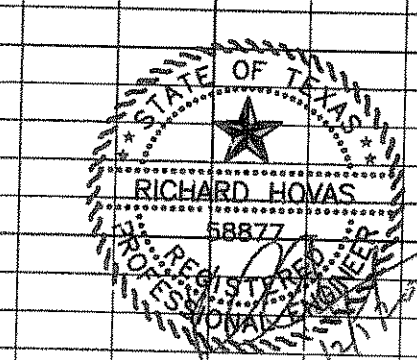

STORM SEWER PLAN
CASTLE RIDGE ESTATES PHASE 2
ROCKWALL, ROCKWALL COUNTY, TEXAS

TIPTON ENGINEERING, INC.
ENGINEERING • SURVEYING • PLANNING
6330 Broadway Blvd., Suite C • Garland, Texas 75043 • (972) 226-2987

DESIGN	DRAWN	DATE	SCALE	NOTES	FILE	NO.
TE, Inc.	TE, Inc.	12-06	1"=40' H. 1"=5' V.	TE, Inc.	4803	14