


AS BUILT PLANS
12/08/2008

The alignment and grade were set on the ground for construction per the plans. The engineer did not verify alignment or grades after construction. We are not aware of any changes or revisions to these plans during construction except as noted.

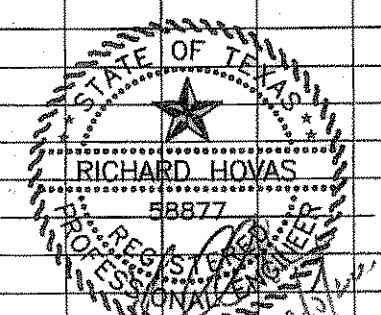

LINES D-1, D-2, & E

| STORM SEWER PLAN | | | | | | |
|---|----------|-------|-----------------------|----------|------|-----|
| CASTLE RIDGE ESTATES PHASE 2 | | | | | | |
| ROCKWALL, ROCKWALL COUNTY, TEXAS | | | | | | |
| TIPTON ENGINEERING, INC. | | | | | | |
| ENGINEERING • SURVEYING • PLANNING 6330 Broadway Blvd. • Suite C • Garland, Texas 75043 • (972) 226-2967 | | | | | | |
| DESIGN | DRAWN | DATE | SCALE | NOTES | FILE | NO. |
| TE, Inc. | TE, Inc. | 12-06 | 1"=40' H. 1"=5' V. | TE, Inc. | 4803 | 15 |