
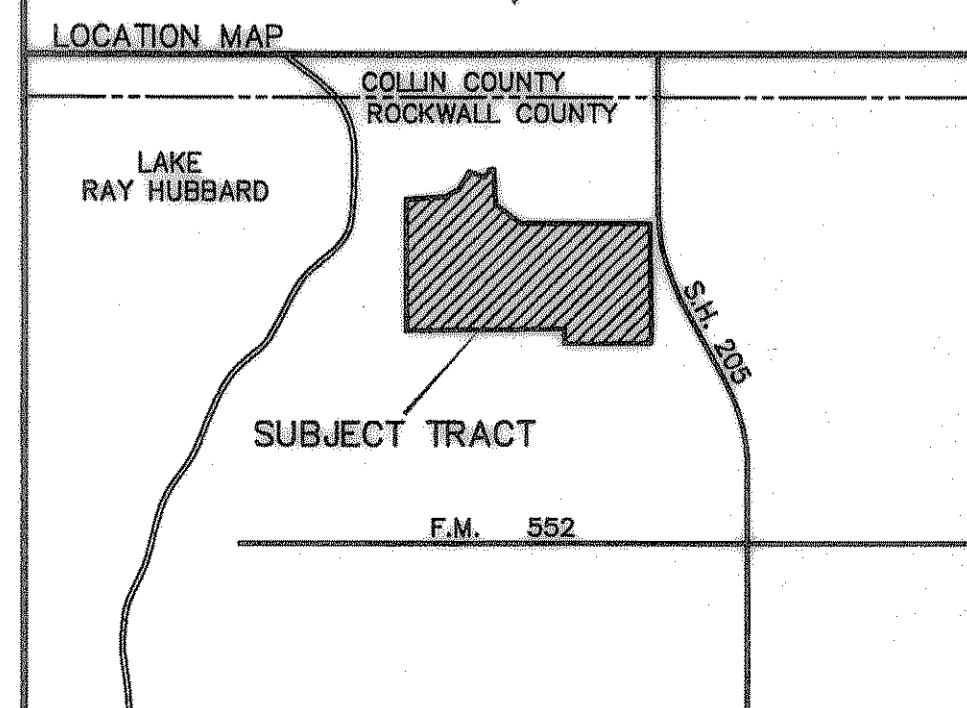


- TREE TIE LEGEND:  
TWO LETTER ABBREVIATIONS
1. BOIS-D'ARC - BO
  2. CEDAR - CE
  3. COTTONWOOD - CW
  4. ELM - EL
  5. HACKBERRY - HA
  6. MESQUITE - ME
  7. OAK - OA
  8. PECAN - PE
  9. PERCORNION - PC
  10. PINE - PI
  11. WILLOW - WI
  - EXAMPLE - 10PE (10" PECAN)
1. TWIN - TW
  2. TRIPPLE - TR
  3. CLUSTER - CL
  - EXAMPLE - 10PE (TWIN 10" PECAN)

703	890
704	881
705	880
706	1080
707	1080
708	1080
709	0836PE
710	36PE
711	1080
712	6PE
713	6PE
714	6PE
715	10EL
716	8EL
717	8EL
NOTE:  
MISSING TREES WERE REMOVED IN FIRST PHASE

5,882" of Total Trees  
456" of Trees to be Removed  
432" of Trees to be Mitigated  
320" of Trees to be Planted  
on Lots (4 Trees Per Lot)  
112" of 3" Trees to be Planted  
in the Open Space Areas

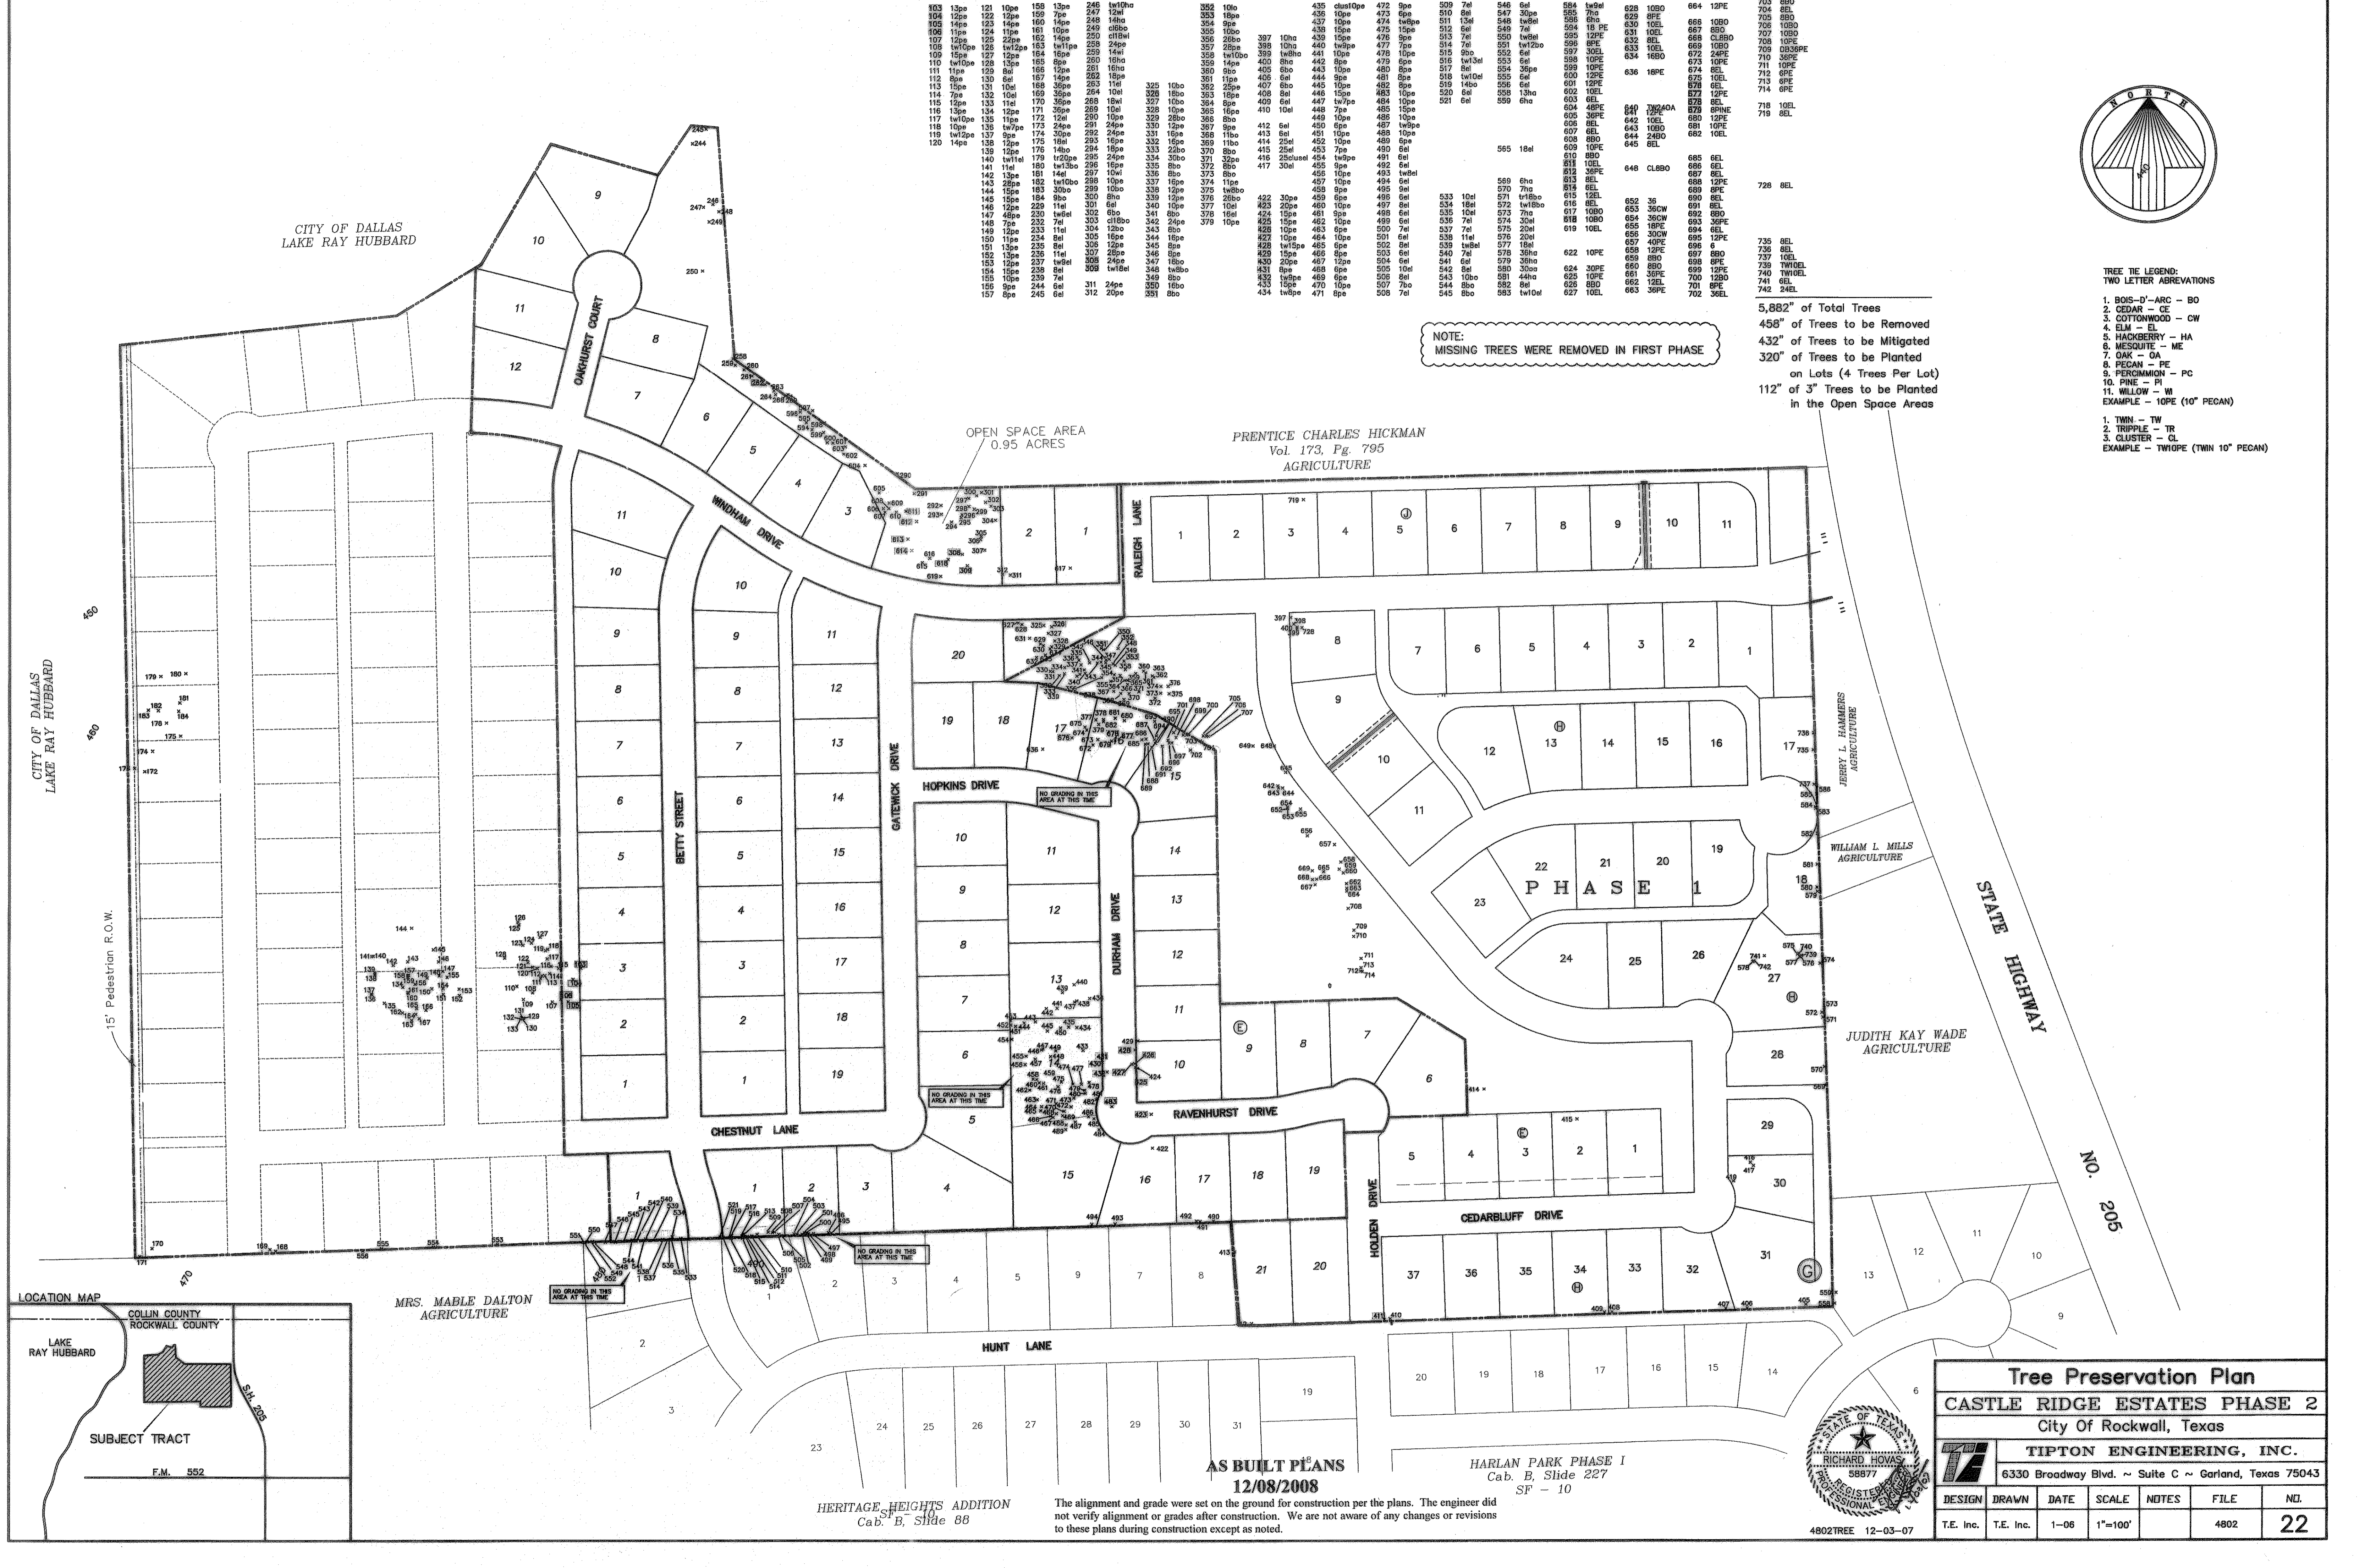


AS BUILT PLANS  
12/08/2008

HARLAN PARK PHASE I  
Cab. B, Slide 227  
SF - 10

HERITAGE HEIGHTS ADDITION  
Cab. B, Slide 88

The alignment and grade were set on the ground for construction per the plans. The engineer did not verify alignment or grades after construction. We are not aware of any changes or revisions to these plans during construction except as noted.

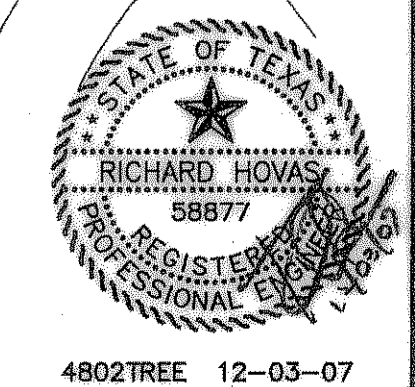

Tree Preservation Plan						
CASTLE RIDGE ESTATES PHASE 2						
City Of Rockwall, Texas						
TIPTON ENGINEERING, INC.						
6330 Broadway Blvd. ~ Suite C ~ Garland, Texas 75043						
DESIGN	DRAWN	DATE	SCALE	NOTES	FILE	NOL
T.E. Inc.	T.E. Inc.	1-06	1"=100'		4802	22

4802TREE 12-03-07