



PAVING, GRADING, DRAINAGE & UTILITIES

FOR


CAVENDER'S

LOT 1, BLOCK 1 CAVENDER'S ADDITION
CITY OF ROCKWALL, ROCKWALL COUNTY, TEXAS

560-11 CAVENDER'S ROCKWALL, TEXAS

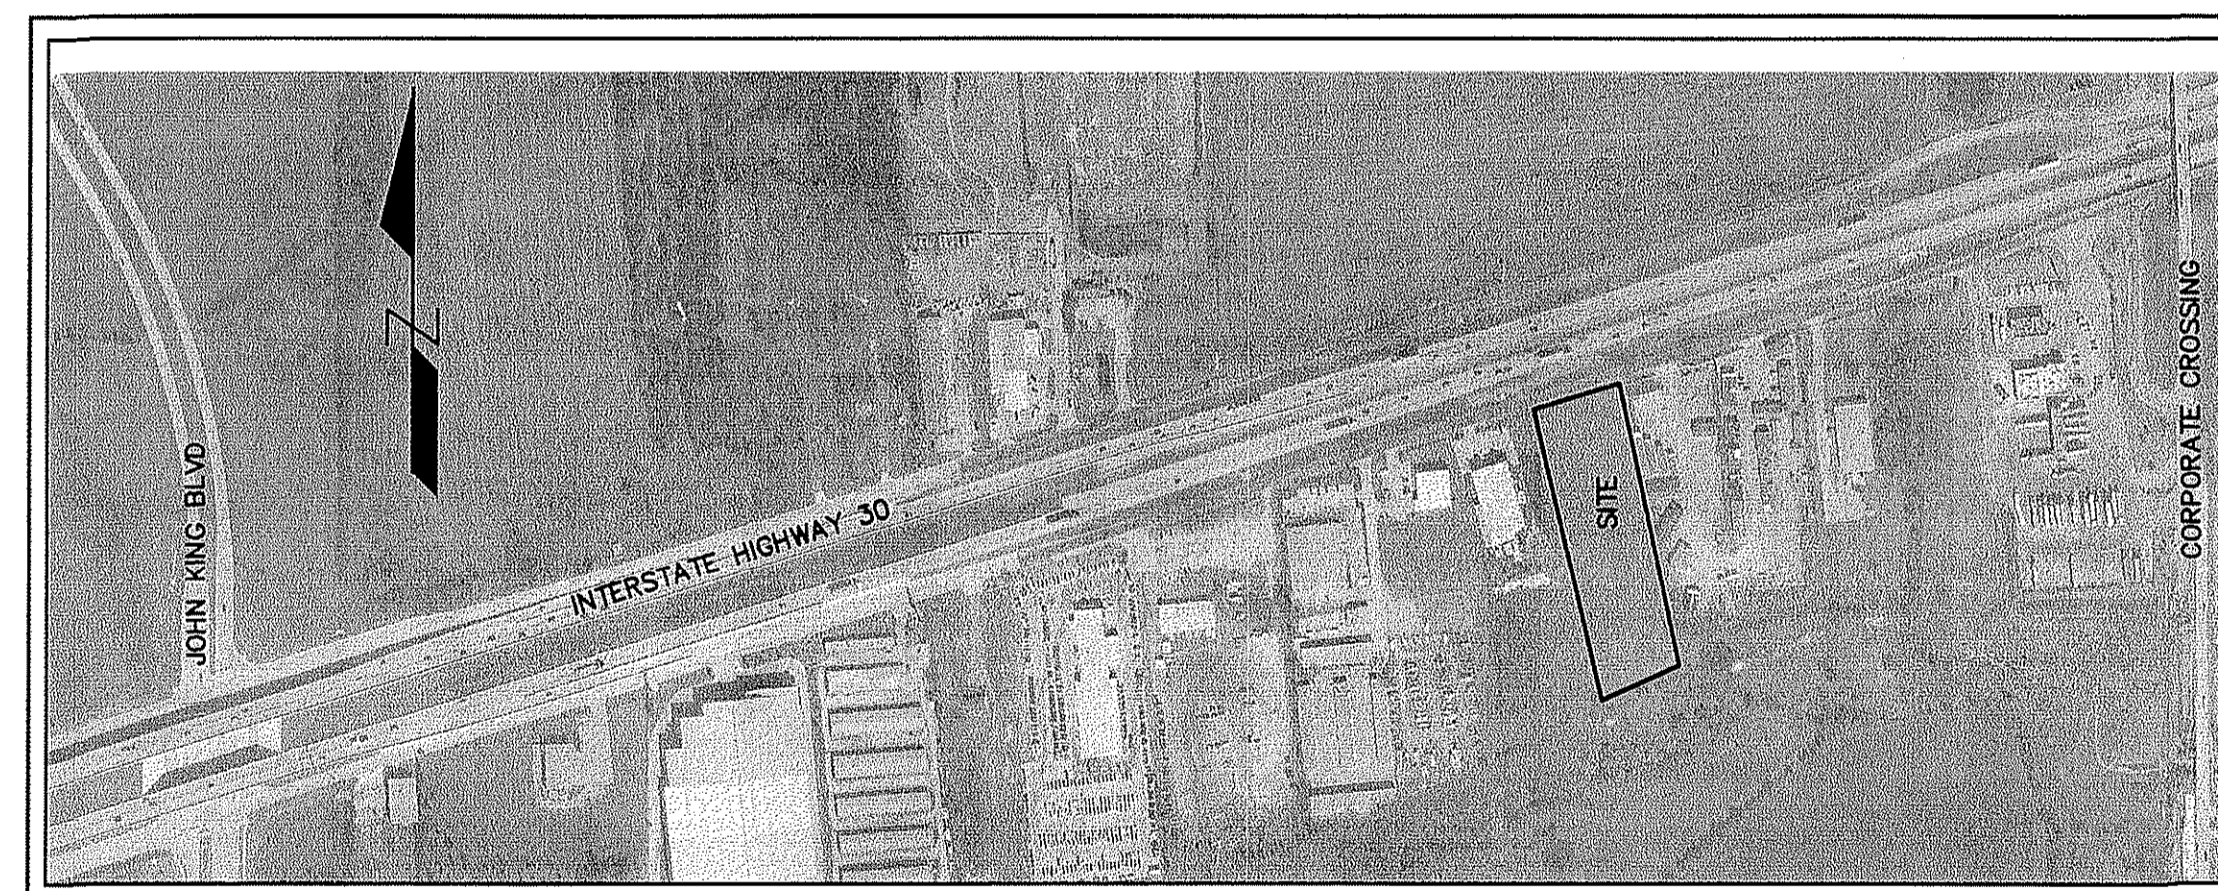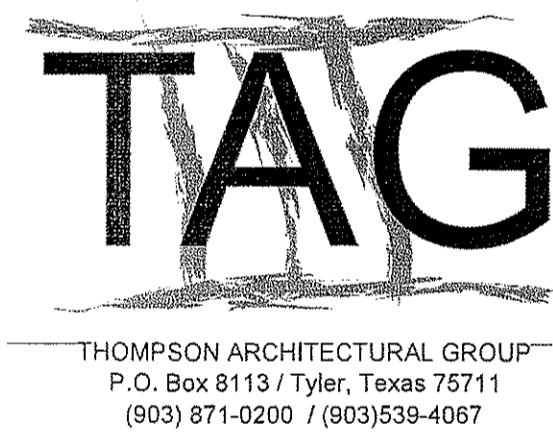

LOCATION MAP
N.T.S.

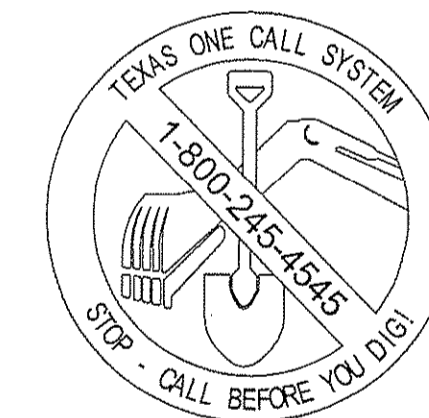

SHEET INDEX

- COVER
- FINAL PLAT
- SP1 SITE PLAN
- C1 DIMENSIONAL CONTROL PLAN
- C2 PAVING PLAN
- C3 GRADING PLAN
- C4 DRAINAGE AREA MAP & DETENTION CALCUATIONS
- C5 EROSION CONTROL PLAN
- C6 STORM SEWER PLAN
- C7 UTILITY PLAN
- C8 DETAILS & GENERAL NOTES
- LP1 LANDSCAPE PLAN
- LP2 LANDSCAPE SPECIFICATIONS AND DETAILS

RETAINING WALL DETAILS

- RW1 COVER SHEET
- RW2 GENERAL NOTES
- RW3 CROSS SECTIONS
- RW4 DETAIL SHEET
- RW5 DETAIL SHEET
- RW6 DETAIL SHEET

SUBMITTALS

NO	DATE	COMMENTS
1	10/06/2014	FIRST CITY SUBMITTAL
2	10/27/2014	SECOND CITY SUBMITTAL
3	10/30/2014	THIRD CITY SUBMITTAL


RECORD DRAWING

TO THE BEST OF OUR KNOWLEDGE THE IMPROVEMENTS SHOWN ON THIS PLAN WERE COMPLETED IN GENERAL CONFORMANCE WITH THE DESIGN PLANS. THIS DETERMINATION WAS MADE BASED ON POST-CONSTRUCTION SURVEY DATA AND INFORMATION PROVIDED BY THE CONTRACTOR

SIGNED: *[Signature]* DATE: 11/20/15


VASQUEZ ENGINEERING, LLC
TEXAS REG. F-12266

THE SEAL APPEARING ON THIS DOCUMENT WAS AUTHORIZED BY JUAN J. VASQUEZ, P.E. 85852, ON 09/29/2014

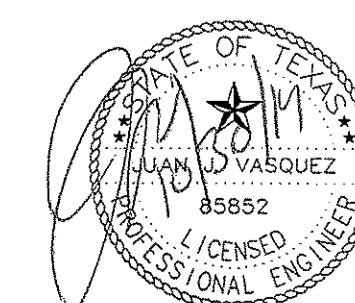


VASQUEZ ENGINEERING, L.L.C.


1919 S. Shiloh Road
Suite 440, LB 44
Garland, Texas 75042
Ph: 972-278-2948
TX Registration #F-12266

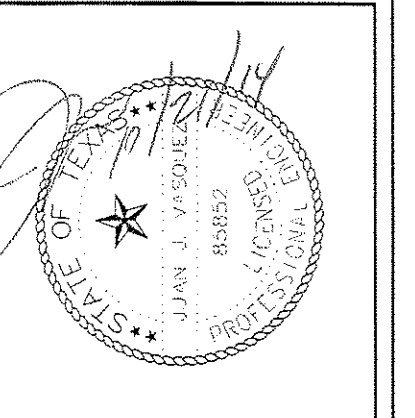

VASQUEZ ENGINEERING L.L.C.
 1919 S. Shiloh Road
 Suite 440, LB 44
 Garland, Texas 75042
 Ph: 972-278-2948
 TX Registration # F-12266

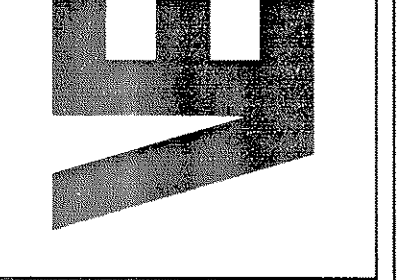

A New Facility for
Cavender's Boot City
 I.H. 30
 Rockwall, Texas

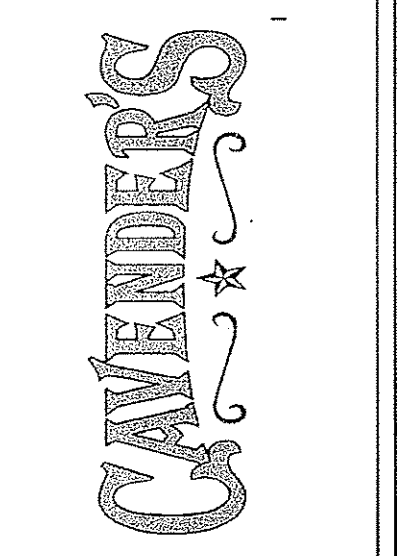


DIMENSIONAL CONTROL PLAN

Revision/Revision Date

Project Number	560-11
Date	10/21/14
Drawn By	J.J.V.
Checked By	J.J.V.

C1

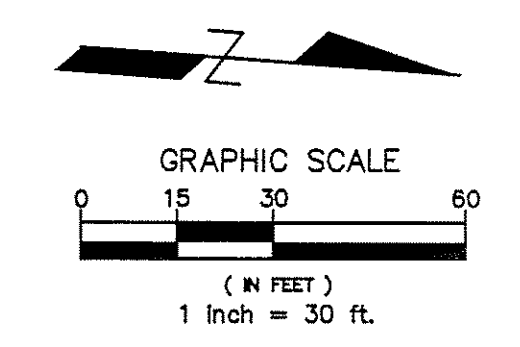


NOTES

- EXISTING TOPOGRAPHY BASED ON SURVEY PREPARED BY H.D. FETTY LAND SURVEYOR, LLC., DATE 8/11/2014
- BUILDING IS PARALLEL AND PERPENDICULAR TO THE SOUTH PROPERTY LINE.
- ALL DIMENSIONS ARE TO EDGE OF PAVEMENT, FACE OF BUILDING OR FACE OF CURB, UNLESS OTHERWISE NOTED.
- ALL CURB RADII NOT CALLED OUT ARE 2' MEASURED AT FACE OF CURB.
- SEE SHEET C2 FOR PAVING PLAN.
- SEE SHEET C8 FOR GENERAL NOTES & PAVEMENT DETAILS.

LEGEND

- PROPERTY LINE
- PAVEMENT
- PKG COUNT
- SIDEWALK

THE SEAL APPEARING ON THIS DOCUMENT WAS AUTHORIZED BY JUAN J. VASQUEZ, P.E. 85952, ON 09/29/2014

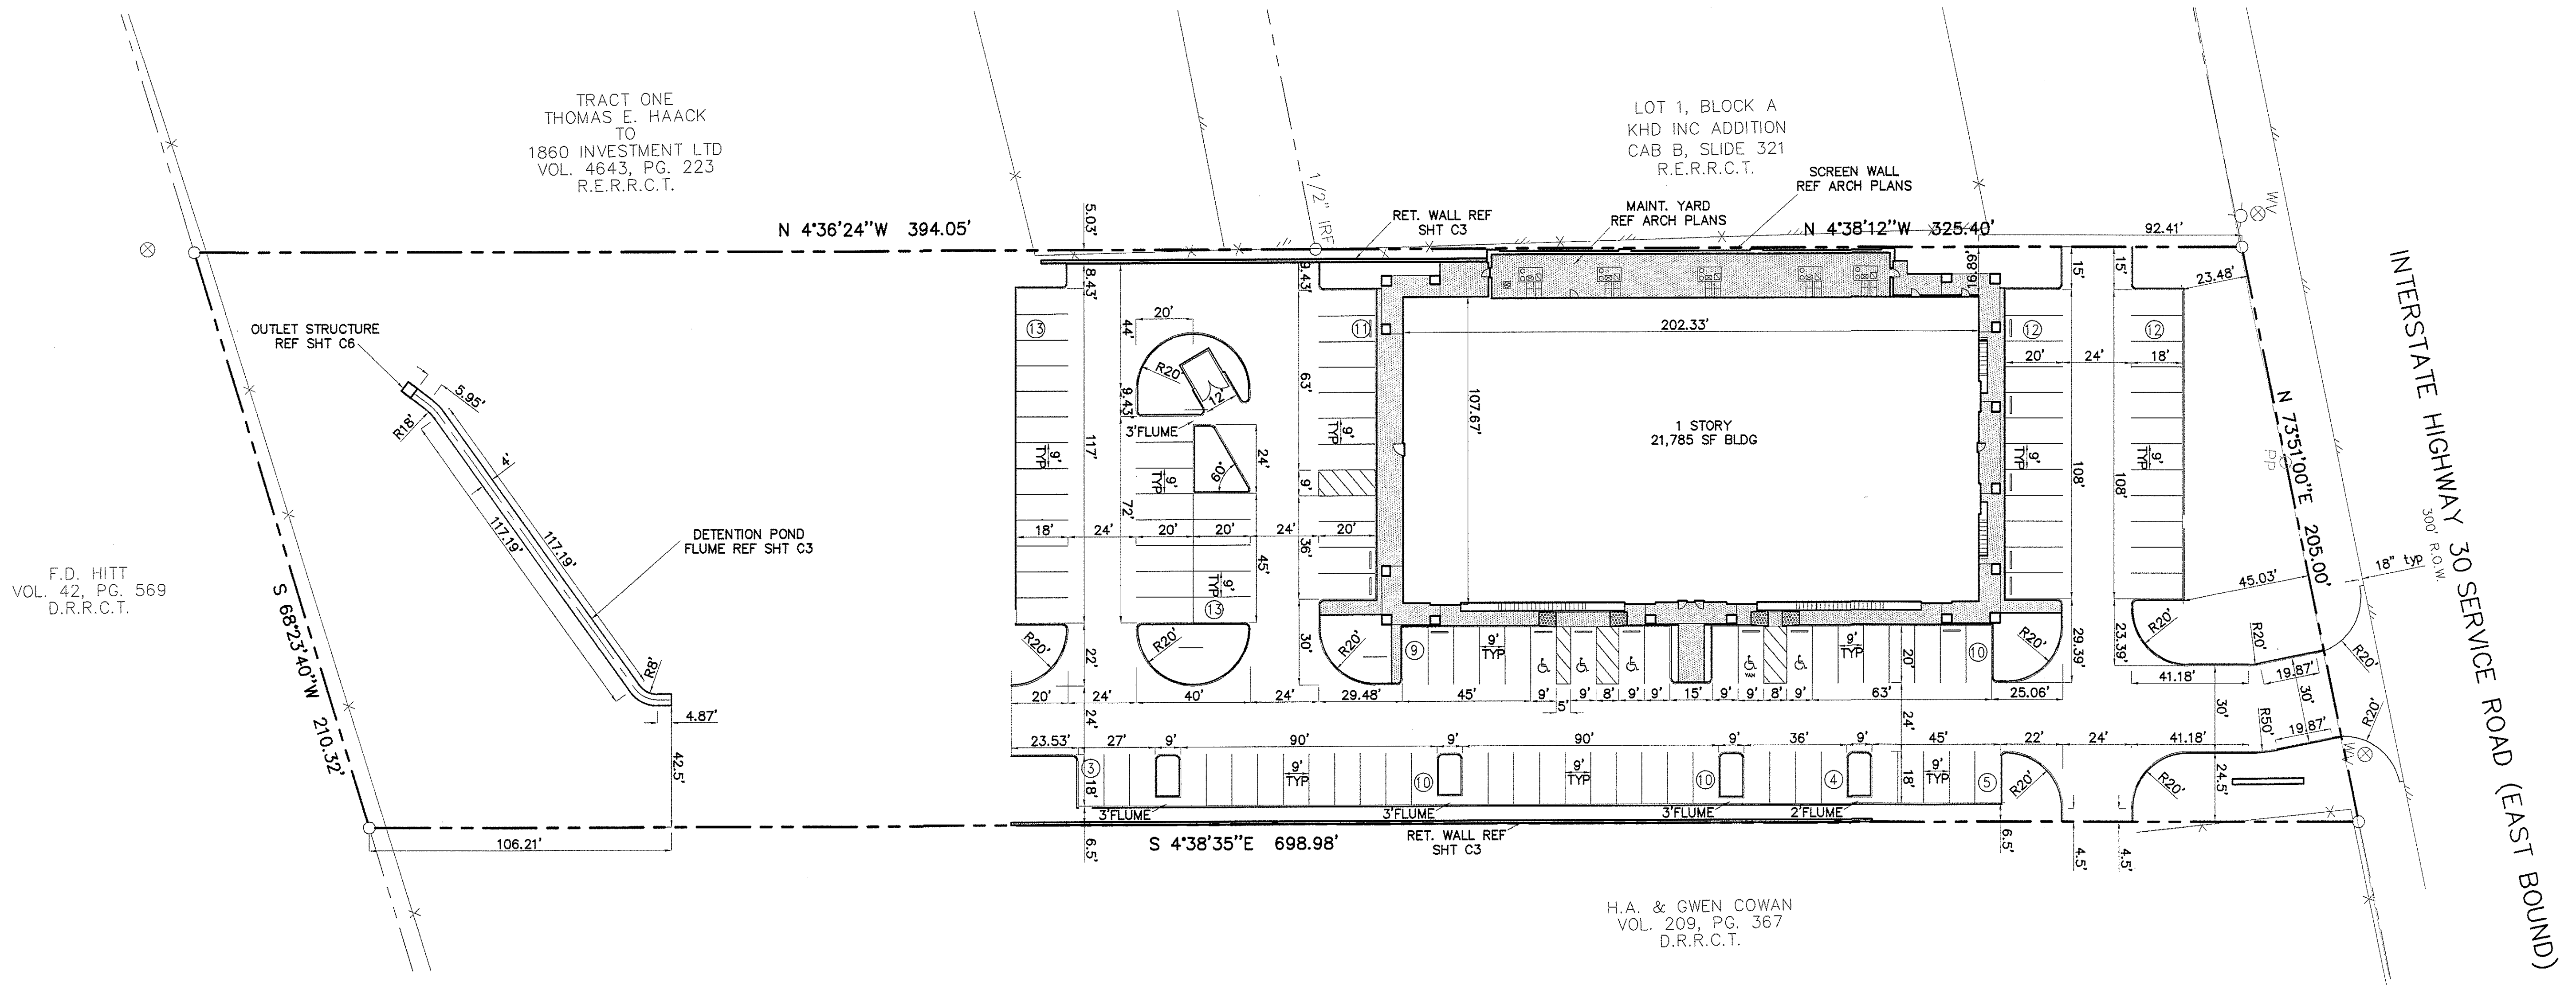

F.D. HITT
 VOL. 42, PG. 569
 D.R.R.C.T.


H.A. & GWEN COWAN
 VOL. 209, PG. 367
 D.R.R.C.T.

RECORD DRAWING


TO THE BEST OF OUR KNOWLEDGE THE IMPROVEMENTS SHOWN ON THIS PLAN WERE COMPLETED IN GENERAL CONFORMANCE WITH THE DESIGN PLANS. THIS DETERMINATION WAS MADE BASED ON POST-CONSTRUCTION SURVEY DATA AND INFORMATION PROVIDED BY THE CONTRACTOR

SIGNED 11/20/15
 DATE
VASQUEZ ENGINEERING, L.L.C.
 TEXAS REG. F-12266




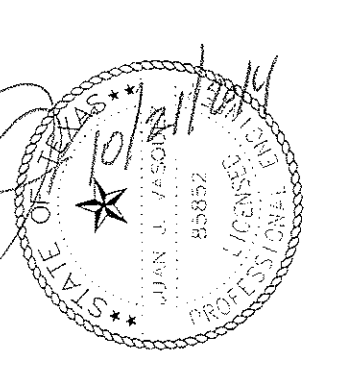

VASQUEZ ENGINEERING L.L.C.
 1919 S. Shiloh Road
 Suite 440, LB 44
 Garland, Texas 75042
 Ph: 972-278-2948
 TX Registration # F-12266

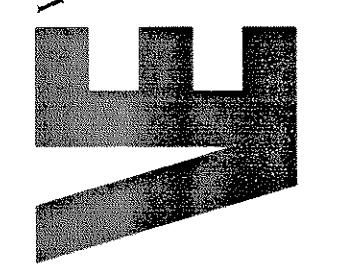

A New Facility for
Cavender's Boot City
 I.H. 30
 Rockwall, Texas

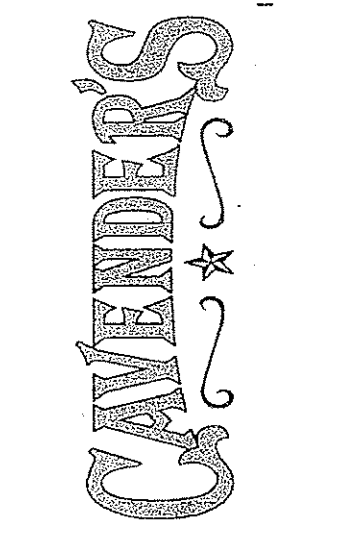

PAVING PLAN

Revision/Revision Date

Project Number 560-11
 Date 10/21/14
 Drawn By J.J.V.
 Checked By J.J.V.


C2

THE SEAL APPEARING ON THIS DOCUMENT IS THE PROPERTY OF THE STATE OF TEXAS. IT IS TO BE USED ONLY FOR THE PROJECT AND DATE SPECIFIED HEREON.
 JUAN S. VASQUEZ, P.E. 185852, ON 09/29/2014

- PAVING NOTES:**
1. CONTRACTOR SHALL BE RESPONSIBLE FOR ADJUSTING WATER AND SANITARY SEWER APPURTENANCES PER CITY STANDARDS.
 2. CONTRACTOR SHALL REMOVE EXCESS SOILS AND DEBRIS FROM SITE AND DISPOSE OF IN A LEGAL MANNER OFF SITE.
 3. SOIL SHALL BE IN A MOIST AND COMPACTED CONDITIONS PRIOR TO PLACEMENT OF THE CONCRETE. ALL FILL TO BE COMPACTED TO 95% STD PROCTOR USING A SHEEP'S FOOT ROLLER.
 4. CONCRETE SHALL BE AS SHOWN ON THE PLANS. CONCRETE TO THE DEPTHS SHOWN ON THE PLANS. FLY ASH WILL NOT BE ALLOWED.
 5. REINFORCING STEEL SHALL BE SUPPORTED BY PLASTIC CHAIRS IN A MANNER TO PROVIDE A UNIFORM MESH CLEARANCE PER THE PROJECT DETAILS IN THE PLANS OR REQUIRED BY THE CITY. CONTRACTOR SHALL OBTAIN AND PAY FOR ANY PERMITS REQUIRED.
 6. SURFACE FINISHING SHALL BE SKID RESISTANT AND A LIQUID CURING COMPOUND SHALL BE UNIFORMLY APPLIED ON THE CONCRETE IMMEDIATELY AFTER THE FINISHING OPERATION.
 7. EXPANSION JOINTS OR ISOLATION JOINTS SHALL BE USED TO ISOLATE FIXED OBJECTS ABUTTING OR WITHIN THE PAVED AREAS. THEY SHOULD CONTAIN PREMOLDED JOINT FILLER FOR THE FULL DEPTH OF THE PAVEMENT AND BE SEALED PRIOR TO ALLOWING TRAFFIC.
 8. EXPANSION JOINTS SHALL BE PLACED AS SHOWN ON PLAN, SAWED JOINTS SHALL BE PLACED AT 15 FT MAX INTERVALS, AND CONSTRUCTION JOINTS SHALL BE LOCATED AT SAWED JOINTS OR EXPANSION JOINTS.
 9. CONSTRUCT LONGITUDINAL BUTT JOINT WHERE EXISTING PAVEMENT MEETS PROPOSED PAVEMENT REFERENCE DETAIL IN PLANS.



- NOTES:**
1. EXISTING TOPOGRAPHY BASED ON SURVEY PREPARED BY H.D. FETTY LAND SURVEYOR, LLC., DATE 08/11/2014.
 2. REF ARCH PLANS FOR EXACT BLDG. DIMENSIONS.
 3. SEE SHEET C1 FOR DIMENSION CONTROL.
 4. SEE SHEET C3 FOR SITE GRADING.
 5. SEE SHEET C8 FOR PAVING DETAILS & GENERAL NOTES.
 6. FOLLOW ALL CITY OF ROCKWALL STANDARDS AND NCTCOG 3RD EDITION STANDARDS.

- 1 24' FIRE LANE
- 2 END CURB
- 3 WHEEL STOP (REF DTL SHT C8)
- 4 DUMPSTER ENCLOSURE (REF ARCH PLANS)
- 5 PROP PYLON SIGN (REF ARCH PLANS)
- 6 RETAINING WALL (REF SHT C3)
- 7 BARRIER FREE RAMP (ON-SITE)
- 8 HANDICAP SIGN (REF DTL SHT C8)
- 9 GRATE INLET (SEE SHT C3)
- 10 4" WIDE STRIPE (REF DTL SHT C8)
- 11 TRAFFIC BARRICADE
- 12 EXPANSION JOINT
- 13 2' CONC FLUME (REF DTL SHT C8)
- 14 3' CONC FLUME (REF DTL SHT C8)
- 15 PLANTER BED
- 16 DETENTION POND FLUME (REF DTL SHT C3)
- 17 OUTLET STRUCTURE (REF DTL SHT C6)
- 18 GROUTED ROCK RIP-RAP (REF SHT C3)
- 19 DRIVEWAY CULVERT (REF SHT C6)
- 20 CURB INLET (REF SHT C6)

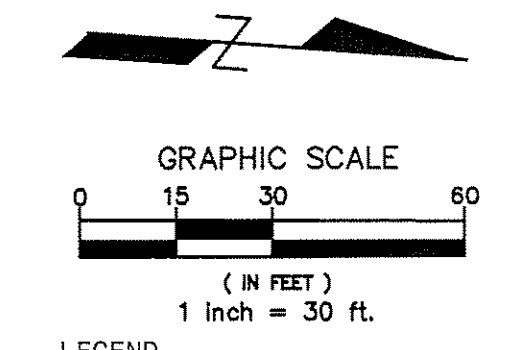

LEGEND

[Symbol]	PROP. 6" INTEGRAL CURB
[Symbol]	EXISTING CURB/PAVEMENT
[Symbol]	PROP 4" CONC SIDEWALK
[Symbol]	PROP 5" CONC PVMT (REF DTL SHT C8)
[Symbol]	PROP 6" CONC PVMT (REF DTL SHT C8)
[Symbol]	PROP 7" CONC PVMT (REF DTL SHT C8)
[Symbol]	LIGHT POLE

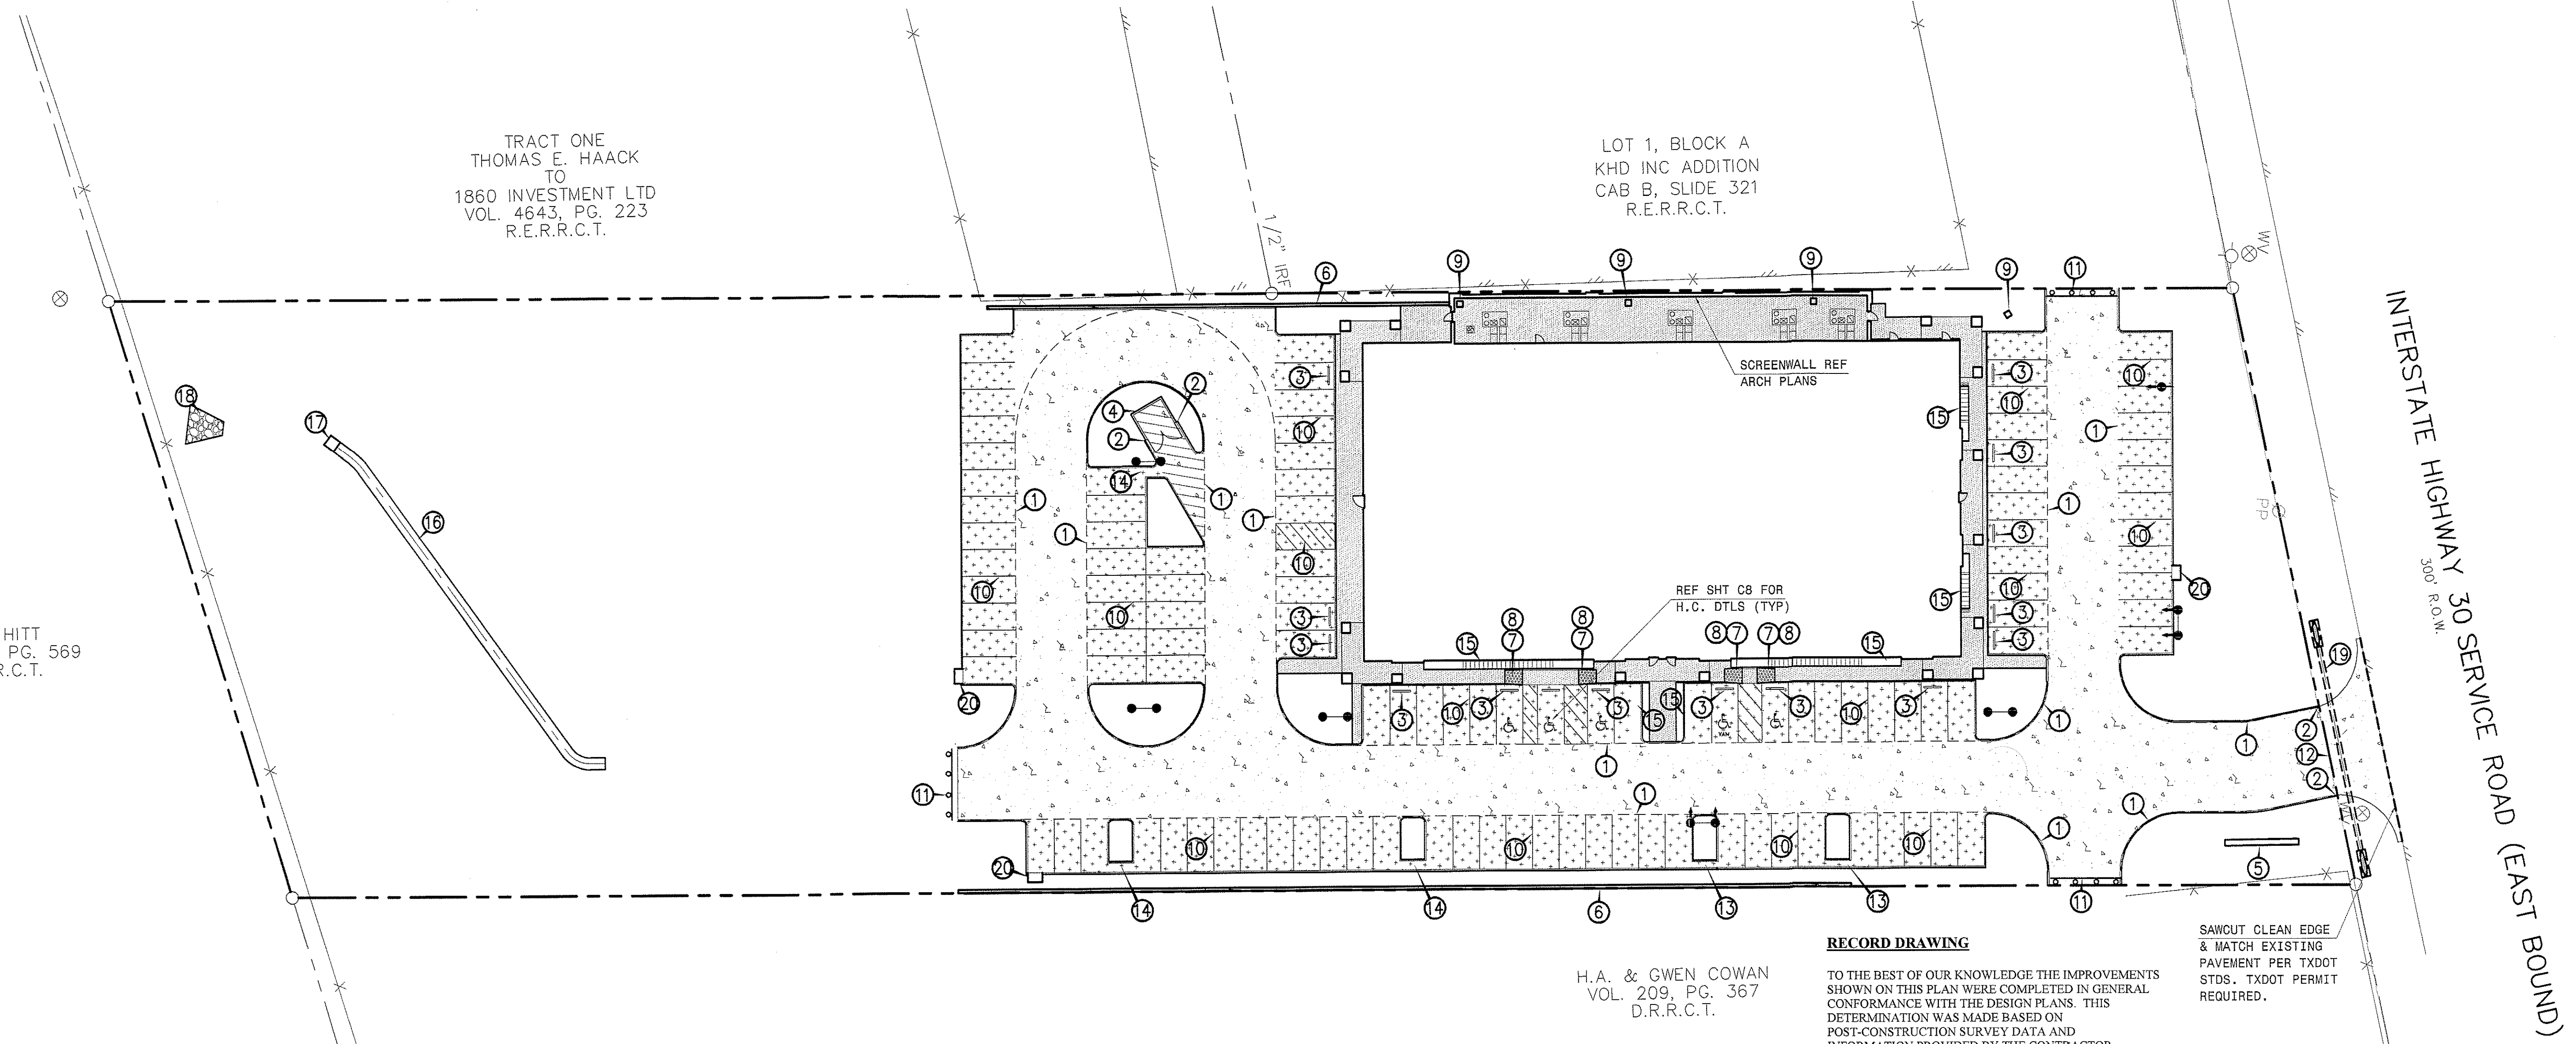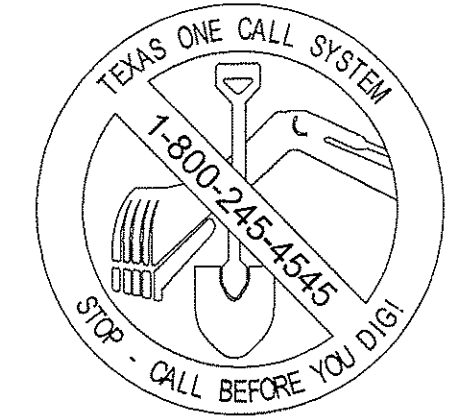

F.D. HITT
 VOL. 42, PG. 569
 D.R.R.C.T.

H.A. & GWEN COWAN
 VOL. 209, PG. 367
 D.R.R.C.T.

RECORD DRAWING

TO THE BEST OF OUR KNOWLEDGE THE IMPROVEMENTS SHOWN ON THIS PLAN WERE COMPLETED IN GENERAL CONFORMANCE WITH THE DESIGN PLANS. THIS DETERMINATION WAS MADE BASED ON POST-CONSTRUCTION SURVEY DATA AND INFORMATION PROVIDED BY THE CONTRACTOR

SIGNED: [Signature] / DATE: 11/21/15

VASQUEZ ENGINEERING, LLC
 TEXAS REG. F-12266

RATIONAL METHOD: (Q=CIA)


AREA NAME	AREA (acres)	C	INLET TIME (min)	I ₁₀₀ (in/hr)	Q ₁₀₀ (cfs)	COMMENTS
1	0.02	0.90	10.00	9.8	0.18	TO GRATE INLET
2	0.34	0.90	10.00	9.8	3.00	TO CURB INLET
3	0.69	0.90	10.00	9.8	6.09	TO CURB INLET
4	0.50	0.90	10.00	9.8	4.41	TO DOWNSPOUTS
5	0.07	0.90	10.00	9.8	0.62	TO GRATE INLETS
6	0.39	0.90	10.00	9.8	3.44	TO CURB INLET
7	0.95	0.90	10.00	9.8	8.38	TO DETENTION POND
8	0.31	0.90	10.00	9.8	2.73	TO SOUTH PROPERTY LINE
T1	0.46	0.65	10.00	9.8	2.93	TO 18" CULVERT

NOTES:

- EXISTING TOPOGRAPHY BASED ON SURVEY PREPARED BY H.D. FETTY LAND SURVEYOR, LLC., DATED 8/11/2014
- SEE SHEET C3 FOR GRADING AND DRAINAGE PLAN.
- SEE SHEET C5 FOR EROSION CONTROL PLAN.
- SEE SHEET C6 FOR STORM SEWER DESIGN.

BENCHMARK:

RAILROAD SPIKE IN A POWER POLE ALONG SERVICE ROAD. ELEVATION = 582.40'

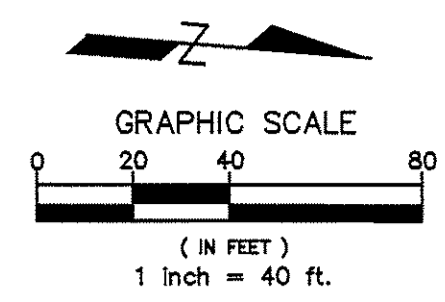

LEGEND

- 578 --- EXIST. CONTOUR
- 78 --- PROP. CONTOUR
- FLOW ARROW
- DRAINAGE DIVIDE
- ① 0.02 DRAINAGE AREA ACREAGE

5-YEAR STORM

- TOTAL AREA DRAINING TO POND = 2.96 ACRES (DA 1-7)
- TOTAL BYPASS AROUND POND = 0.31 ACRES (DA 8)
- ALLOWABLE DISCHARGE FROM POND = CIA = 0.35(5.0)(2.96)=5.18 CFS
- PROPOSED BYPASS AROUND POND = CIA = 0.90(6.10)(0.31) = 1.70 CFS
- EXISTING BYPASS AROUND POND = CIA = 0.35(5.0)(0.31) = 0.54 CFS
- DESIGN DISCHARGE FROM POND = C-(D-E)=5.18-(1.70-0.54) = 4.02 CFS

Area, acres	2.96				
Present Conditions		Proposed Conditions			
C	0.35	C	0.90		
Tc	20.00	Tc	10.00		
i(5)	5.00	i(5)	6.10		
Q(5)	5.18	Q(5)	16.25		
Q(release)	4.02				
Proposed Intensities					
Time	Inflow	Outflow	Storage (cf)	Tc	Intensity
10	9750	2412	7338	10	6.10
20	15984	3618	12366	20	5.00
30	19181	4824	14357	30	4.00
40	22378	6030	16348	40	3.50
50	23177	7236	15941	50	2.90
60	24935	8442	16493	60	2.60
70	27413	9648	17765	70	2.45
80	28132	10854	17278	80	2.20
90	28771	12060	16711	90	2.00

10-YEAR STORM

- TOTAL AREA DRAINING TO POND = 2.96 ACRES (DA 1-7)
- TOTAL BYPASS AROUND POND = 0.31 ACRES (DA 8)
- ALLOWABLE DISCHARGE FROM POND = CIA = 0.35(5.9)(2.96)=6.11 CFS
- PROPOSED BYPASS AROUND POND = CIA = 0.90(7.2)(0.31) = 2.01 CFS
- EXISTING BYPASS AROUND POND = CIA = 0.35(5.9)(0.31) = 0.64 CFS
- DESIGN DISCHARGE FROM POND = C-(D-E)=6.11-(2.01-0.64) = 4.74 CFS

Area, acres	2.96				
Present Conditions		Proposed Conditions			
C	0.35	C	0.90		
Tc	20.00	Tc	10.00		
i(10)	5.90	i(10)	7.20		
Q(10)	6.11	Q(10)	19.18		
Q(release)	4.74				
Proposed Intensities					
Time	Inflow	Outflow	Storage (cf)	Tc	Intensity
10	11508	2844	8664	10	7.20
20	18861	4266	14595	20	5.90
30	23496	5688	17808	30	4.90
40	25574	7110	18464	40	4.00
50	27972	8532	19440	50	3.50
60	28771	9954	18817	60	3.00
70	30210	11376	18834	70	2.70
80	31329	12798	18531	80	2.45
90	32368	14220	18148	90	2.25

25-YEAR STORM

- TOTAL AREA DRAINING TO POND = 2.96 ACRES (DA 1-7)
- TOTAL BYPASS AROUND POND = 0.31 ACRES (DA 8)
- ALLOWABLE DISCHARGE FROM POND = CIA = 0.35(6.7)(2.96)=6.94 CFS
- PROPOSED BYPASS AROUND POND = CIA = 0.90(8.3)(0.31) = 2.32 CFS
- EXISTING BYPASS AROUND POND = CIA = 0.35(6.7)(0.31) = 0.73 CFS
- DESIGN DISCHARGE FROM POND = C-(D-E)=6.94-(2.32-0.73) = 5.35 CFS

Area, acres	2.96				
Present Conditions		Proposed Conditions			
C	0.35	C	0.90		
Tc	20.00	Tc	10.00		
i(25)	6.70	i(25)	8.30		
Q(25)	6.94	Q(25)	22.11		
Q(release)	5.35				
Proposed Intensities					
Time	Inflow	Outflow	Storage (cf)	Tc	Intensity
10	13267	3210	10057	10	8.30
20	21419	4815	16604	20	6.70
30	26374	6420	19954	30	5.50
40	29730	8025	21705	40	4.65
50	31968	9630	22338	50	4.00
60	34046	11235	22811	60	3.55
70	35804	12840	22964	70	3.20
80	36444	14445	21999	80	2.85
90	37403	16050	21353	90	2.60

100-YEAR STORM

- TOTAL AREA DRAINING TO POND = 2.96 ACRES (DA 1-7)
- TOTAL BYPASS AROUND POND = 0.31 ACRES (DA 8)
- ALLOWABLE DISCHARGE FROM POND = CIA = 0.35(8.3)(2.96)=8.60 CFS
- PROPOSED BYPASS AROUND POND = CIA = 0.90(9.8)(0.31) = 2.73 CFS
- EXISTING BYPASS AROUND POND = CIA = 0.35(8.3)(0.31) = 0.90 CFS
- DESIGN DISCHARGE FROM POND = C-(D-E)=8.60-(2.73-0.90) = 6.77 CFS

Area, acres	2.96				
Present Conditions		Proposed Conditions			
C	0.35	C	0.90		
Tc	20.00	Tc	10.00		
i(100)	8.30	i(100)	9.80		
Q(100)	8.60	Q(100)	26.11		
Q(release)	6.77				
Proposed Intensities					
Time	Inflow	Outflow	Storage (cf)	Tc	Intensity
10	15664	4062	11602	10	9.80
20	26533	6093	20440	20	8.30
30	33087	8124	24963	30	6.90
40	37083	10155	26928	40	5.80
50	39960	12186	27774	50	5.00
60	43157	14217	28940	60	4.50
70	44755	16248	28507	70	4.00
80	47313	18279	29034	80	3.70
90	50350	20310	30040	90	3.50
100	52763	22341	30422	100	3.30
120	52747	26403	26344	120	2.75

CONTOUR	AREA (SF)	VOLUME (CF)	CUMM. VOLUME (CF)	5-YR VOLUME	5-YR WSEL
569.0	15662	14485	33430		
568.0	13307	12208	18945		
567.0	11108	6569	6738	17765	567.90
566.0	2029	169	169		
565.5	0				

CONTOUR	AREA (SF)	VOLUME (CF)	CUMM. VOLUME (CF)	10-YR VOLUME	10-YR WSEL
569.0	15662	14485	33430		
568.0	13307	12208	18945		
567.0	11108	6569	6738	18834	567.99
566.0	2029	169	169		
565.5	0				


CONTOUR	AREA (SF)	VOLUME (CF)	CUMM. VOLUME (CF)	25-YR VOLUME	25-YR WSEL
569.0	15662	14485	33430		
568.0	13307	12208	18945	22964	568.28
567.0	11108	6569	6738		
566.0	2029	169	169		
565.5	0				

CONTOUR	AREA (SF)	VOLUME (CF)	CUMM. VOLUME (CF)	100-YR VOLUME	100-YR WSEL
569.0	15662	14485	33430		
568.0	13307	12208	18945	30422	568.79
567.0	11108	6569	6738		
566.0	2029	169	169		
565.5	0				

VA NOTCHED WEIR CALCULATION					
5YEAR	WSEL	FLOW LINE	C	ANGLE	Q CFS
5YEAR	567.90	565.50	0.60	0.262	3.02
10YEAR	567.98	565.50	0.60	0.262	3.31
25YEAR	568.28	565.50	0.60	0.262	4.36
100YEAR	568.79	565.50	0.60	0.262	6.84

Q = 8/15 * C * (2g)^0.5 * TAN(ANGLE/2) * H^2.5
 ANGLE = 15 DEGREES = 0.262 RADIANS
 H = WSEL - FLOW LINE

DISCHARGE FROM POND		
EVENT	DESIGN DISCHARGE FROM POND (CFS)	ACTUAL DISCHARGE FROM POND (CFS)
5YEAR	4.02	3.02
10YEAR	4.74	3.31
25YEAR	5.35	4.36
100YEAR	6.77	6.84

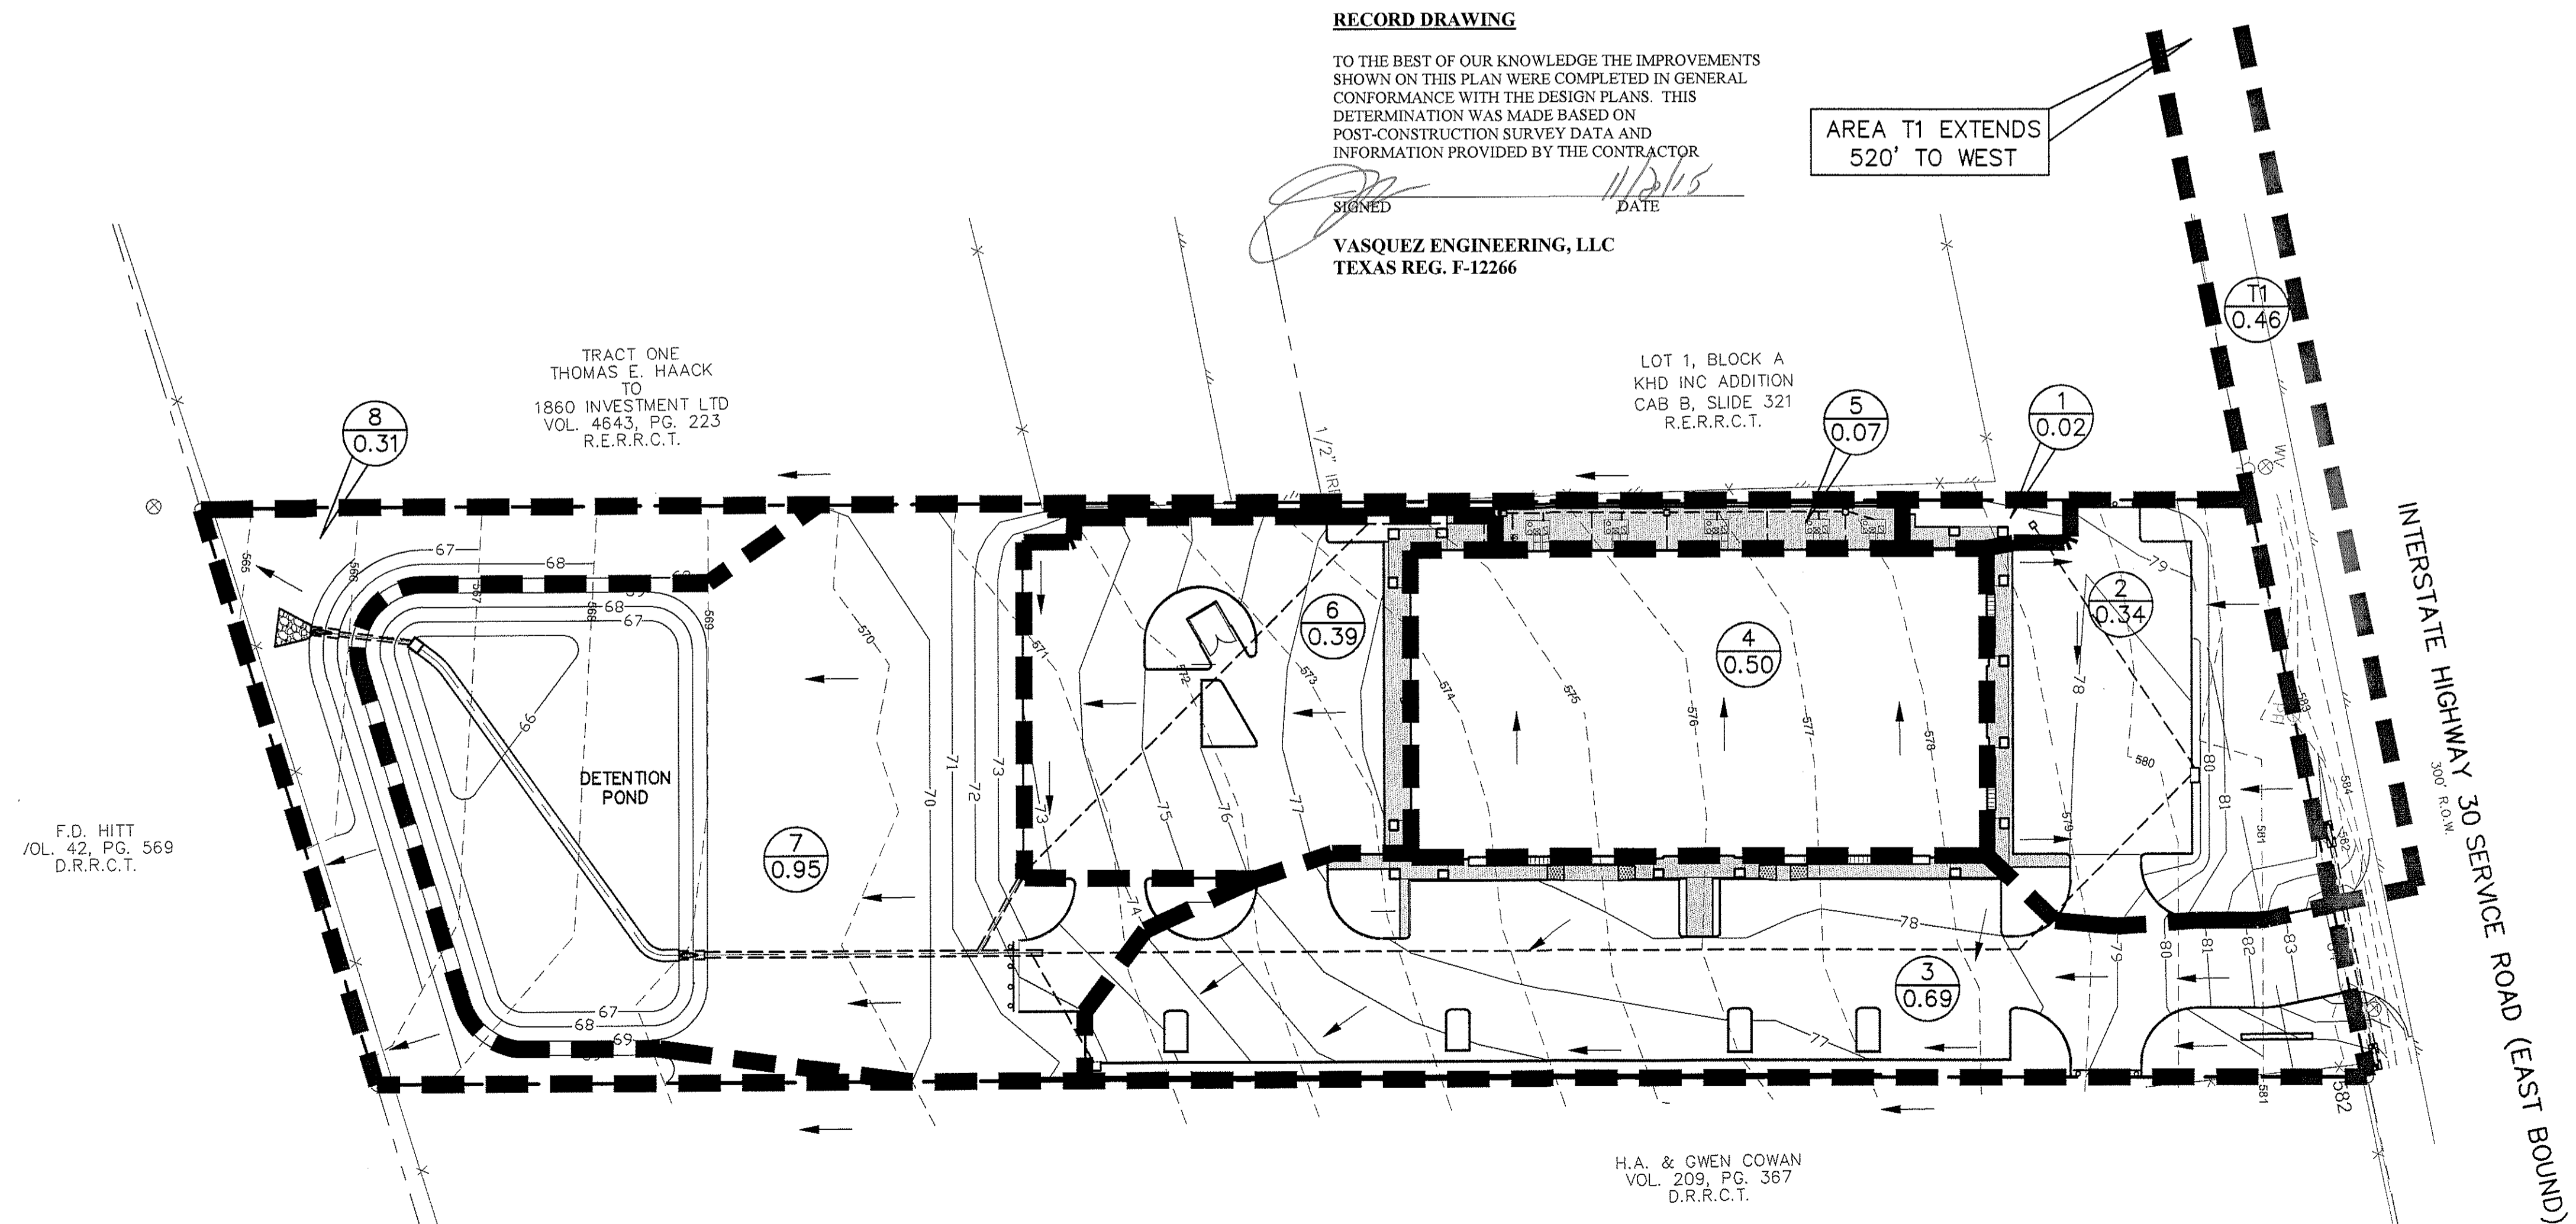



RECORD DRAWING

TO THE BEST OF OUR KNOWLEDGE THE IMPROVEMENTS SHOWN ON THIS PLAN WERE COMPLETED IN GENERAL CONFORMANCE WITH THE DESIGN PLANS. THIS DETERMINATION WAS MADE BASED ON POST-CONSTRUCTION SURVEY DATA AND INFORMATION PROVIDED BY THE CONTRACTOR


SIGNED: [Signature] DATE: 11/21/15

VASQUEZ ENGINEERING, LLC TEXAS REG. F-12266


H.A. & GWEN COWAN VOL. 209, PG. 367 D.R.R.C.T.

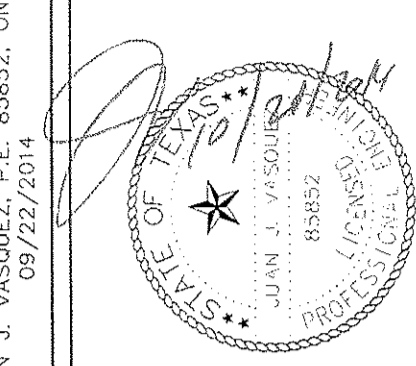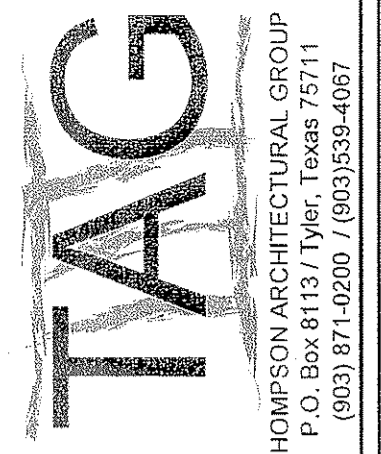

VASQUEZ ENGINEERING L.L.C.
 1919 S. Shiloh Road
 Suite 440, LB 44
 Garland, Texas 75042
 Ph: 972-278-2948
 TX Registration # F-12266

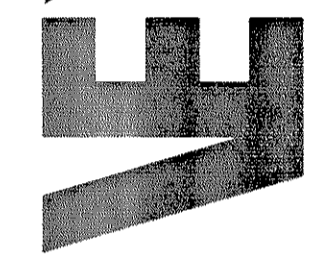

A New Facility for
Cavender's
 Boot City
 I.H. 30
 Rockwall, Texas

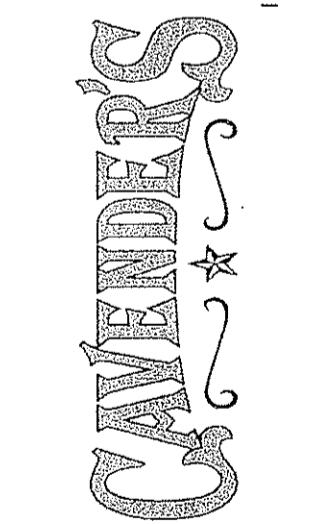

DRAINAGE AREA MAP

Revision/Revision Date

Project Number 560-11

Date 10/21/2014

Drawn By J.J.V.





Checked By J.J.V.

C4

THE SEAL APPEARING ON THIS DOCUMENT WAS AUTHORIZED BY JOAN U. VASQUEZ, ON 09/22/2014

EROSION PROTECTION DURING CONSTRUCTION

1. CONTRACTOR SHALL BE RESPONSIBLE FOR IMPLEMENTING EROSION CONTROL TECHNIQUES AND METHODS TO STOP EROSION OF ONSITE SOILS AND PROTECT ADJACENT PROPERTIES FROM POTENTIAL SILT MIGRATION. SILT FENCING SHALL BE INSTALLED AT THE LOCATIONS SHOWN PRIOR TO THE START OF CONSTRUCTION AND SITE GRADING.
2. EROSION CONTROL MEASURES SHALL BE IMPLEMENTED PER CITY AND TCEQ REQUIREMENTS. ALL APPLICABLE FEES AND SUBMITTALS SHALL BE MADE PRIOR TO THE START OF CONSTRUCTION.
3. SINCE DISTURBED AREA IS GREATER THAN 1.0 ACRE A SWPPP WILL BE REQUIRED.
4. REFER TO PROJECT SWPPP FOR ADDITIONAL REQUIREMENTS.

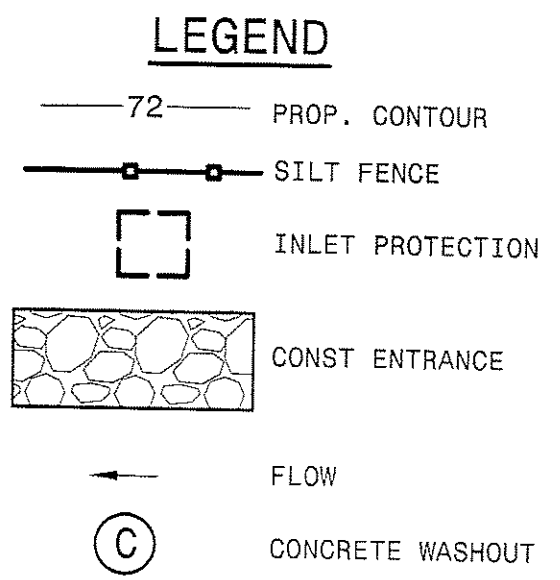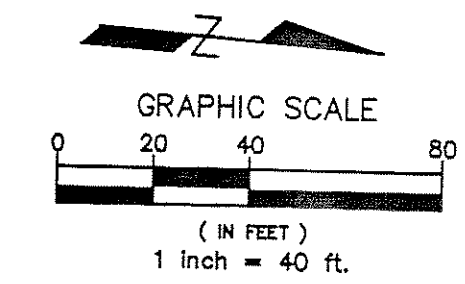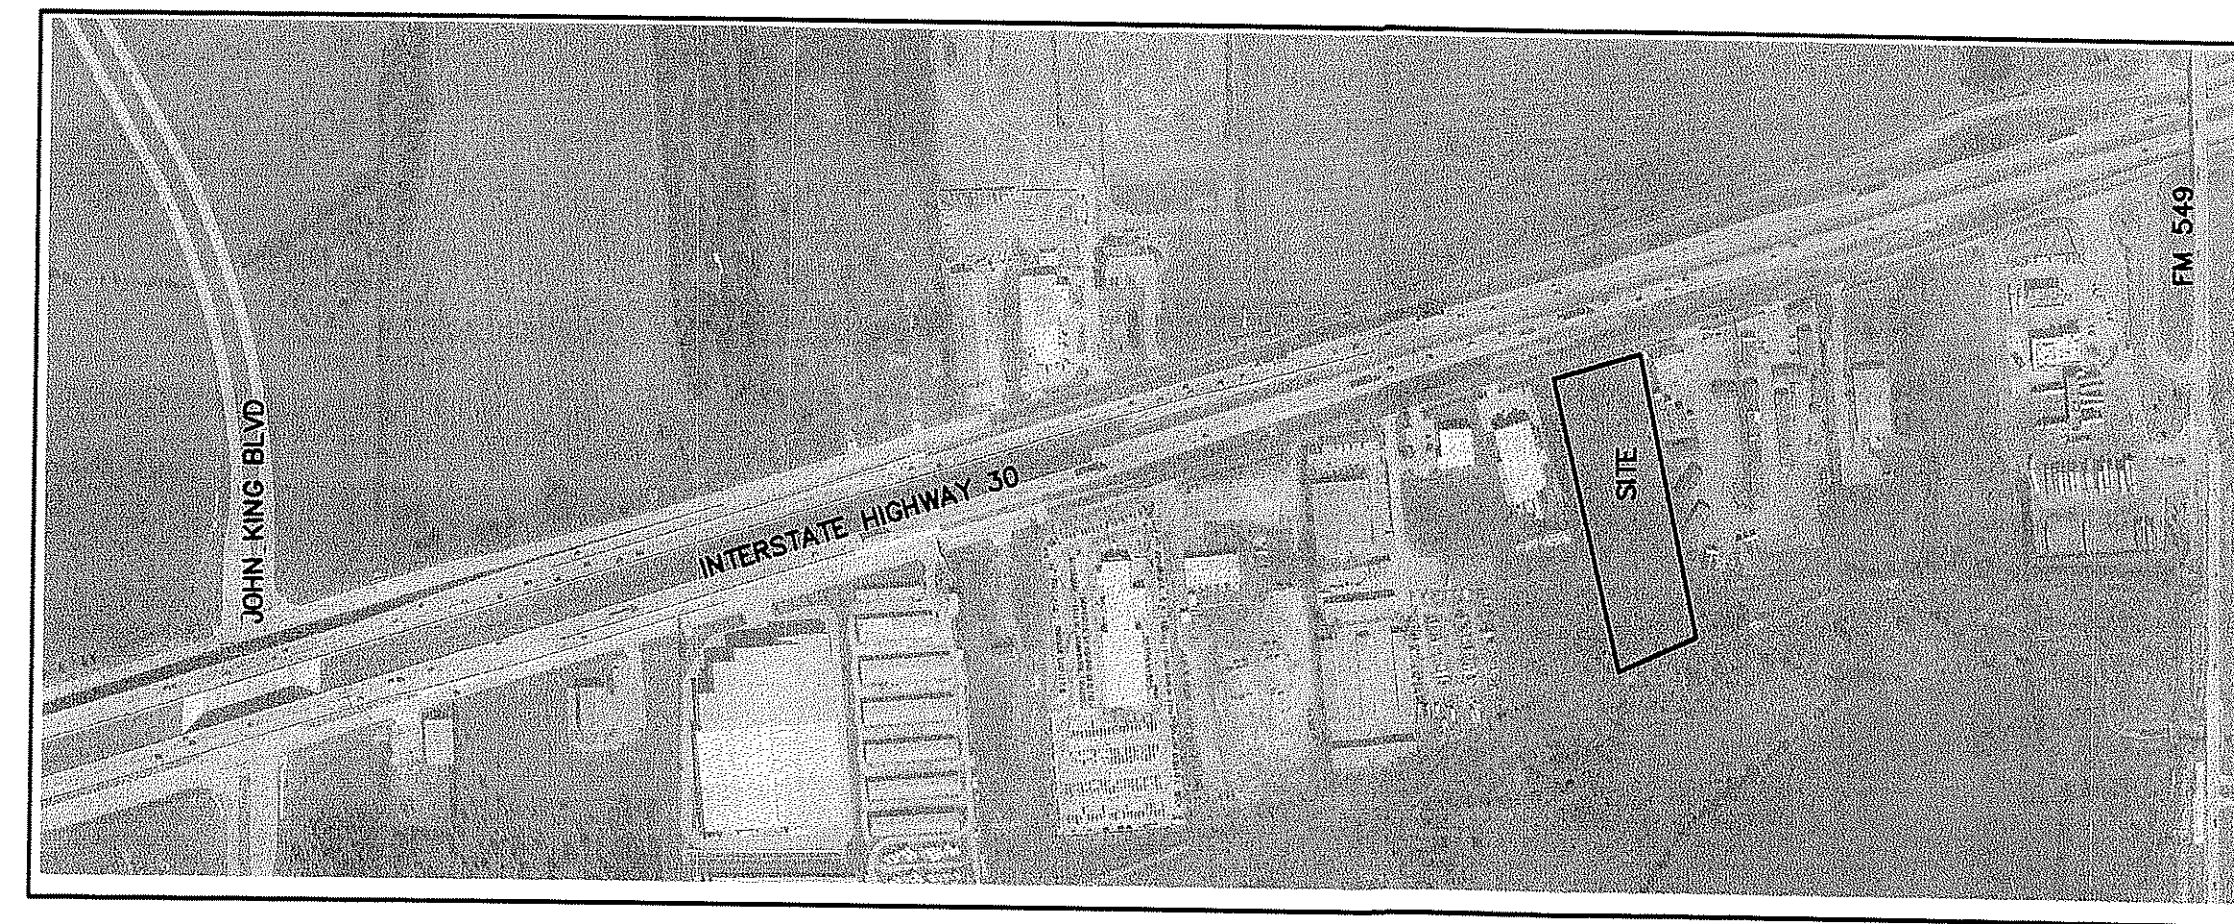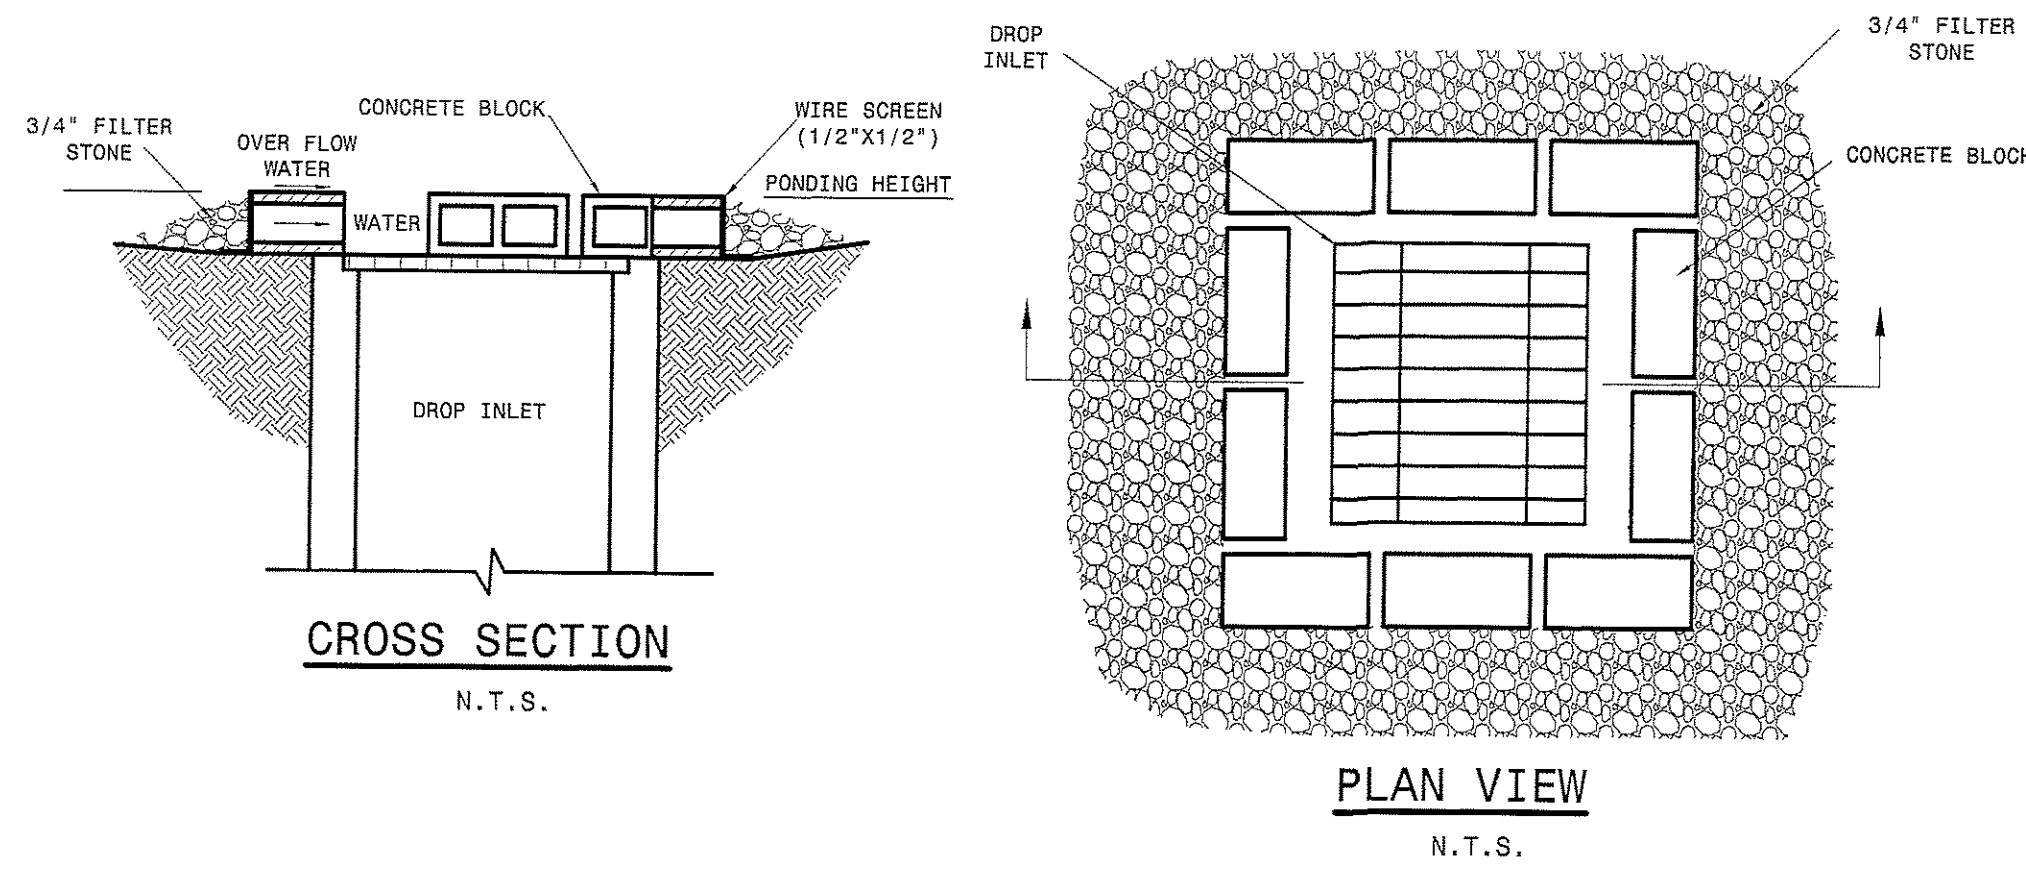

TOTAL SITE AREA = 3.27 ACRES
DISTURBED AREA = 3.27 ACRES

BENCHMARK:
RAILROAD SPIKE FOUND IN POWER POLE ALONG SERVICE ROAD.
ELEVATION = 587.40'


NOTES

1. EXISTING TOPOGRAPHY BASED ON SURVEY PREPARED BY H.D. FETTY LAND SURVEYOR LLC., DATED 08/11/2014.
2. SEE SHEET C3 FOR SITE GRADING.
3. SEE SHEET C6 FOR SITE DRAINAGE.
4. SEE SWPPP FOR ADDITIONAL INFORMATION.




RECORD DRAWING

TO THE BEST OF OUR KNOWLEDGE THE IMPROVEMENTS SHOWN ON THIS PLAN WERE COMPLETED IN GENERAL CONFORMANCE WITH THE DESIGN PLANS. THIS DETERMINATION WAS MADE BASED ON POST-CONSTRUCTION SURVEY DATA AND INFORMATION PROVIDED BY THE CONTRACTOR

SIGNED: *[Signature]* DATE: 11/21/16
VASQUEZ ENGINEERING, LLC
 TEXAS REG. F-12266

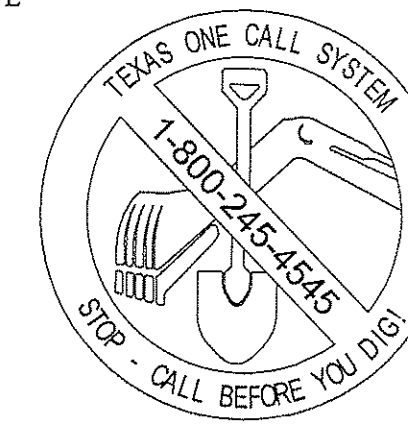


LOCATION MAP
N.T.S.

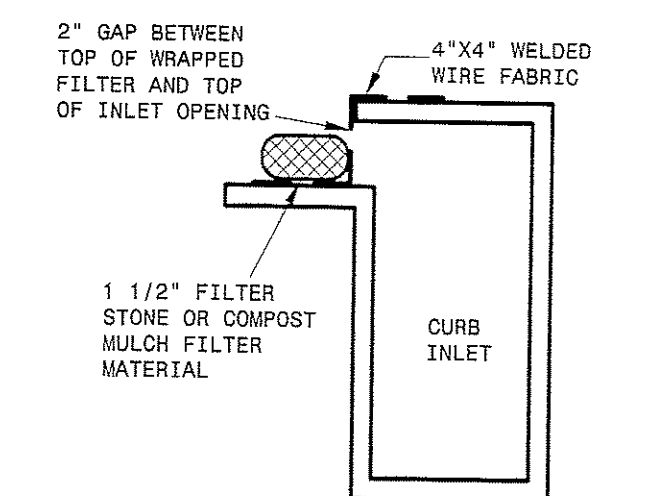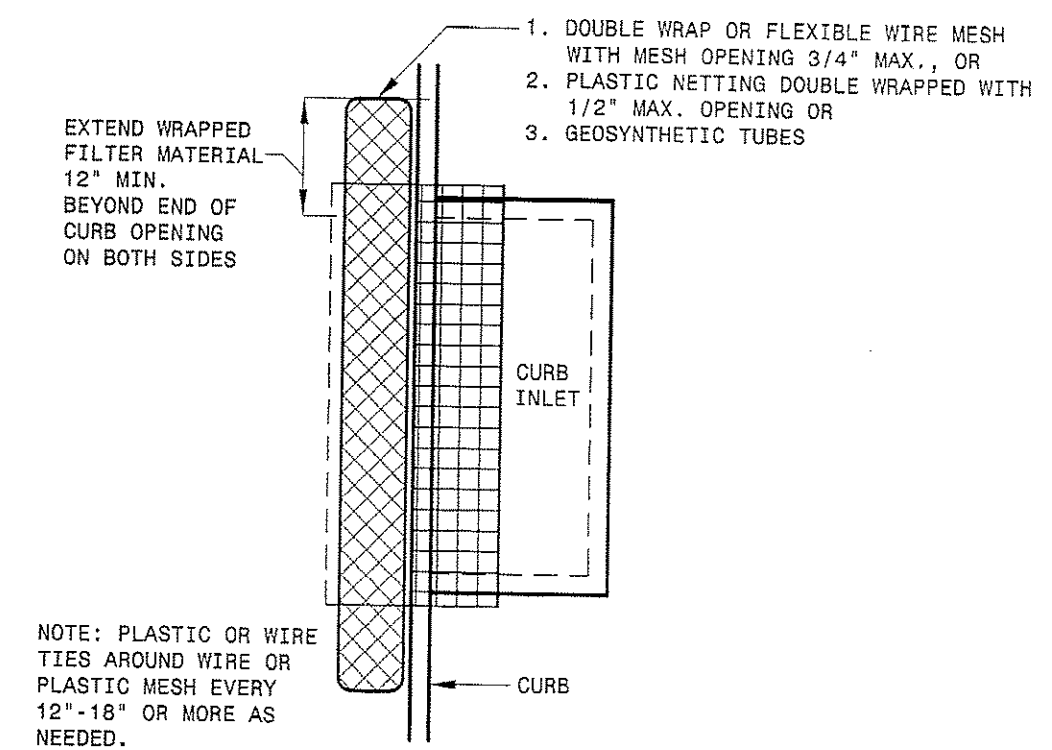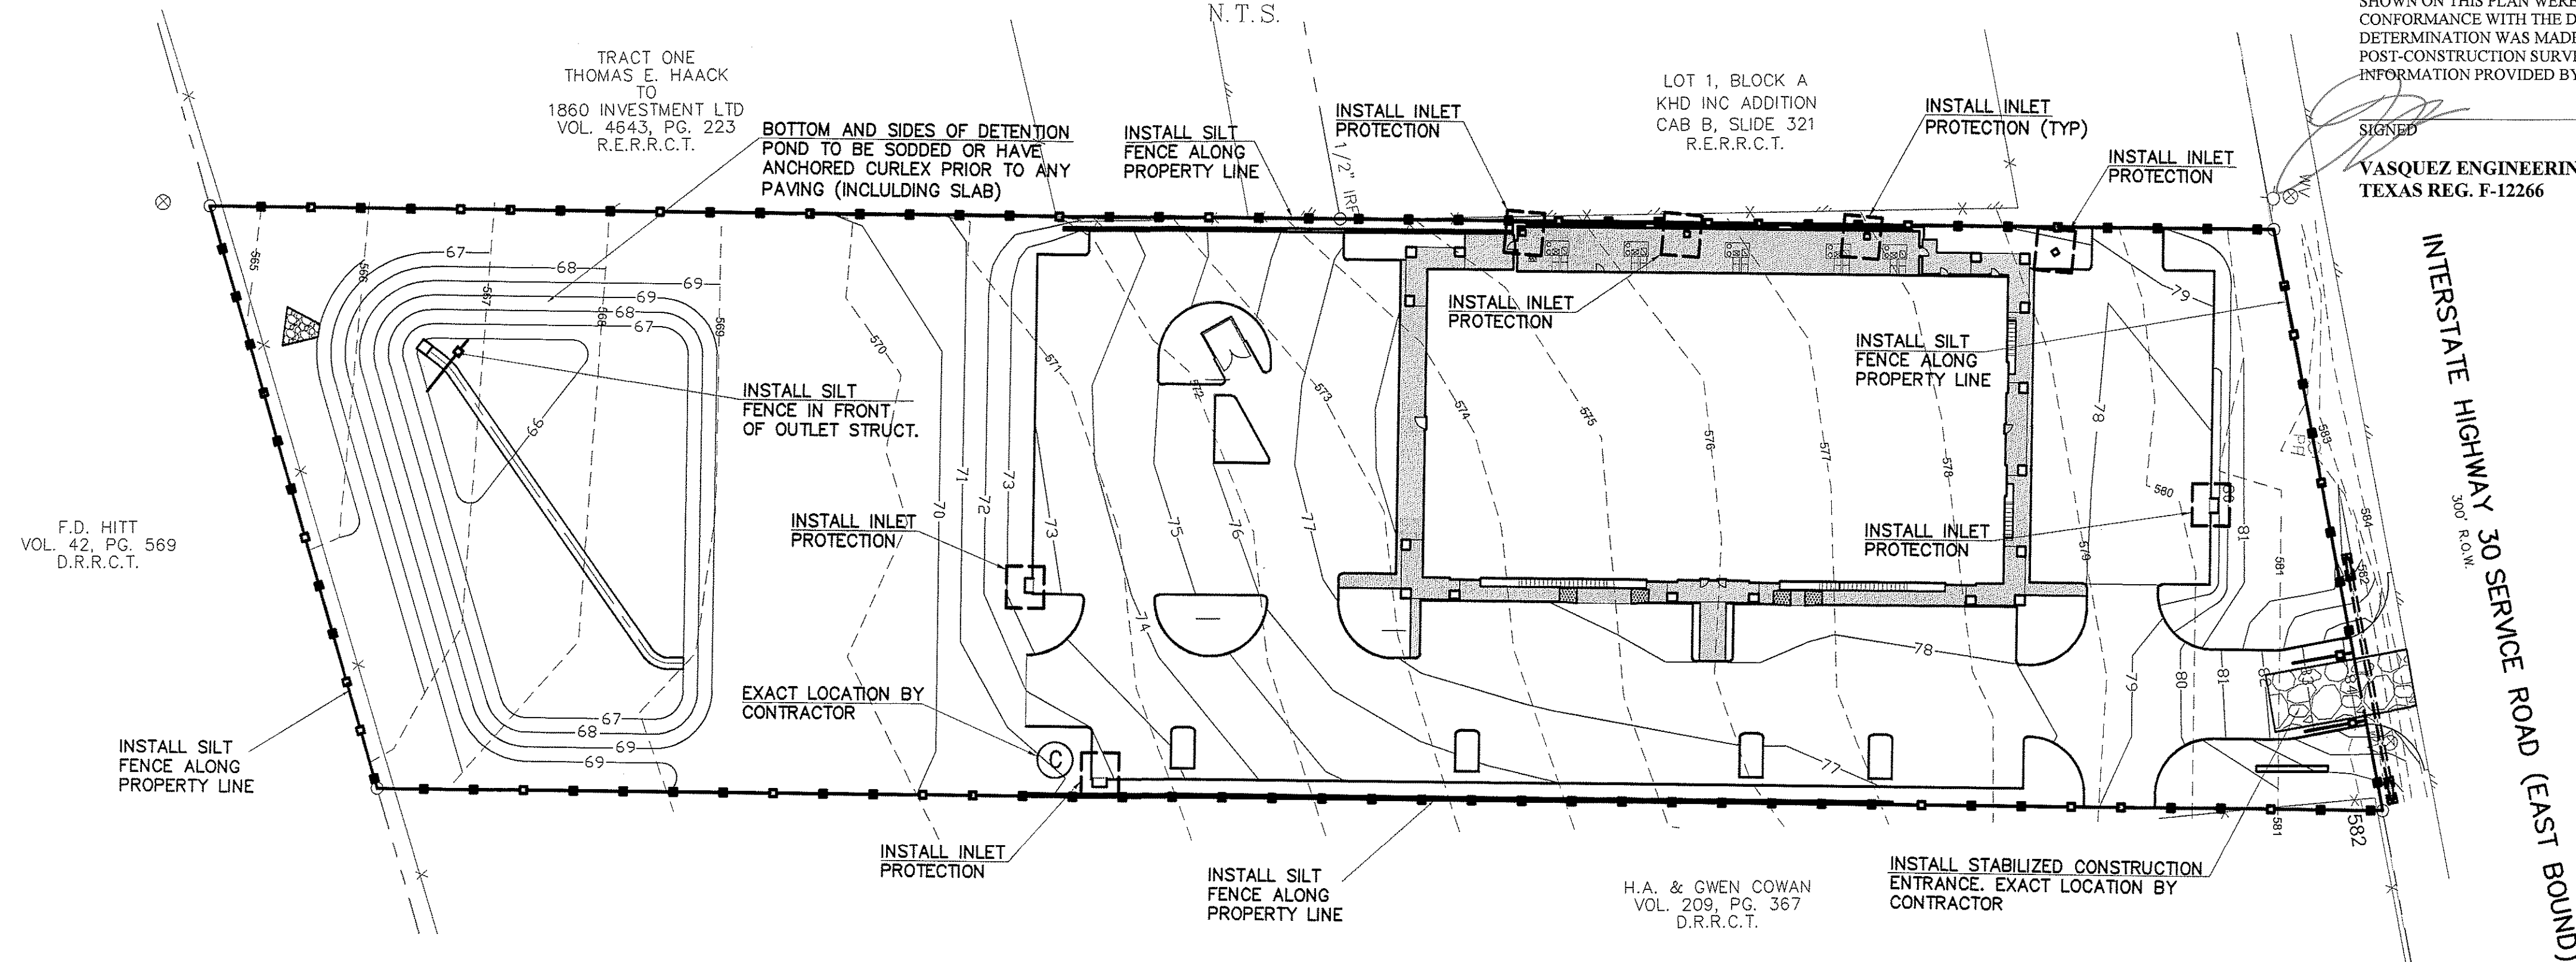




STABILIZED CONSTRUCTION ENTRANCE

1. STONE SIZE - 4 TO 6 INCHES OPEN GRADED ROCK.
2. LENGTH-AS EFFECTIVE, BUT NOT LESS THAN 50 FEET.
3. THICKNESS-NOT LESS THAN 12 INCHES.
4. WIDTH-NOT LESS THAN FULL WIDTH OF ALL POINTS OF INGRESS OR EGRESS.
5. WASHING-WHEN NECESSARY, WHEELS SHALL BE CLEANED TO REMOVE SEDIMENT PRIOR TO ENTRANCE ONTO PUBLIC ROADWAY. WHEN WASHING IS REQUIRED, IT SHALL BE DONE ON AN AREA STABILIZED WITH CRUSHED STONE WHICH DRAINS INTO AN APPROVED TRAP OR SEDIMENT BASIN. ALL SEDIMENT SHALL BE PREVENTED FROM ENTERING ANY STORM DRAIN, DITCH, OR WATERCOURSE USING APPROVED METHODS.
6. MAINTENANCE-THE ENTRANCE SHALL BE MAINTAINED IN A CONDITION WHICH WILL PREVENT TRACKING OR FLOWING OF SEDIMENT ONTO PUBLIC ROADWAYS. THIS MAY REQUIRE PERIODIC TOP DRESSING WITH ADDITIONAL STONE AS CONDITIONS DEMAND, AND REPAIR AND/OR CLEANOUT OF ANY MEASURES USED TO TRAP SEDIMENT. ALL SEDIMENT SPILLED DROPPED, WASHED OR TRACKED ONTO PUBLIC ROADWAY MUST BE REMOVED IMMEDIATELY.
7. DRAINAGE-ENTRANCE MUST BE PROPERLY GRADED OR INCORPORATE A DRAINAGE SWALE TO PREVENT RUNOFF FROM LEAVING THE CONSTRUCTION SITE.
8. PREVENT SHORTCUTTING OF THE FULL LENGTH OF THE CONSTRUCTION ENTRANCE BY INSTALLING BARRIERS AS NECESSARY.
9. INSPECTION SHALL BE AS SPECIFIED IN THE SWPPP.

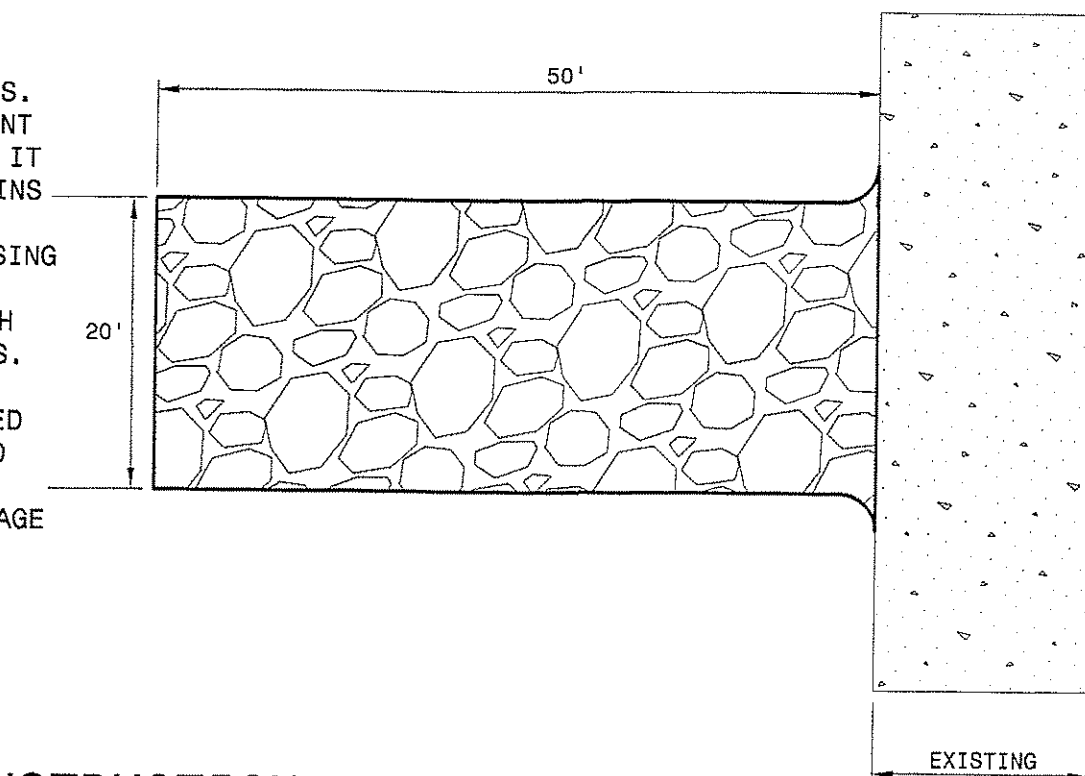


SILT FENCE


1. STEEL POST WHICH SUPPORT THE SILT FENCE SHALL BE INSTALLED ON A SLIGHT ANGLE TOWARD THE ANTICIPATED RUNOFF SOURCE. POST MUST BE EMBEDDED A MINIMUM OF ONE FOOT.
2. THE TOE OF THE SILT FENCE SHALL BE TRENCHED IN WITH A SPADE OR MECHANICAL TRENCHER, SO THAT THE DOWN SLOPE FACE OF THE TRENCH IS FLAT AND PERPENDICULAR TO THE LINE OF FLOW. WHERE FENCE CANNOT BE TRENCHED IN (E.G. PAVEMENT), WEIGHT FABRIC FLAP WITH ROCK ON UPHILL SIDE TO PREVENT FLOW FROM SEEPING UNDER FENCE.
3. THE TRENCH MUST BE A MINIMUM OF 6 INCHES DEEP AND 6 INCHES WIDE TO ALLOW FOR THE SILT FENCE FABRIC TO BE LAID IN THE GROUND AND BACKFILLED WITH COMPACTED MATERIAL.
4. SILT FENCE SHOULD BE SECURELY FASTENED TO EACH STEEL SUPPORT POST OR TO WOVEN WIRE, WHICH IS IN TURN ATTACHED TO THE STEEL FENCE POST. THERE SHALL BE A 3 FOOT OVERLAP, SECURELY FASTENED WHERE ENDS OF FABRIC MEET.
5. INSPECTION SHALL BE MADE WEEKLY AND AFTER EACH RAINFALL. REPAIR OR REPLACEMENT SHALL BE MADE PROMPTLY AS NEEDED.
6. SILT FENCE SHALL BE REMOVED WHEN THE SITE IS COMPLETELY STABILIZED SO AS NOT TO BLOCK OR IMPEDE STORM FLOW OR DRAINAGE.
7. ACCUMULATED SILT SHALL BE REMOVED WHEN IT REACHES A DEPTH OF HALF THE HEIGHT OF THE FENCE. THE SILT SHALL BE DISPOSED OF AT AN APPROVED SITE AND IN SUCH A MANNER AS TO NOT CONTRIBUTE TO ADDITIONAL SILTATION.

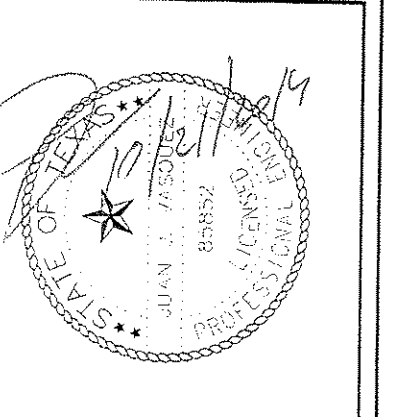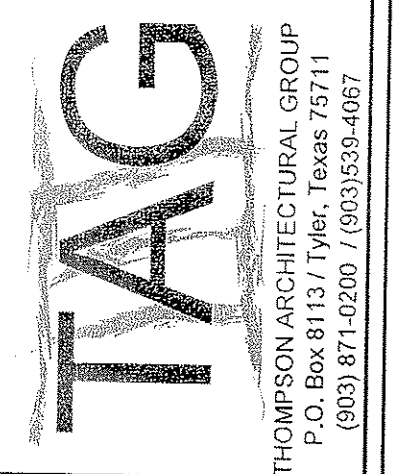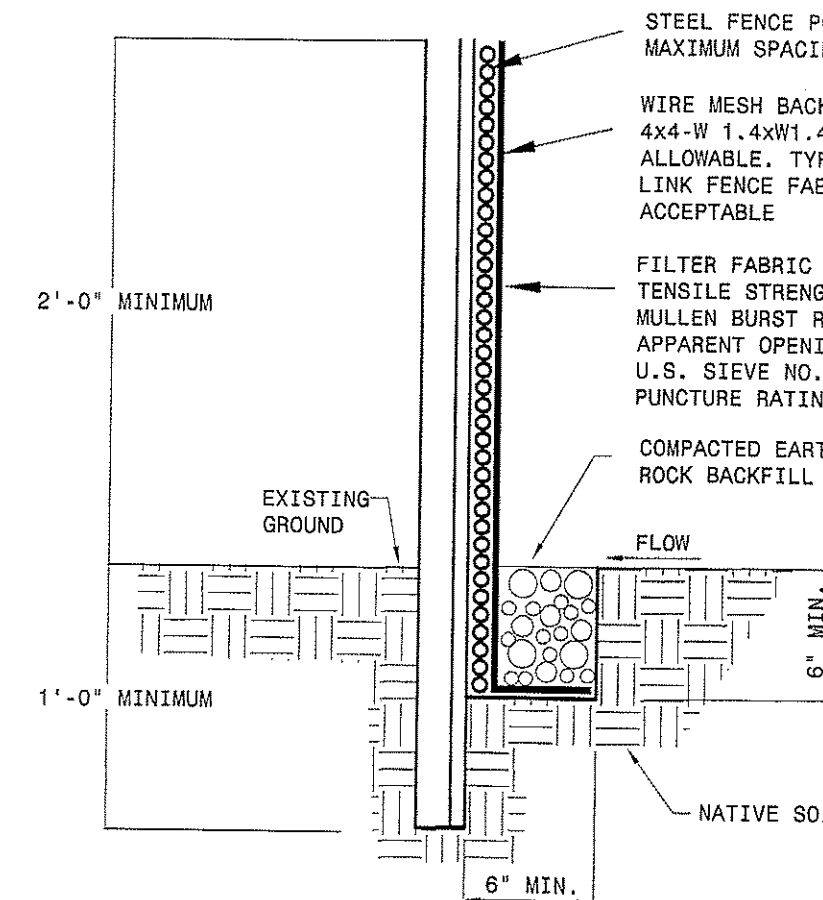

VASQUEZ ENGINEERING L.L.C.
 1919 S. Shiloh Road
 Suite 440, LB 44
 Garland, Texas 75042
 Ph: 972-278-2948
 TX Registration # F-12266

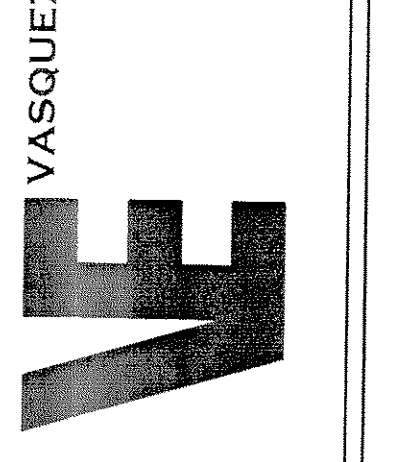

A New Facility for
Cavender's Boot City
 I.H. 30
 Rockwall, Texas

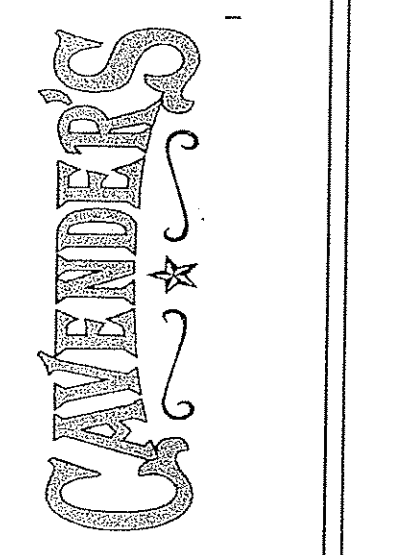


EROSION CONTROL PLAN


Revision/Revision Date

Project Number 560-11
 Date 10/21/14
 Drawn By J.J.V.
 Checked By J.J.V.


C5

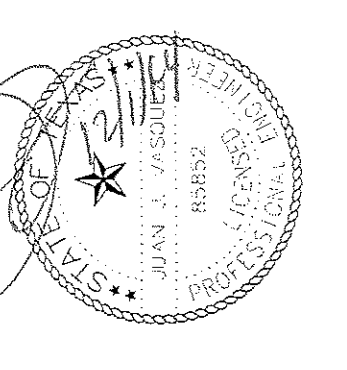

VASQUEZ ENGINEERING L.L.C.
1919 S. Shiloh Road
Suite 440, LB 44
Garland, Texas 75042
Ph: 972-276-2948
TX Registration # F-12266

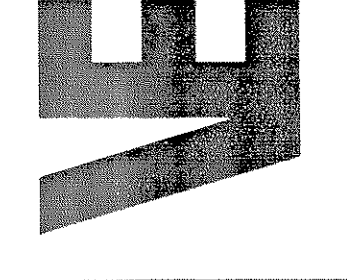

A New Facility for
Cavender's Boot City
I.H. 30
Rockwall, Texas

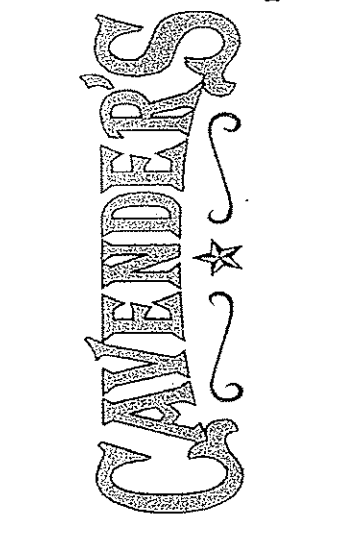

UTILITY PLAN

Revision/Revision Date

Project Number 560-11
Date 12/01/14
Drawn By J.J.V.
Checked By J.J.V.

C7

NOTES:


- EXISTING TOPOGRAPHY BASED ON SURVEY PREPARED BY H.D. FETTY LAND SURVEYOR, LLC, DATED 8/11/2014.
- SEE SHEET C6 FOR DRAINAGE DESIGN.

BENCHMARK:


RAILROAD SPIKE FOUND IN A POWER POLE ALONG SERVICE ROAD.
ELEVATION = 582.40'

UTILITY NOTES:

- 6" AND 8" WATER PIPE WILL BE C900 PVC WATER PIPE CLASS 200 DR 14.
- ALL WORK SHALL BE IN ACCORDANCE WITH THE CITY'S STANDARDS AND SPECIFICATIONS AND NCTCOG 3RD EDITION.
- CONTRACTOR SHALL COORDINATE ALL CONNECTIONS TO PUBLIC MAINS WITH THE CITY.
- ALL TRENCHING SHALL BE IN ACCORDANCE WITH LATEST OSHA STANDARDS AND SPECIFICATIONS.
- BUILDING FIRE MAIN, FIRE RISER AND FIRE DEPARTMENT CONNECTION SHALL BE INSTALLED BY A LICENSED FIRE SPRINKLER CONTRACTOR IN THE STATE OF TEXAS.
- CONTRACTOR SHALL CALL FOR UTILITY LOCATES AT LEAST 48 HRS PRIOR TO BEGINNING CONSTRUCTION.
- CONTRACTOR SHALL ADJUST ALL UTILITY APPURTENANCES TO FINAL GRADE.
- WATER AND SEWER CROSSINGS SHALL BE PER THE LATEST TCEQ REQUIREMENTS.
- REFERENCE MEP PLANS FOR EXACT BUILDING ENTRY POINTS FOR UTILITY SERVICES.
- CONTRACTOR SHALL NOTIFY ENGINEER OF ANY UTILITY CONFLICTS AS SOON AS POSSIBLE.
- CONTRACTOR SHALL COORDINATE ALL INSPECTIONS AND TESTING WITH THE CITY.
- INSTALL BLUE EMS DISKS ON THE WATER LINE AT EVERY CONNECTION, CHANGE IN DIRECTION, VALVE AND FIRE HYDRANT.

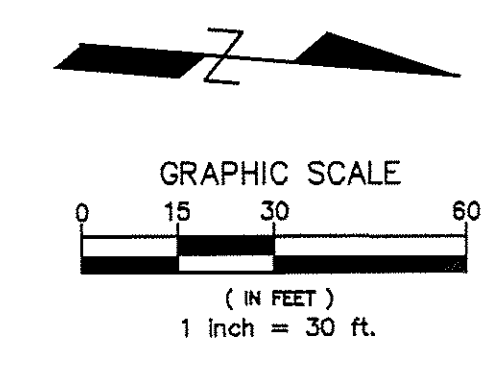

EXISTING	LEGEND	PROPOSED
---	PROPERTY LINE	---
---	PAVEMENT	---
W	WATER LINE	6" FIRE
SS	SAN. SEW. LINE	4" SS
OHE	OVERHEAD ELECTRIC	E
TELE	TELE LINE	T
---	STORM SEWER	SD
---	LIGHT POLE	●

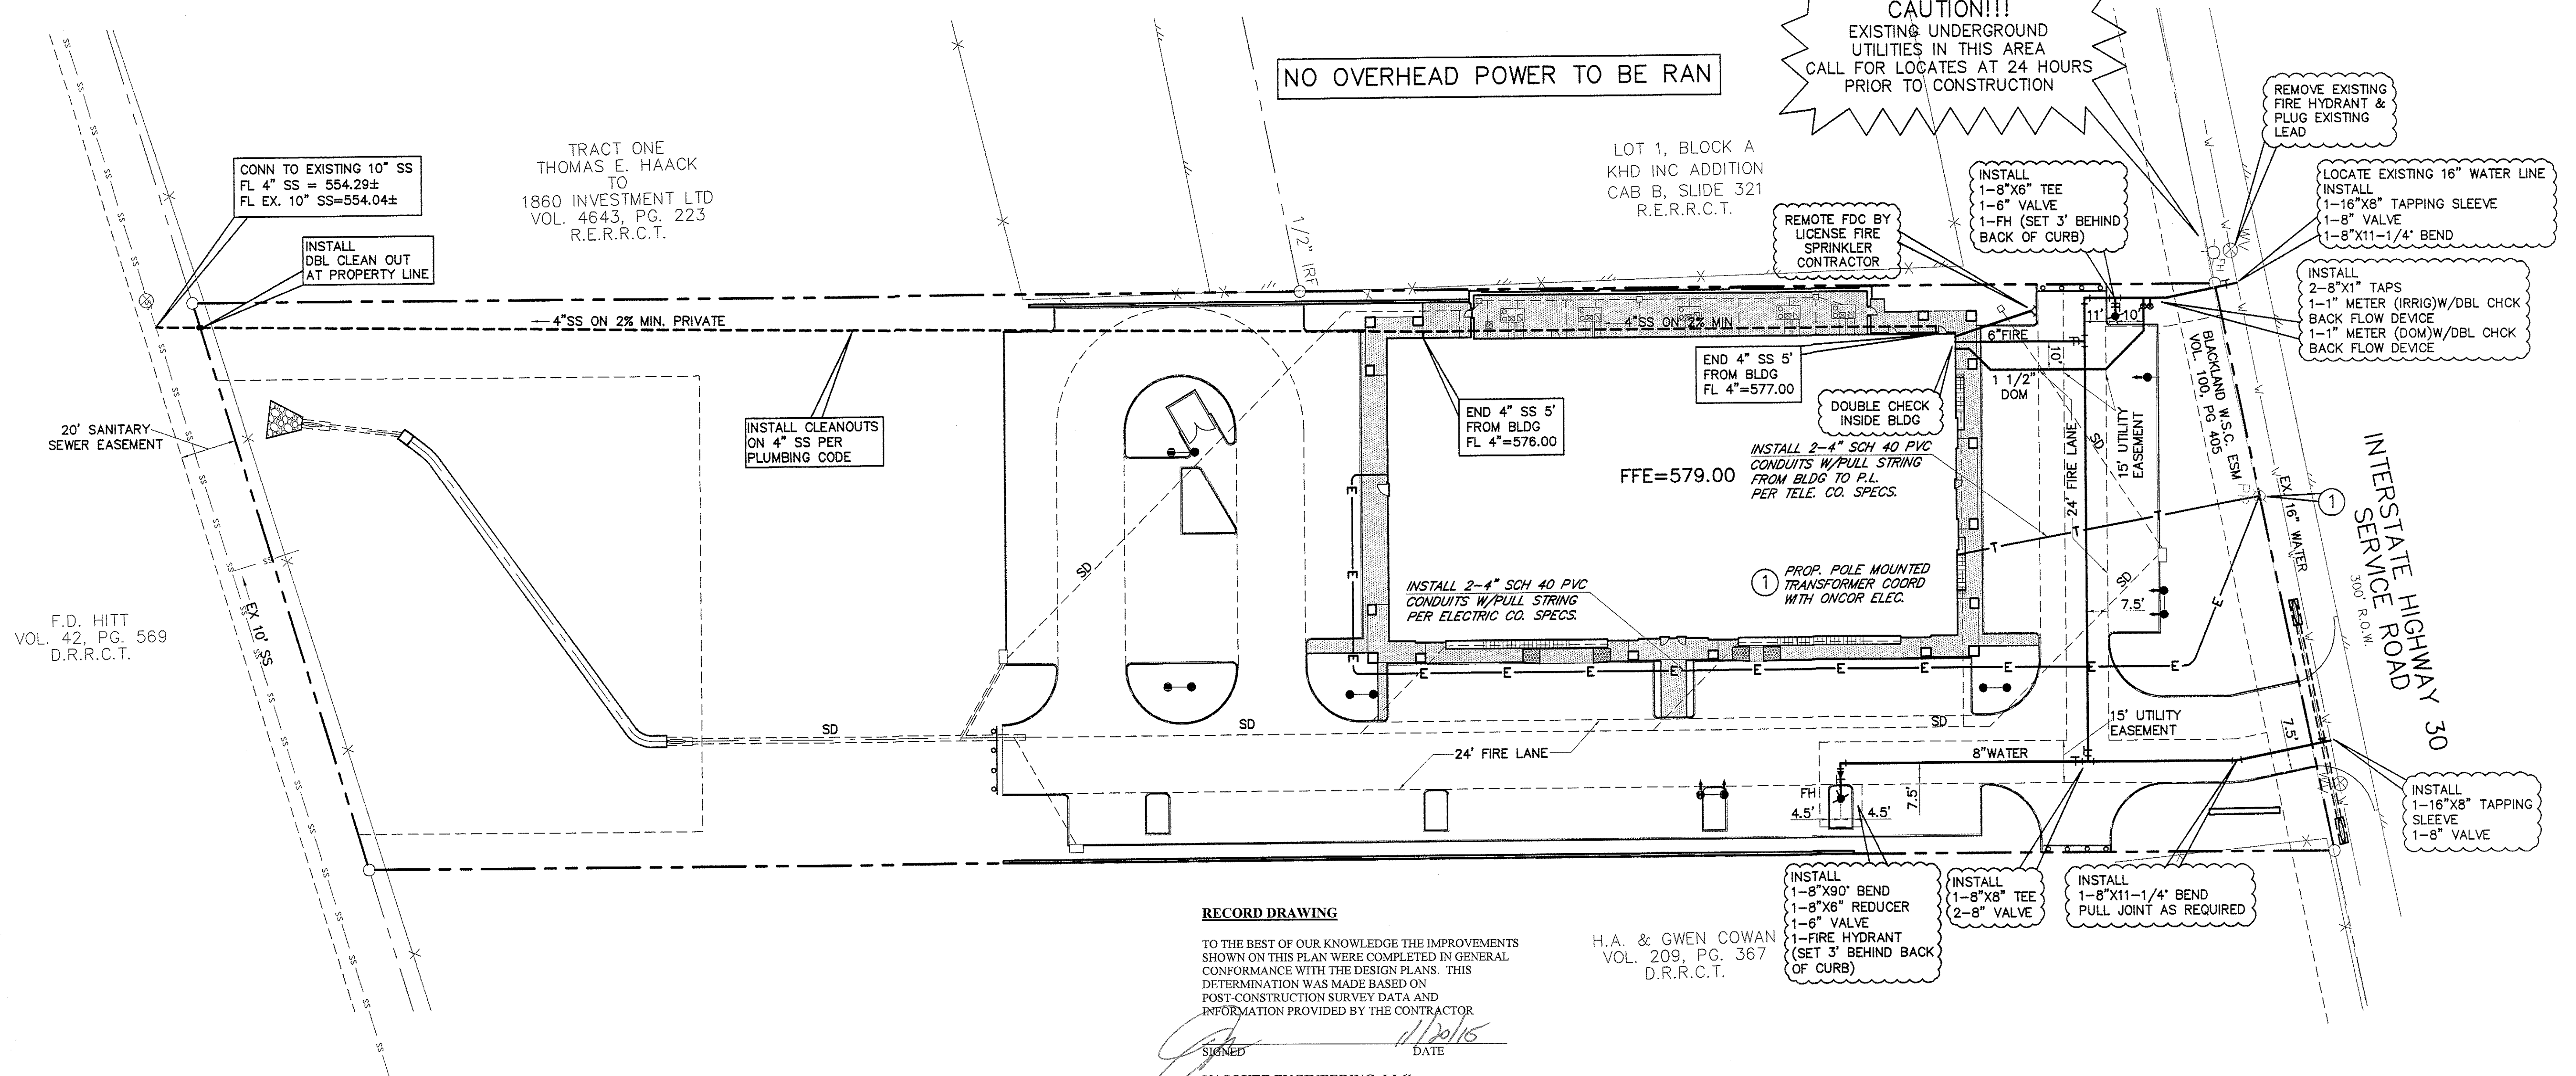

RECORD DRAWING
TO THE BEST OF OUR KNOWLEDGE THE IMPROVEMENTS SHOWN ON THIS PLAN WERE COMPLETED IN GENERAL CONFORMANCE WITH THE DESIGN PLANS. THIS DETERMINATION WAS MADE BASED ON POST-CONSTRUCTION SURVEY DATA AND INFORMATION PROVIDED BY THE CONTRACTOR


SIGNED: *[Signature]* DATE: 11/20/16
VASQUEZ ENGINEERING, LLC
 TEXAS REG. F-12266

H.A. & GWEN COWAN
VOL. 209, PG. 367
D.R.R.C.T.

TRACT ONE
THOMAS E. HAACK
TO
1860 INVESTMENT LTD
VOL. 4643, PG. 223
R.E.R.R.C.T.


F.D. HITT
VOL. 42, PG. 569
D.R.R.C.T.

INTERSTATE HIGHWAY 30
SERVICE ROAD
300' R.O.W.

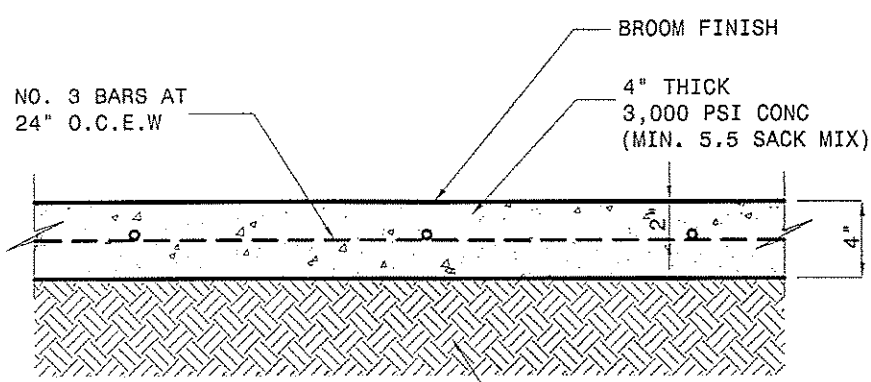


- NOTES:
1. TOOLED JOINTS AT 5' MAXIMUM SPACING.
 2. EXPANSION JOINTS AT 30' MAXIMUM SPACING.
 3. 2% MAXIMUM CROSS SLOPE.

ON-SITE SIDEWALK DETAIL
NTS

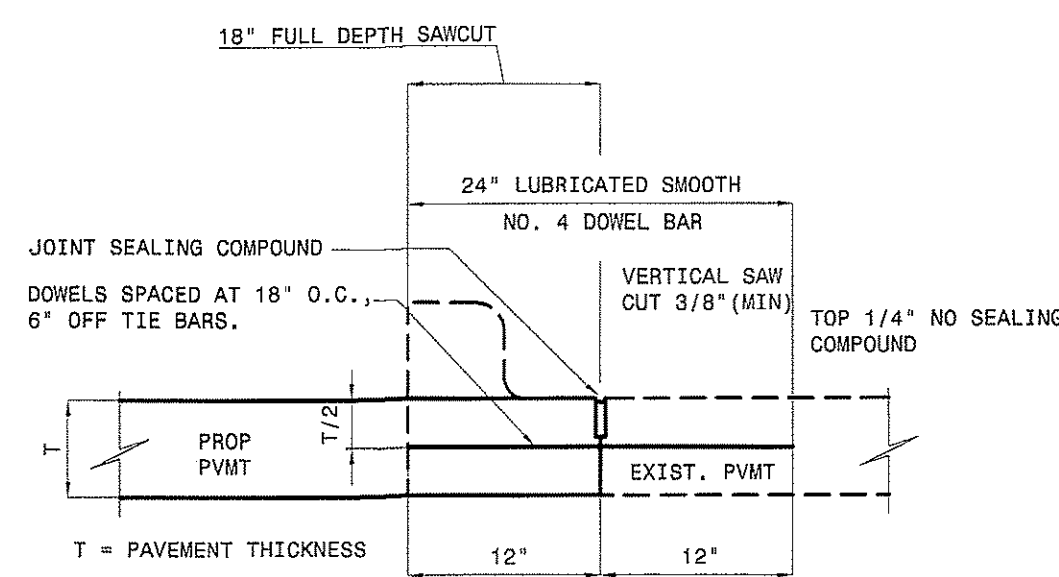


- NOTE:
- Dowel bars shall be drilled into pavement horizontally by use of a mechanical rig. Drilling by hand is not acceptable and pushing dowel bars into green concrete is not acceptable.

LONGITUDINAL BUTT JOINT
NTS

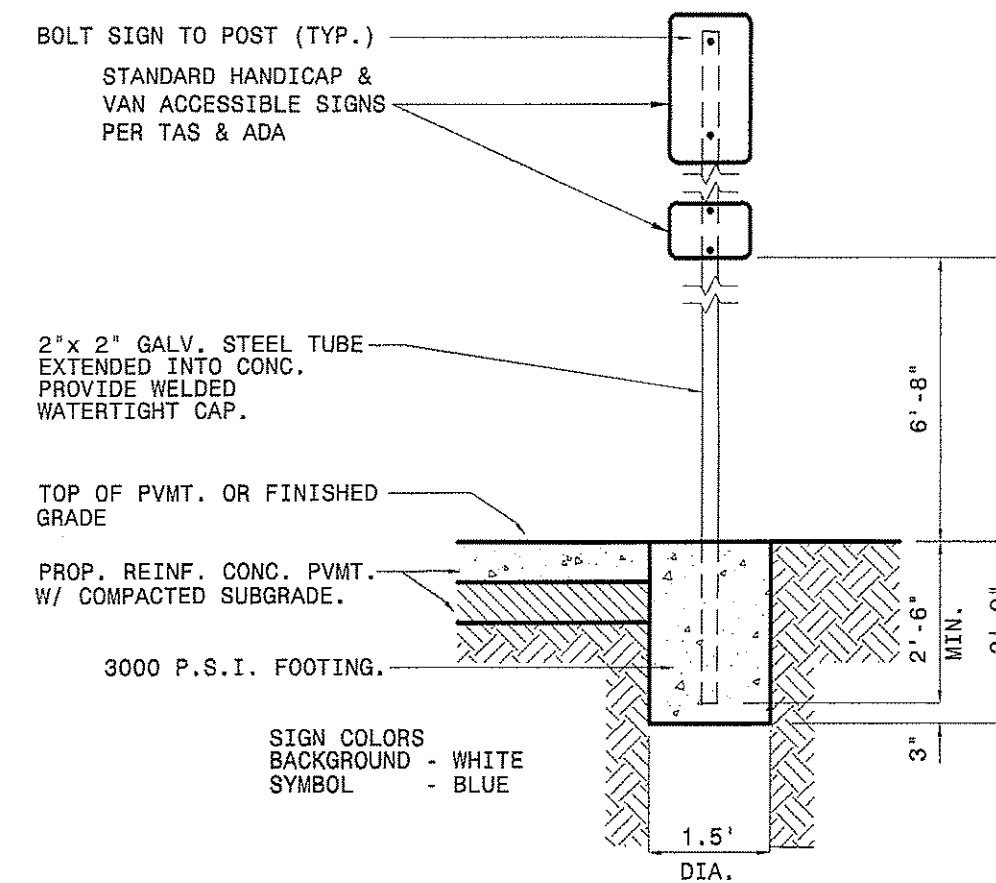


ACCESSIBLE SIGN DETAIL
NTS

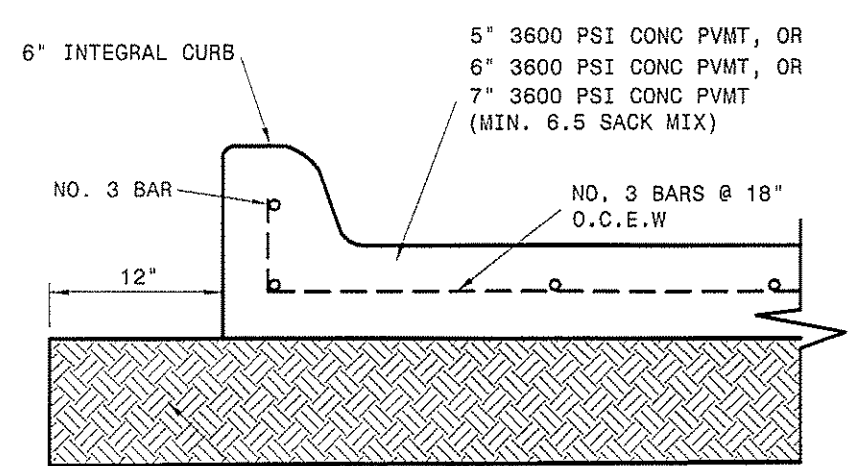


- NOTES:
1. PAVEMENT AND SUBGRADE RECOMMENDATIONS PER GEOTECHNICAL REPORT PREPARED BY TERRACON PROJECT NO. 94145145, DATED 06/26/2014.
 2. AREAS TO BE PAVED SHALL EXCAVATED BELOW THE PROPOSED FINISHED SUBGRADE REFER TO GEOTECHNICAL REPORT FOR RECOMMENDATIONS.
 3. SUBGRADE MAYBE LIME STABILIZED TO ASSIST IN COMPACTION REFER TO GEOTECHNICAL REPORT FOR RECOMMENDATIONS.
 4. CONCRETE TO BE AIR ENTRAINED BETWEEN 3 AND 6%.
 5. SAW JOINTS TO BE AT 15' O.C. MAX.
 6. EXPANSION JOINTS SHALL BE AS NOTED ON PLAN.


ON-SITE CONCRETE PVMT SECTION
NTS

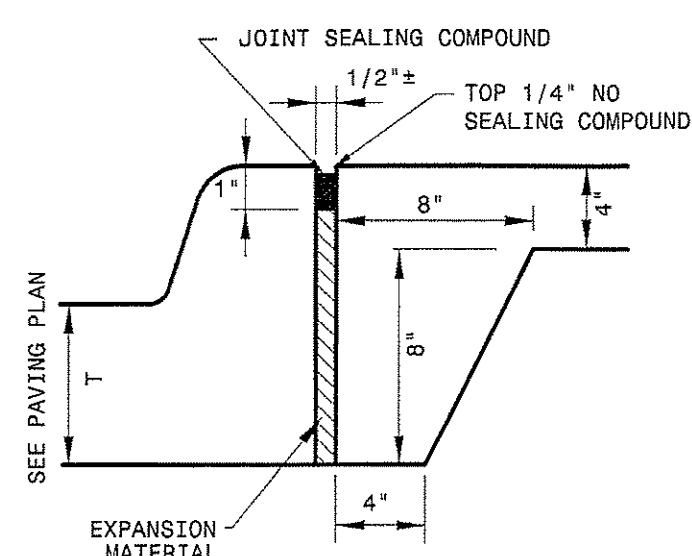


SIDEWALK/CURB DETAIL
NTS

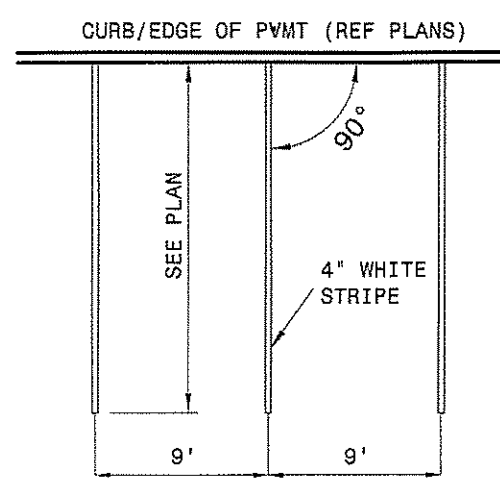


STANDARD PARKING STALL DETAIL
NTS

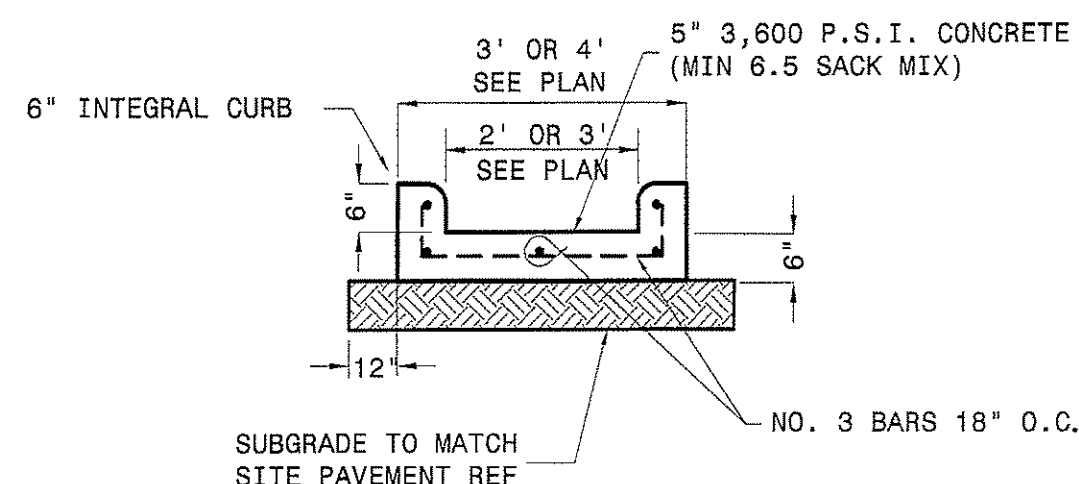


FLUME DETAIL
NTS

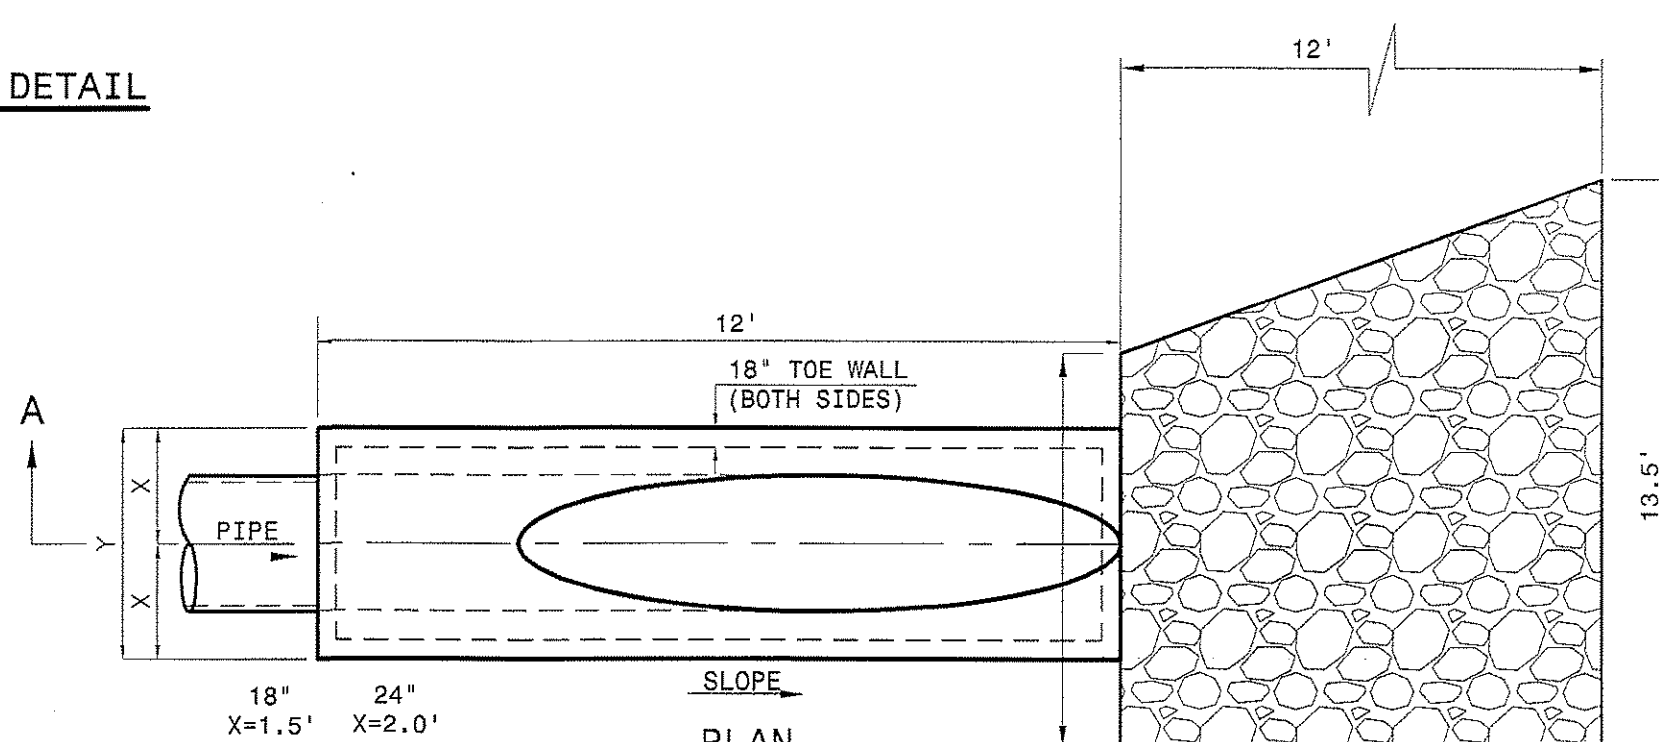


SECTION A-A
NTS

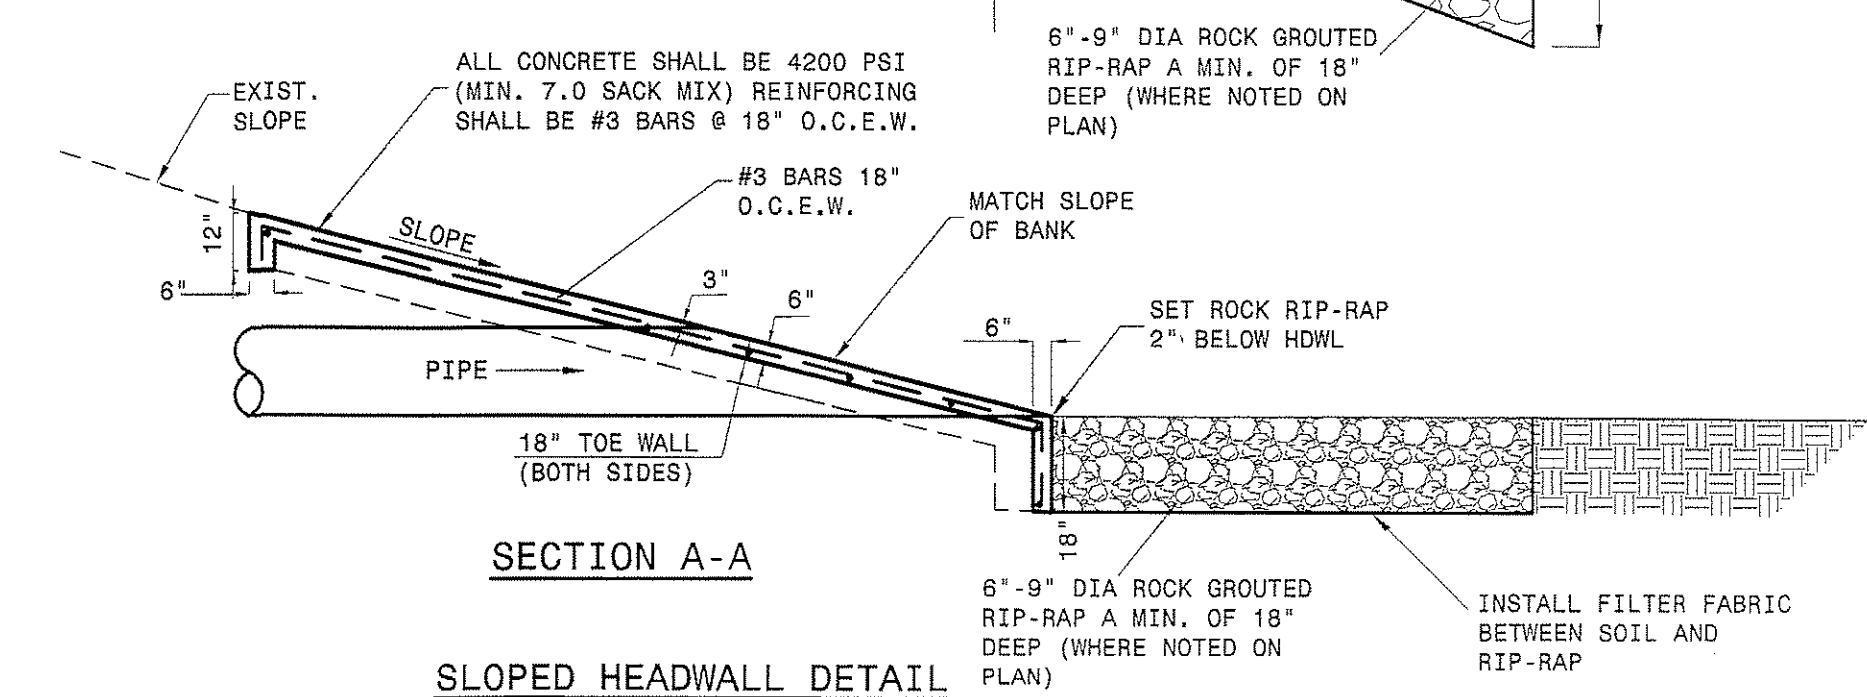

SLOPED HEADWALL DETAIL
NTS

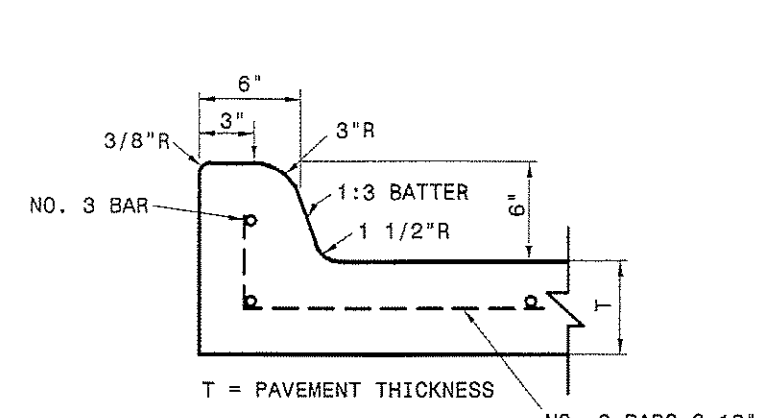

INTEGRAL CURB
NTS

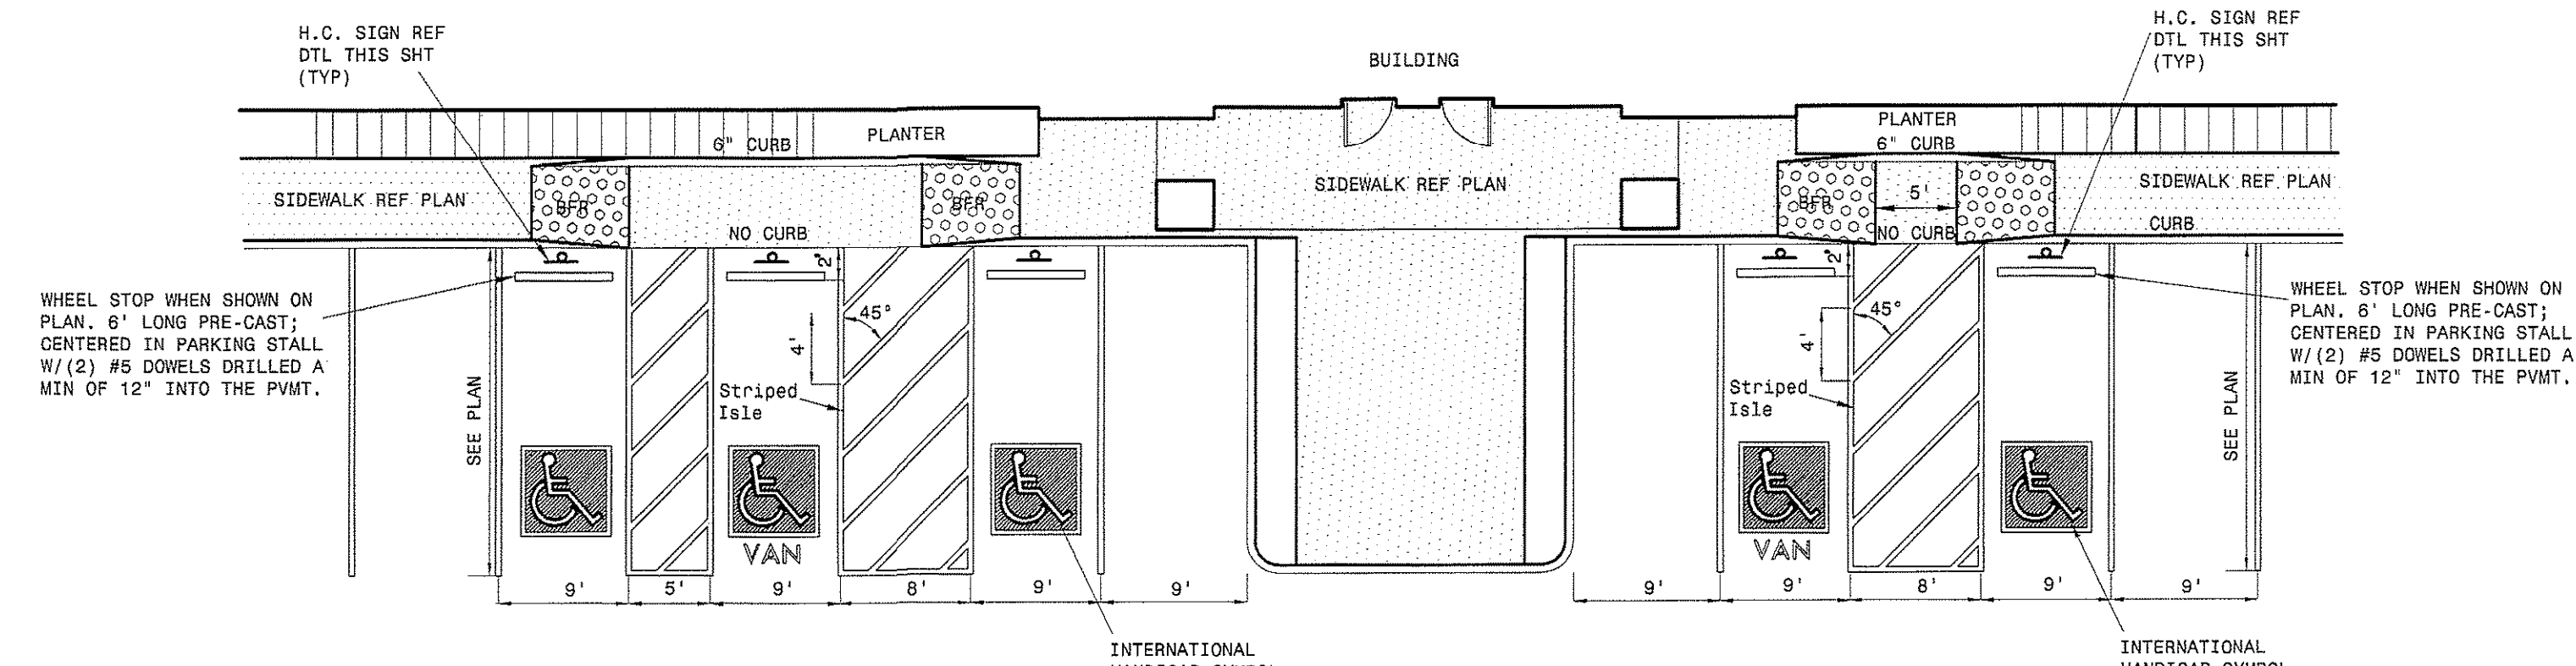

ACCESSIBLE PARKING DETAIL (TYPICAL)
NTS


Symbols, striping, signage and barrier free ramps shall meet current TDLR/ADA standards.

Symbols, striping, signage and barrier free ramps shall meet current ADA standards.

RECORD DRAWING

TO THE BEST OF OUR KNOWLEDGE THE IMPROVEMENTS SHOWN ON THIS PLAN WERE COMPLETED IN GENERAL CONFORMANCE WITH THE DESIGN PLANS. THIS DETERMINATION WAS MADE BASED ON POST-CONSTRUCTION SURVEY DATA AND INFORMATION PROVIDED BY THE CONTRACTOR

SIGNED: *[Signature]* DATE: 11/20/10
VASQUEZ ENGINEERING, LLC
 TEXAS REG. F-12266

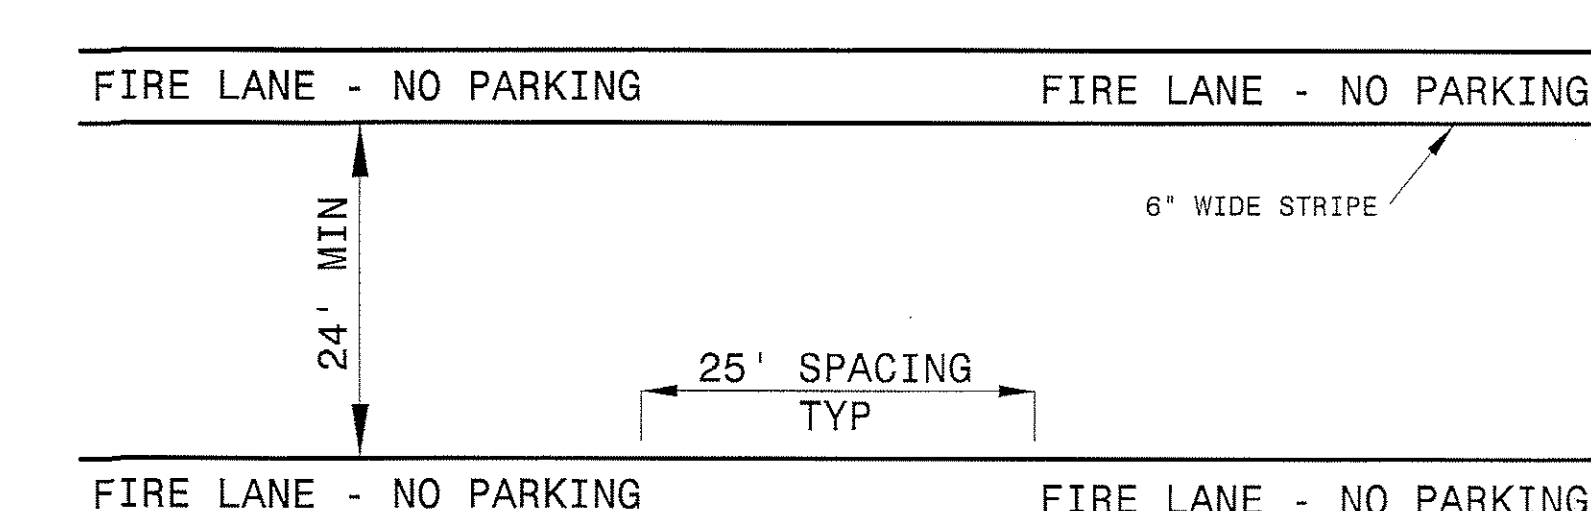

FIRE LANE STRIPING DETAIL
NTS



FIRE LANE NOTES:

1. STRIPE SHALL BE SIX(6) INCHES WIDE PAINTED "TRAFFIC RED". PAINT TO BE PER CITY SPECIFICATIONS.
2. LETTERS SHALL BE FOUR(4) INCHES HIGH PAINTED "TRAFFIC WHITE". PAINT TO BE PER CITY SPECIFICATIONS.
3. STRIPE MAY BE BRUSHED OR SPRAYED, ONE COAT TO FINISH. LETTERS SHALL BE STENCIL FORMED, BRUSH APPLIED AND SPACED AS DETAILED ON THIS SHEET.
4. WHERE IS AVAILABLE, THE STRIPPING SHALL BE ON BOTH THE VERTICAL AND HORIZONTAL FACES OF THE CURB.
5. COORDINATE WITH CITY FIRE DEPARTMENT PRIOR TO STRIPING.


GENERAL NOTES

1. THE CONTRACTOR SHALL BE RESPONSIBLE FOR BEING FAMILIAR WITH THE PLANS AND SPECIFICATIONS FOR THIS PROJECT, THE PROJECT AREA, AND ALL CODES, REGULATIONS OR LAWS APPLICABLE TO THE PROJECT.
2. ALL CONSTRUCTION SHALL BE PER CITY STANDARDS, TXDOT STANDARDS AND NCTCOG 3RD EDITION.
3. OWNER SHALL DESIGNATE A STAGING AREA FOR THE CONTRACTOR. NO STORAGE OF EQUIPMENT OR MATERIALS SHALL BE PERMITTED WITHOUT PERMISSION OF THE OWNER.
4. CONTRACTOR SHALL MAINTAIN THE SITE IN A NEAT AND ORDERLY FASHION AND DISPOSE OF EXCESS MATERIALS AND DEBRIS BY LEGAL MEANS OFF SITE. NO DEBRIS SHALL BE BURIED ON SITE.
5. UTILITIES SHOWN ARE AT APPROXIMATE LOCATIONS BASED ON AVAILABLE PLANS AND NOT ALL UTILITIES MAY BE SHOWN. CONTRACTOR IS RESPONSIBLE FOR LOCATING ALL UTILITIES PRIOR TO CONSTRUCTION AND SHALL NOTIFY THE CITY AND ENGINEER OF POTENTIAL CONFLICTS WITH THE PLANS PRIOR TO CONSTRUCTION.
6. ALL DIMENSION SHOWN ARE TO THE FACE OF CURB, EDGE OF PAVEMENT, OR CENTERLINE OF PIPE/CHANNEL UNLESS OTHERWISE NOTED.
7. CONTRACTOR IS RESPONSIBLE FOR PROTECTION OF EXISTING UTILITIES AND SITE FEATURES DURING CONSTRUCTION. CONTRACTOR SHALL REPAIR ANY DAMAGED UTILITIES OR SITE FEATURES TO A LIKE NEW CONDITION AT CONTRACTORS EXPENSE PRIOR TO FINAL APPROVAL OF THE CONSTRUCTION BY OWNER.


THE SEAL APPEARING ON THIS DOCUMENT IS THE PROPERTY OF
 JUAN J. VASQUEZ, P.E. 68862, ON
 09/22/2014

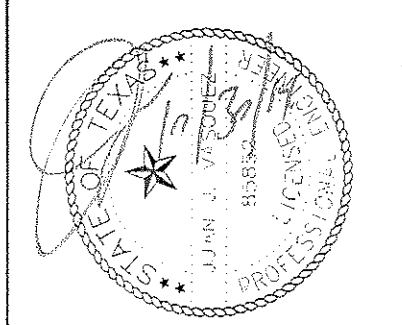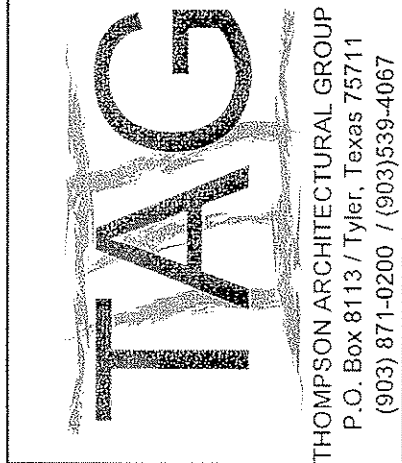

VASQUEZ ENGINEERING L.L.C.
 1919 S. Shiloh Road
 Suite 440, LB 44
 Garland, Texas 75042
 Ph: 972-278-2948
 TX Registration # F-12266

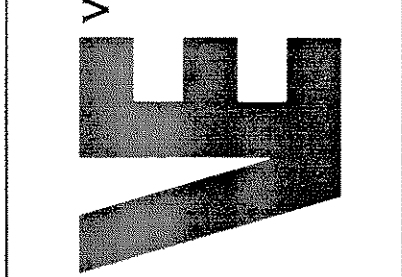

A New Facility for
Cavender's Boot City
 I.H. 30
 Rockwall, Texas

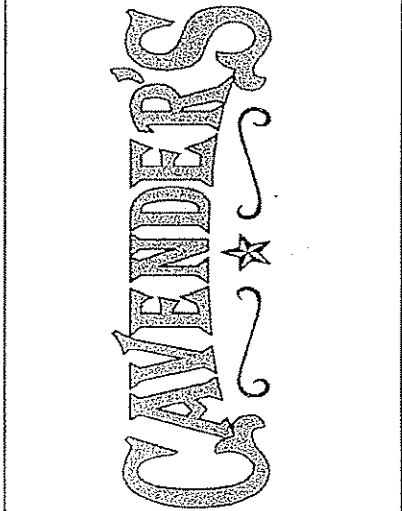

DETAILS & GENERAL NOTES

Revision/Revision Date

Project Number 560-11
 Date 10/30/14
 Drawn By J.J.V.
 Checked By J.J.V.

C8

SECTION 32 9300 - LANDSCAPE

PART 1 - GENERAL

- 1.1 REFERENCE DOCUMENTS
 - A. REFER TO LANDSCAPE PLANS, NOTES, AND DETAILS FOR ADDITIONAL REQUIREMENTS
- 1.2 DESCRIPTION OF WORK
 - A. FURNISH ALL LABOR, MATERIALS, EQUIPMENT, AND SERVICES NECESSARY TO PROVIDE ALL WORK, COMPLETE IN AS SHOWN AND SPECIFIED. WORK SHOULD INCLUDE:
 - a. PLANTING OF TREES, SHRUBS AND GRASSES
 - b. SEEDING
 - c. BED PREPARATION AND FERTILIZATION
 - d. WATER AND MAINTENANCE UNTIL FINAL ACCEPTANCE
 - e. WORK GUARANTEE
- 1.3 REFERENCES
 - A. AMERICAN NATIONAL STANDARDS INSTITUTE (ANSI) Z60.1 - NURSERY STOCK
 - B. TEXAS STATE DEPARTMENT OF AGRICULTURE
 - C. TEXAS ASSOCIATION OF NURSERYMEN, GRADES AND STANDARDS
- 1.4 SUBMITTALS
 - A. PROVIDE REPRESENTATIVE QUANTITIES OF EACH SOIL, MULCH, BED MIX, GRAVEL AND STONE BEFORE INSTALLATION. SAMPLES TO BE APPROVED BY OWNER'S REPRESENTATIVE BEFORE USE.
 - B. SOIL AMENDMENTS AND FERTILIZERS SHOULD BE RESEARCHED AND BASED ON THE SOILS IN THE AREA.
 - C. BEFORE INSTALLATION, SUBMIT DOCUMENTATION THAT PLANT MATERIALS ARE AVAILABLE AND HAVE BEEN RESERVED. FOR ANY PLANT MATERIAL NOT AVAILABLE, SUBMIT REQUEST FOR SUBSTITUTION.
- 1.5 JOB CONDITIONS, DELIVERY, STORAGE AND HANDLING
 - A. GENERAL CONTRACTOR TO COMPLETE WORK BEFORE LANDSCAPE CONTRACTOR TO COMMENCE. ALL PLANTING BED AREAS SHALL BE LEFT THREE INCHES BELOW FINAL GRADE OF SIDEWALKS, DRIVES AND CURBS. ALL AREAS TO RECEIVE SOLID SOD SHALL BE LEFT ONE INCH BELOW THE FINAL GRADE OF WALKS, DRIVES AND CURBS. CONSTRUCTION DEBRIS SHALL BE REMOVED PRIOR TO LANDSCAPE CONTRACTOR BEGINNING WORK.
 - B. ALL PACKAGED MATERIALS SHALL BE SEALED IN CONTAINERS SHOWING WEIGHT, ANALYSIS AND NAME OF MANUFACTURER. ALL MATERIALS SHALL BE PROTECTED FROM DETERIORATION IN TRANSIT AND WHILE STORED ON SITE.
 - C. DELIVER PLANT MATERIALS IMMEDIATELY PRIOR TO INSTALLATION. PLANT MATERIALS SHOULD BE INSTALLED ON THE SAME DAY AS DELIVERED. IF PLANTING CANNOT BE INSTALLED ON THE SAME DAY, PROVIDE ADDITIONAL PROTECTION TO MAINTAIN PLANTS IN A HEALTHY, VIGOROUS CONDITION.
 - D. STORE PLANT MATERIALS IN SHADE, PROTECT FROM FREEZING AND DRYING.
 - E. KEEP PLANT MATERIALS MOIST AND PROTECT FROM DAMAGE TO ROOT BALLS, TRUNKS AND BRANCHES.
 - F. PROTECT ROOT BALLS BY HEELING WITH SAWDUST OR OTHER MOISTURE RETAINING MATERIAL IF NOT PLANTED WITHIN 24 HOURS OF DELIVERY.
 - G. NOTIFY OWNER'S REPRESENTATIVE OF DELIVERY SCHEDULE 72 HOURS IN ADVANCE.
 - H. FOR BALLED AND BURLAPPED PLANTS - DIG AND PREPARE SHIPMENT IN A MANNER THAT WILL NOT DAMAGE ROOTS, BRANCHES, SHAPE, AND FUTURE DEVELOPMENT.
 - I. CONTAINER GROWN PLANTS - DELIVER PLANTS IN CONTAINER TO HOLD BALL SHAPE AND PROTECT ROOT MASS.
 - J. STORAGE OF ALL MATERIALS AND EQUIPMENT WILL BE AT THE RISK OF THE LANDSCAPE CONTRACTOR. OWNER WILL NOT BE HELD RESPONSIBLE FOR THEFT OR DAMAGE.
- 1.6 SEQUENCING
 - A. INSTALL TREES, SHRUBS, AND LINER STOCK PLANT MATERIALS PRIOR TO INSTALLATION OF LAWN/SOLID SOD.
- 1.7 WARRANTIES/GUARANTEE
 - A. FURNISH WRITTEN WARRANTY THAT PLANT MATERIALS WILL BE IN A HEALTHY, VIGOROUS GROWING CONDITION FOR ONE YEAR (TWELVE MONTHS) AFTER FINAL ACCEPTANCE. DAMAGE DUE TO ACTS OF GOD, VANDALISM, OR NEGLIGENCE BY OWNER IS EXCLUDED.
 - B. REPLACE DEAD, UNHEALTHY, AND UNSIGHTLY PLANT MATERIAL WITHIN WARRANTY PERIOD UPON NOTIFICATION BY OWNER OR OWNER'S REPRESENTATIVE. PLANTS USED FOR REPLACEMENT SHALL BE OF THE SAME SIZE AND KIND AS THOSE ORIGINALLY PLANTED OR SPECIFIED.
 - C. THE OWNER AGREES THAT FOR THE ONE YEAR WARRANTY PERIOD TO BE EFFECTIVE, HE WILL WATER PLANTS AT LEAST TWICE A WEEK DURING DRY PERIODS.
 - D. NOTIFY OWNER OR OWNER'S REPRESENTATIVE SEVEN DAYS PRIOR TO THE EXPIRATION OF THE WARRANTY PERIOD.
 - a. REMOVE DEAD, UNHEALTHY AND UNSIGHTLY PLANTS
 - b. REMOVE GUYING AND STAKING MATERIALS.
- 1.8 MAINTENANCE
 - A. MAINTAIN PLANT LIFE AND PLANTING BEDS IMMEDIATELY AFTER PLACEMENT AND FOR MINIMUM 30 DAYS AFTER FINAL ACCEPTANCE.
 - B. REPLACE DEAD OR DYING PLANTS WITH PLANTS OF SAME SIZE AND SPECIES AS SPECIFIED.
 - C. REMOVE TRASH, DEBRIS, AND LITTER, WATER, PRUNE, FERTILIZE, WEED AND APPLY HERBICIDES AND FUNGICIDES AS REQUIRED.
 - D. REMOVE CLIPPINGS AND DEBRIS FROM SITE PROMPTLY.

- E. COORDINATE WITH OPERATION OF IRRIGATION SYSTEM TO ENSURE THAT PLANTS ARE ADEQUATELY WATERED. HAND WATER AREAS NOT RECEIVING ADEQUATE WATER FROM AN IRRIGATION SYSTEM.
 - F. RESET SETTLED PLANTS
 - G. REAPPLY MULCH TO BARE AND THIN AREAS.
- 1.9 QUALITY ASSURANCE
- A. COMPLY WITH ALL FEDERAL, STATE, COUNTY AND LOCAL REGULATIONS GOVERNING LANDSCAPE MATERIALS AND WORK.
 - B. EMPLOY PERSONNEL EXPERIENCED AND FAMILIAR WITH THE REQUIRED WORK AND SUPERVISION BY A FOREMAN.
 - C. DO NOT MAKE PLANT MATERIAL SUBSTITUTIONS. IF THE LANDSCAPE MATERIAL SPECIFIED IS NOT READILY AVAILABLE, SUBMIT PROOF TO LANDSCAPE ARCHITECT ALONG WITH THE PROPOSED MATERIAL TO BE USED IN LIEU OF THE SPECIFIED PLANT.
 - D. ALL TREES SHALL BE MEASURED BY DIAMETER BREAST HEIGHT (DBH). DO NOT TRIM OR PRUNE TREES AND SHRUBS TO MEET THE REQUIREMENTS. OWNER'S REPRESENTATIVE SHALL INSPECT ALL PLANT MATERIAL AND RETAINS THE RIGHT TO INSPECT MATERIALS UPON ARRIVAL TO THE SITE AND DURING INSTALLATION. THE OWNER'S REPRESENTATIVE MAY ALSO REJECT ANY MATERIALS HE FEELS TO BE UNSATISFACTORY OR DEFECTIVE DURING THE WORK PROCESS. ALL PLANTS DAMAGED IN TRANSIT OR AT THE JOB SITE SHALL BE REJECTED.

PART 2 - PRODUCTS

2.1 PLANT MATERIALS

- A. ALL PLANTS SHALL BE CERTIFIED IN ACCORDANCE WITH THE AMERICAN STANDARD FOR NURSERY STOCK.
- B. PLANTS SHALL CONFORM TO THE MEASUREMENTS SPECIFIED, EXCEPT THE PLANTS LARGER THAN THOSE SPECIFIED MAY BE USED. USE OF LARGER PLANTS SHALL NOT INCREASE THE CONTRACT PRICE.
- C. WHERE MATERIALS ARE PLANTED IN MASSES, PROVIDE PLANTS OF UNIFORM SIZE.
- D. PLANTS SHALL BE GROWN IN CLIMATIC CONDITIONS SIMILAR TO THOSE AT THE INSTALLATION LOCATION.
- E. SHALL BE FREE OF DISEASE, INSECT INFESTATION, DEFECTS INCLUDING WEAK OR BROKEN LIMBS, CROTCHES, AND DAMAGED TRUNKS, ROOTS OR LEAVES WITH DAMAGED OR CROOKED LEADERS, BARK ABRASIONS, OBJECTIONABLE DISFIGUREMENT, INSECT EGGS AND LARVAE.
- F. ALL PLANTS SHALL EXHIBIT NORMAL GROWTH HABITS, VIGOROUS, HEALTHY, FULL, WELL BRANCHED, WELL ROOTED, PROPORTIONATE AND SYMMETRICAL.
- G. TREE TRUNKS TO BE STURDY, EXHIBIT HARDENED SYSTEMS AND VIGOROUS AND FIBROUS ROOT SYSTEMS, NOT ROOT OR POT BOUND.
- H. TREES WITH DAMAGED OR CROOKED LEADERS, BARK ABRASIONS, SUNSCALD, DISFIGURING KNOTS, OR INSECT DAMAGE WILL BE REJECTED.
- I. PLANT SCHEDULE ON DRAWING IS FOR CONTRACTORS INFORMATION ONLY AND NO GUARANTEE IS EXPRESSED OR IMPLIED THAT QUANTITIES THEREIN ARE CORRECT. THE CONTRACTOR SHALL ENSURE THAT ALL PLANT MATERIALS SHOWN ON THE DRAWINGS ARE INCLUDED IN HIS OR HER BID.

2.2 ACCESSORIES/MISCELLANEOUS MATERIALS

- A. MULCH - DOUBLE SHREDDED HARDWOOD MULCH, PARTIALLY DECOMPOSED BY LIVING EARTH TECHNOLOGIES OR APPROVED SUBSTITUTE. MULCH SHOULD BE FREE OF STICKS, STONES, CLAY, GROWTH AND GERMINATION INHIBITING INGREDIENTS.
- B. FERTILIZER - COMMERCIAL FERTILIZER CONTAINING 10-20-10 OR SIMILAR ANALYSIS.
- C. SOIL PREPARATION - SHALL BE FERTILE, LOAMY SOIL, ORGANIC MATTER SHALL ENCOMPASS BETWEEN 3% AND 10% OF THE TOTAL DRY WEIGHT. SOIL SHALL BE FREE FROM SUBSOIL, REFUSE, ROOTS, HEAVY OR STIFF CLAY, STONES LARGER THAN 1", NOXIOUS WEEDS, STICKS, BRUSH, LITTER AND OTHER SUBSTANCES. IT SHOULD BE SUITABLE FOR THE GERMINATION OF SEEDS AND THE SUPPORT OF VEGETATIVE GROWTH. THE PH VALUE SHOULD BE BETWEEN 4 AND 7.

APPROXIMATE PARTICLE DISTRIBUTION FOR TOPSOIL

CLAY	BETWEEN 15% AND 25%
SILT	BETWEEN 15% AND 25%
SAND	LESS THAN 50%
GRAVEL	LESS THAN 10%

- D. EXISTING TOPSOIL - MAY BE USED IF IT MEETS THE REQUIREMENTS FOR THE IMPORTED TOPSOIL OR IF APPROVED BY THE LANDSCAPE ARCHITECT OR OWNER'S REPRESENTATIVE. TOPSOIL SHALL NOT BE STRIPPED, TRANSPORTED OR GRADED IF MOISTURE CONTENT EXCEEDS FIELD CAPACITY. TOPSOIL STOCKPILES SHALL BE PROTECTED FROM EROSION OR CONTAMINATION.
- E. STEEL EDGING - SHALL BE 3/16" X 4" X 18" DARK GREEN LANDSCAPE EDGING.
- F. TREE STAKING - REFER TO DETAILS.
- G. FILTER FABRIC - MIRAFI 1405 BY MIRAFI INC. OR APPROVED SUBSTITUTE.
- H. SAND - UNIFORMLY GRADED, WASHED, CLEAN, BANK RUN SAND.
- I. DECOMPOSED GRANITE - BASE MATERIAL OF NATURAL MATERIAL MIX OF GRANITE AGGREGATE NOT TO EXCEED 1/8" IN DIAMETER.
- J. RIVER ROCK - LOCALLY AVAILABLE RIVER ROCK BETWEEN 2"-4" IN DIAMETER.

PART 3 - EXECUTION

3.1 PREPARATION

- A. IF WEEDS ARE GROWING IN PLANTING AREAS, APPLY HERBICIDE RECOMMENDED BY MANUFACTURER AND APPLIED BY AN APPROVED LICENSED APPLICATOR. ALLOW WEEDS TO DIE, AND THEN GRUB OUT ROOTS TO A MINIMUM OF 1/2 INCH DEPTH.

- B. PREPARE NEW PLANTING BEDS BY TILLING EXISTING SOIL TO A DEPTH OF SIX INCHES PRIOR TO PLACING COMPOST AND FERTILIZER, ADD SIX INCHES OF COMPOST AND TILL INTO A DEPTH OF SIX INCHES OF THE TOPSOIL.
- C. POSITION TREES AND SHRUBS AS DESIGNED ON PLAN. OBTAIN OWNERS REPRESENTATIVE'S APPROVAL PRIOR TO PROCEEDING.
- D. ALL PLANTING AREAS SHALL RECEIVE A MINIMUM OF 2 INCH LAYER OF MULCH.

3.2 EXCAVATING

- A. EXCAVATE PITS FOR PLANTING. TREE PITS SHALL BE LARGE ENOUGH TO PERMIT THE HANDLING OF THE ROOT BALL WITHOUT DAMAGE TO THE ROOTS. TREES SHALL BE PLANTED AT A DEPTH THAT WHEN SETTLED, THE CROWN OF THE PLANT SHALL BEAR THE SAME RELATIONSHIP TO THE FINISH GRADE AS IT DID TO THE SOIL SURFACE IN ORIGINAL PLACE OF GROWTH.
- B. TREE PITS PERCOLATION TEST: FILL PIT WITH WATER AND ALLOW TO STAND FOR 24 HOURS. IF PIT DOES NOT DRAIN, THE TREE NEEDS TO BE MOVED TO ANOTHER LOCATION OR HAVE DRAINAGE ADDED.
- C. SHRUB AND TREE PITS SHALL BE NO LESS THAN 24" WIDER THAN THE ROOT BALL AND 6" DEEPER THAN ITS VERTICAL DIMENSION. HOLES SHOULD BE ROUGH, NOT SMOOTH OR GLAZED.

3.3 PLANTING

- A. REMOVE CONTAINERS WITHOUT DAMAGE TO ROOTS.
- B. REMOVE BOTTOM OF PLANT BOXES PRIOR TO PLACING PLANTS. REMOVE SIDES AFTER PLACEMENT AND PARTIAL BACKFILLING.
- C. REMOVE UPPER THIRD OF BURLAP FROM BALLED AND BURLAPPED TREES AFTER PLACEMENT.
- D. PLACE PLANT UPRIGHT AND PLUMB IN CENTER OF HOLE. ORIENT PLANTS FOR BEST APPEARANCE.
- E. SET PLANTS WITH TOP OF ROOT BALLS FLUSH WITH ADJACENT GRADE AFTER COMPACTION. ADJUST PLANT HEIGHT IF SETTLEMENT OCCURS AFTER BACKFILLING.
- F. BACKFILL HOLES IMMEDIATELY AFTER PLANT IS PLACED USING BACKFILL MIX. BACKFILL TO ONE HALF DEPTH. FILL HOLE WITH WATER AND LIGHTLY TAMM SOIL TO REMOVE VOIDS AND AIR POCKETS.
- G. TRIM PLANTS TO REMOVE DEAD AND INJURED BRANCHES ONLY. BRACE PLANTS OVER 65 GALLONS IN SIZE.
- H. MULCH TO THE TOP OF THE ROOT BALL. DO NOT PLANT GRASS ALL THE WAY TO TRUNK OF THE TREE. MULCH WITH AT LEAST 2" OF SPECIFIED MULCH.
- I. DO NOT WRAP TREES.
- J. DO NOT OVER PRUNE.
- E. BLOCKS OF SOD SHOULD BE LAID JOINT TO JOINT AFTER FERTILIZING THE GROUND FIRST. ROLL GRASS AREAS TO ACHIEVE A SMOOTH, EVEN SURFACE. THE JOINTS BETWEEN BLOCKS SHOULD BE FILLED WITH TOPSOIL AND THEN WATERED THOROUGHLY.

3.4 STEEL EDGING

- A. STEEL EDGING SHALL BE INSTALLED AND ALIGNED AS INDICATED ON PLANS. OWNER'S REPRESENTATIVE TO APPROVE THE STAKED OR PAINTED LOCATION OF STEEL EDGE PRIOR TO INSTALLATION.
- B. ALL STEEL EDGING SHALL BE FREE OF BENDS OR KINKS.
- C. TOP OF EDGING SHALL BE 1/2" MAXIMUM HEIGHT ABOVE FINAL FINISHED GRADE.
- D. STAKES ARE TO BE INSTALLED ON THE PLANTING BED SIDE OF THE EDGING, NOT THE GRASS SIDE.
- E. STEEL EDGING SHALL NOT BE INSTALLED ALONG SIDEWALKS OR CURBS.
- F. EDGING SHOULD BE CUT AT A 45 DEGREE ANGLE WHERE IT MEETS SIDEWALKS OR CURBS.

3.5 CLEANUP


- A. REMOVE CONTAINERS, TRASH, RUBBISH AND EXCESS SOILS FROM SITE AS WORK PROGRESSES.
- B. REPAIR RUTS, HOLES AND SCARES IN GROUND SURFACES.
- C. PREMISES SHALL BE KEPT NEAT AT ALL TIMES AND ORGANIZED.
- D. ALL PAVED AREAS SHOULD BE CLEANED AT THE END OF EACH WORK DAY.

3.6 ACCEPTANCE


- A. ENSURE THAT WORK IS COMPLETE AND PLANT MATERIALS ARE IN VIGOROUS AND HEALTHY GROWING CONDITION.

END OF SECTION

1 TREE PLANTING
N.T.S.

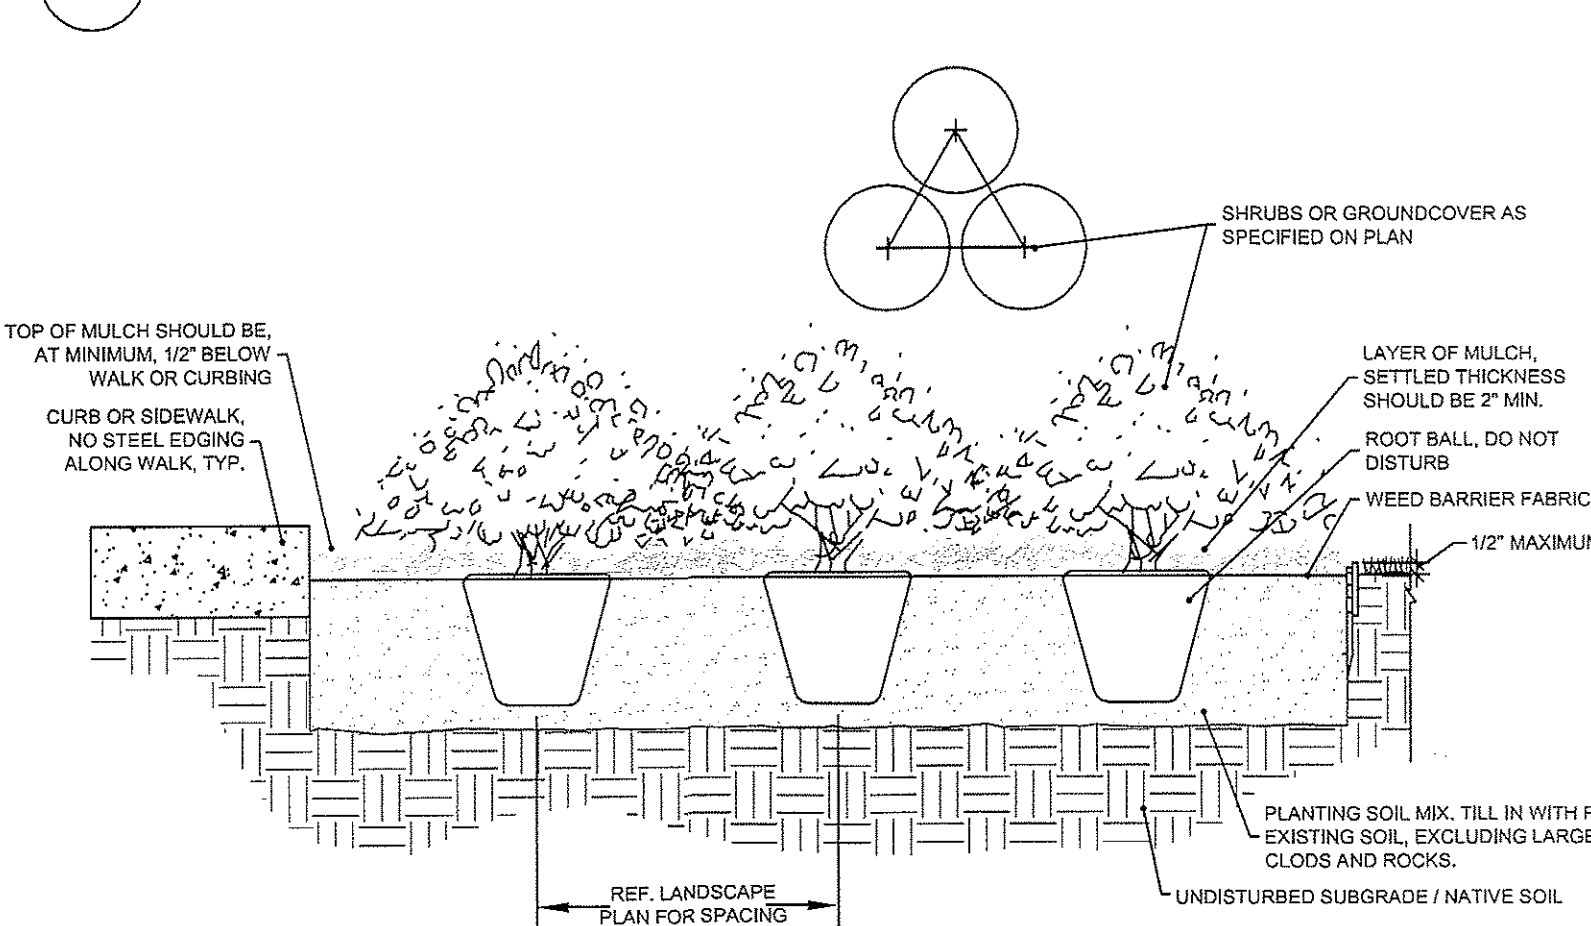

2 SHRUB PLANTING
N.T.S.


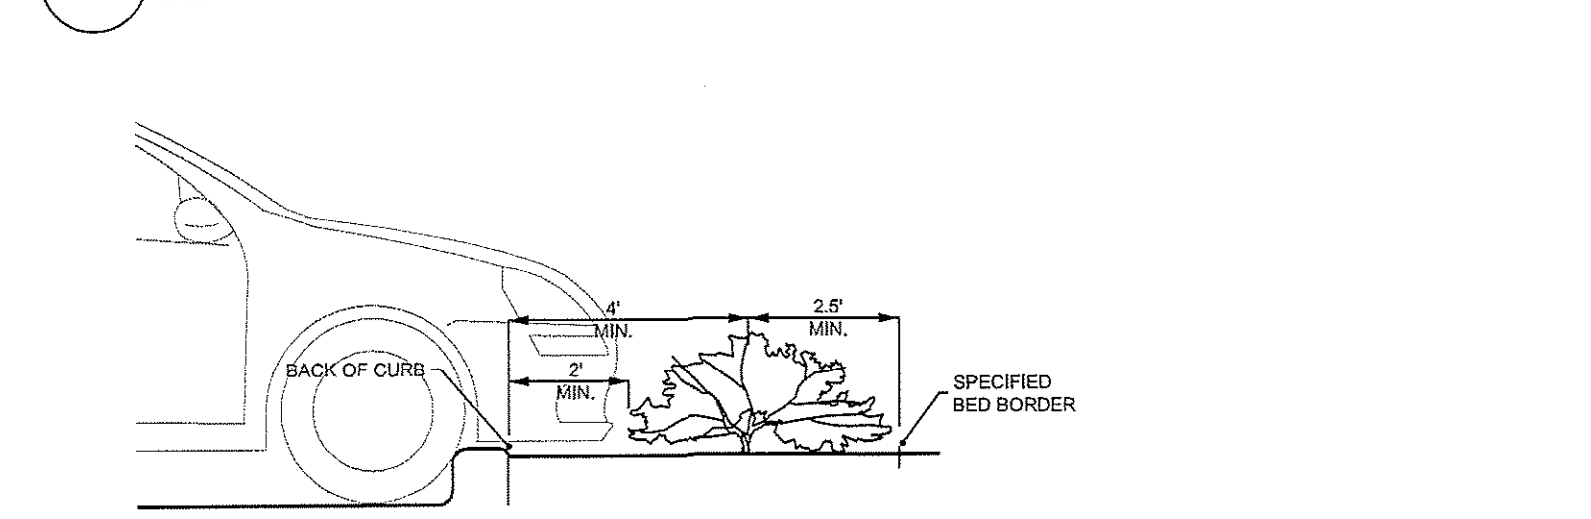


3 SHRUB SPACING AND PLANTING AT B.O.C.
N.T.S.


ENGINEER:
VASQUEZ ENGINEERING, L.L.C.
705 W. AVE B, SUITE 216
GARLAND, TEXAS 75040
PHONE: 972-272-4610
CONTACT: JUAN J. VASQUEZ, P.E.

OWNER/DEVELOPER:
CAVENDER'S
2025 WSW LOOP 323
TYLER, TEXAS 75701
PHONE: 903-509-9509
CONTACT: JAMES R. THOMPSON, CFO


LANDSCAPE SPECS & DETAILS
CAVENDER'S BOOT CITY
LOT 1, BLOCK 1
CAVENDER'S BOOT CITY ADDITION
3.27 ACRES
ROCKWALL, ROCKWALL COUNTY, TEXAS
AUGUST 15, 2014
CASE # SP2014-022

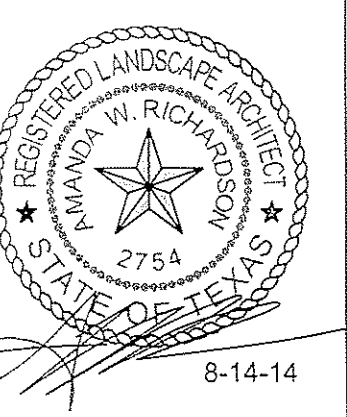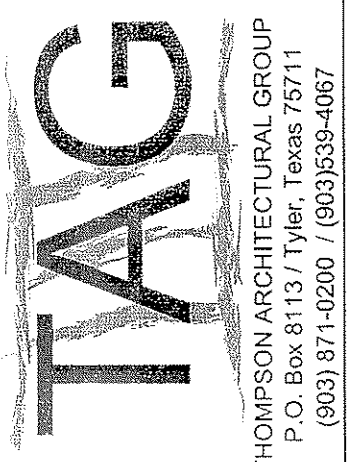

VASQUEZ ENGINEERING L.L.C.
1919 S. Shiloh Road
Suite 440, LB 44
Garland, Texas 75042
Ph: 972-278-2948
TX Registration # F-12266

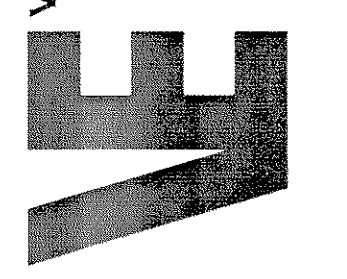

A New Facility for
Cavender's
Boot City
I.H. 30
Rockwall, Texas

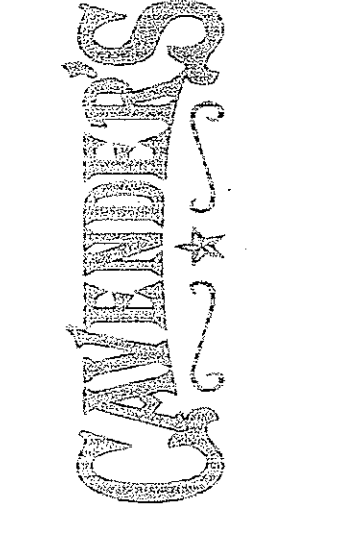

LANDSCAPE SPECIFICATIONS AND DETAILS

Revision/Revision Date

Project Number	560-11
Date	08/15/14
Drawn By	AWR
Checked By	AWR

LP2

SEGMENTAL RETAINING WALL CONSTRUCTION DRAWINGS CAVENDER'S BOOT CITY


ROCKWALL, TEXAS

RETAINING WALL PLANS
CAVENDER'S BOOT CITY
ROCKWALL, TEXAS

SHEET INDEX	
RW1	COVER SHEET
RW2	GENERAL NOTES
RW3	CROSS SECTION
RW4	DETAIL SHEET
RW5	DETAIL SHEET
RW6	DETAIL SHEET

COVER SHEET

RECORD DRAWINGS
TO THE BEST OF OUR KNOWLEDGE, CROSSPOINT ENGINEERING, LLC, HEREBY STATES THAT THIS PLAN IS RECORD DRAWINGS. THIS INFORMATION PROVIDED IS BASED ON SURVEYING OF THE SITE AND INFORMATION PROVIDED BY THE CONTRACTOR.

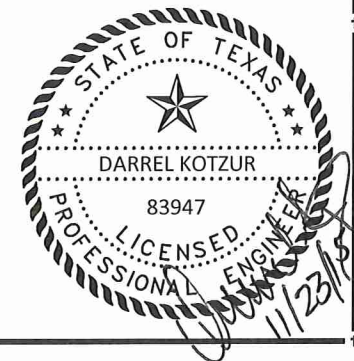

CAVENDER'S BOOT CITY RETAINING WALL
CP PROJECT NO. 14-1518-01

PROJECT:	ISSUED:	
14-1518-01	10/22/14	
DRAWN:	CHECKED:	SCALE:
TG	DK	
SHEET:		
RW1		

1.0 GENERAL REQUIREMENTS

- 1.1 CONSTRUCTION AND INSPECTION OF THE SEGMENTAL RETAINING WALL SHALL BE PERFORMED IN ACCORDANCE WITH THESE REQUIREMENTS.
- 1.2 RETAINING WALL CONTRACTOR SHALL BE CERTIFIED BY THE NATIONAL CONCRETE MASONRY ASSOCIATION AS A SEGMENTAL RETAINING WALL INSTALLER AT LEAST ONE CERTIFIED WORKER SHALL BE ONSITE DURING ANY RETAINING WALL CONSTRUCTION.
- 1.3 RETAINING WALL CONTRACTOR SHALL DEMONSTRATE SUCCESSFUL CONSTRUCTION OF AT LEAST FIVE SEGMENTAL RETAINING WALLS THAT ARE AT LEAST 12 FEET OR TALLER.
- 1.4 OWNER'S REPRESENTATIVE SHALL INSPECT CONSTRUCTION OF THE WALL FOR CONFORMANCE TO PLANS, SPECIFICATIONS AND THESE CONSTRUCTION REQUIREMENTS.
- 1.5 THE CONTRACTOR SHALL CLEAR AND GRUB THE REINFORCED BACKFILL ZONE AREA, REMOVING TOPSOIL, OR OTHER ORGANIC OR DELETERIOUS MATERIAL. ANY UNSUITABLE MATERIAL SHALL BE OVER EXCAVATED, REPLACED AND COMPACTED WITH BACKFILL MATERIAL TO PROJECT SPECIFICATIONS, OR AS OTHERWISE DIRECTED BY THE OWNER'S REPRESENTATIVE.
- 1.6 OWNER'S REPRESENTATIVE SHALL VERIFY THAT REINFORCED BACKFILL MATERIAL MEETS THE GRADATION AND OTHER REQUIREMENTS PRIOR TO PROCEEDING WITH CONSTRUCTION.
- 1.7 OWNER'S REPRESENTATIVE SHALL VERIFY THAT FOUNDATION SOIL MEETS THESE CONSTRUCTION REQUIREMENTS.
- 1.8 CONTRACTOR SHALL PLACE FILL, NOT EXCEEDING 8 INCHES FOR HEAVY COMPACTION EQUIPMENT AND NOT EXCEEDING 6 INCHES FOR LIGHTWEIGHT EQUIPMENT. WITHIN FOUR FEET OF THE BACK FACE OF THE WALL, ONLY HAND OPERATED COMPACTION EQUIPMENT MAY BE USED.
- 1.9 THE COMPACTED DENSITY AND MOISTURE CONTENT OF THE SOIL IN THE REINFORCED ZONE AREA SHALL BE TESTED AT LEAST ONCE PER EVERY 1000 SF PER 8" VERTICAL LIFT OR AT LEAST ONCE PER EVERY 2 FEET OF VERTICAL WALL ERECTION.
- 1.10 ALL VOIDS IN THE BLOCK UNITS SHALL BE FILLED WITH GRAVEL FILL, AND COMPACTED. CORE FILL AGGREGATE SHALL SATISFY ASTM D2487 FOR CLASSIFICATION AS GW OR GP.
- 1.11 DRAINAGE AGREGATE SHALL EXTEND A MINIMUM OF 12" BEHIND THE ENDS OF THE BLOCK UNITS. ANY OVER EXCAVATED AREAS SHALL BE FILLED WITH GRAVEL AND COMPACTED. DRAINAGE AGGREGATE SHALL SATISFY ASTM C33 FOR CLASSIFICATION FOR SIZE NO. 57 OR 67.
- 1.12 BLOCK CAP UNITS SHALL BE PERMANENTLY SECURED TO THE FULL BLOCK UNITS USING AN APPROVED CONSTRUCTION ADHESIVE, AS PER THE BLOCK MANUFACTURER'S RECOMMENDATIONS.
- 1.13 THE CONTRACTOR SHALL FOLLOW ALL OF THE MANUFACTURER'S INSTALLATION RECOMMENDATIONS.

2.0 MATERIAL

- 2.1 BACKFILL SOIL- BACKFILL MATERIAL SPECIFIED BELOW SHALL BE APPROVED BY OWNER'S REPRESENTATIVE AND SHALL MEET THE STRENGTH PARAMETERS AS PER SPECIFICATIONS AND CONSTRUCTION REQUIREMENTS.
- 2.2 REINFORCED BACKFILL AND RETAINED SOIL/FILL MATERIALS SHALL BE FREE OF EXCESS MOISTURE, ROOTS, MUCK, ORGANIC MATERIAL, OR OTHER DELETERIOUS MATERIALS. ALL ROCK PARTICLES AND HARD EARTH SHALL BE LESS THAN THREE INCHES IN THE LONGEST DIMENSION. REINFORCED BACKFILL MATERIALS THAT DO NOT MEET THESE CRITERIA SHALL BE CONSIDERED UNSUITABLE AND SHALL BE REMOVED.
- 2.3 REINFORCED FILL MATERIAL SHALL BE CLEAN FILL WITH MAXIMUM AGGREGATE SIZE LIMITED TO 1", WITH USCS CLASSIFICATION GW, GP, GC, SW, SP, SM, SC, WITH A PLASTICITY INDEX LESS THAN OR EQUAL TO 15 AND A LIQUID LIMIT LESS THAN OR EQUAL TO 40 PER ASTM D-4318.
- 2.4 FILL IN THE REINFORCED FILL ZONE SHALL BE COMPACTED AS SPECIFIED BY PROJECT SPECIFICATIONS OR TO A MINIMUM OF 95% OF THE MAXIMUM STANDARD PROCTOR DENSITY (AASHTO T-99). AT A MOISTURE CONTENT NO GREATER THAN 2 PERCENTAGE POINTS AND NO LESS THAN 1 PERCENTAGE POINT OF DRY OPTIMUM.
- 2.5 REINFORCED FILL MATERIAL SHALL HAVE THE FOLLOWING GRADATION TESTED IN ACCORDANCE WITH ASTM D-422:

SIEVE SIZE	PERCENT PASSING
1"	100-75
No. 4	100-20
NO. 40	0-60
NO. 200	0-35

- 2.6 DRAINAGE AGGREGATE SHALL BE A CLEAN CRUSHED STONE OR GRANULAR FILL (NO PEA GRAVEL) MEETING THE FOLLOWING GRADATION:

SIEVE SIZE	PERCENT PASSING
1"	100
3/4"	75-100
NO. 4	0-60
NO. 40	0-50
NO. 200	0-5

- 2.7 REINFORCED FILL AND DRAINAGE FILL SHALL HAVE PH BETWEEN 3 AND 9 PER ASTM G-51.
- 2.8 SEGMENTAL BLOCK UNITS SHALL BE:
KEYSTONE 'COMPAC II'
- 2.9 SEGMENTAL BLOCK UNITS SHALL MEET THE PUBLISHED MANUFACTURER'S SPECIFICATIONS AND THE MATERIAL SPECIFICATIONS AS SHOWN IN THE ASTM C1372 'STANDARD SPECIFICATION FOR DRY-CAST SEGMENTAL RETAINING WALL UNITS.
- 2.10 GEOGRID REINFORCEMENT SHALL BE:
MIRAFI 3XT - SYNTEN SF35 - STRATA 200
- 2.11 CONNECTORS AND ACCESSORIES SHALL BE AS RECOMMENDED AND SUPPLIED BY THE WALL MANUFACTURER.

3.0 DRAINAGE

- 3.1 AT THE END OF EACH WORKDAY, THE CONTRACTOR SHALL GRADE THE SURFACE OF THE LAST LIFT OF REINFORCED SOIL AWAY FROM THE WALL FACE AND COMPACT.
- 3.2 DURING SITE CONSTRUCTION, THE CONTRACTOR IS RESPONSIBLE FOR PROTECTION OF THE WALL AGAINST SURFACE WATER AT ALL TIMES BY THE USE OF BERMS, DIVERSION DITCHES, TEMPORARY DRAINS AND ALL OTHER MEANS THAT ARE REQUIRED.
- 3.3 WATER SHALL NOT BE PERMITTED TO POND IN THE REINFORCED SOIL ZONE.
- 3.4 ALL SLOPES ABOVE OR BELOW THE WALL SHALL BE VEGETATED AND PROTECTED FROM EROSION AS SOON AS POSSIBLE FOLLOWING CONSTRUCTION OF THE WALL.
- 3.5 THE SEGMENTAL RETAINING WALL HAS BEEN DESIGNED ON THE ASSUMPTION THAT THE REINFORCED BACKFILL MATERIAL SHALL BE FREE OF SUBSURFACE DRAINAGE OF WATER (SEEPAGE). PERMANENT SUBSURFACE WATER COLLECTION AND DIVERSION SHALL BE THE RESPONSIBILITY OF THE OWNER'S REPRESENTATIVE.

4.0 LEVELING PAD

- 4.1 LEVELING PAD SHALL COMPRISE OF COMPACTED CRUSHED STONE BASE OR UNREINFORCED CONCRETE.
- 4.2 THE LEVELING PAD SHALL BE AT LEAST 24 INCHES AND 6 INCHES THICK.
- 4.3 THE LEVELING PAD SHALL BE CONSTRUCTED AS TO PROVIDE A LEVEL, HARD SURFACE UPON WHICH TO PLACE THE FIRST COURSE OF SEGMENTAL RETAINING WALL UNITS.
- 4.4 IF GRAVEL IS USED TO CONSTRUCT THE LEVELING PAD, IT SHALL BE COMPACTED WITH A MINIMUM OF THREE PASSES OF A VIBRATORY SLED AND TO THE SATISFACTION OF THE OWNER'S REPRESENTATIVE.
- 4.5 THE LEVELING PAD SHALL BE PREPARED AS TO ENSURE COMPLETE CONTACT BETWEEN THE PAD AND THE FIRST COURSE OF THE SEGMENTAL RETAINING WALL UNITS.

4.0 DESIGN PARAMETERS

- 4.1 DESIGN OF THE SEGMENTAL RETAINING WALL IS BASED UPON THE FOLLOWING PARAMETERS:

	EFFECTIVE FRICTION ANGLE (DEG)	EFFECTIVE COHESION	MOIST UNIT WEIGHT
REINFORCED	28	0 PSF	120 PCF
RETAINED SOIL	28	0 PSF	120 PCF
FOUNDATION SOIL	28	0 PSF	120 PCF

- 4.2 FACTORS OF SAFETY (F.S.)

F.S. FOR SLIDING AT BASE = 1.5
 F.S. FOR OVERTURNING = 2.0
 F.S. FOR BEARING = 2.0
 F.S. FOR PULLOUT = 1.5
 F.S. FOR CONNECTION = 1.5

- 4.3 ANALYSIS OF GLOBAL STABILITY IS BEYOND THE SCOPE OF THIS DESIGN. IF GLOBAL STABILITY ANALYSIS IS DEEMED NECESSARY, OWNER SHOULD CONSULT GEOTECHNICAL ENGINEER.

- 4.3 ADDITIONAL LOADINGS:

BUILDING LOADS N/A
 SURCHARGE PER PROFILE
 SEISMIC LOADING N/A

- 4.4 HYDROSTATIC DESIGN IS NOT CONSIDERED IN WALL DESIGN. WATER SURFACE ASSUMED TO BE SUFFICIENTLY BELOW THE BOTTOM OF WALL AS NOT TO INFLUENCE INTERNAL AND EXTERNAL STABILITY.

5.0 GENERAL ASSUMPTIONS

- 5.1 ALL SEGMENTAL WALL LAYOUTS ARE BASED UPON INFORMATION PROVIDED BY THE OWNER'S REPRESENTATIVE. THE OWNER SHOULD VERIFY THAT THE LAYOUT AND GEOMETRIC INFORMATION SHOWN HEREIN IS ACCURATE. CROSSPOINT ENGINEERING ASSUMES NO LIABILITY FOR THE ACCURACY OF THE GEOMETRIC AND OR LAYOUT INFORMATION.
- 5.2 SEGMENTAL RETAINING WALLS ARE DESIGNED TO SUPPORT STATIC SOIL LOADING AS SHOWN IN PLANS. OWNER'S REPRESENTATIVE SHALL VERIFY THAT THE WALL STRUCTURE IS ISOLATED FROM ALL OTHER STRUCTURAL, VEHICLE AND OTHER LIVE AND DEAD LOADS AND SURCHARGES.
- 5.3 WALL ELEVATIONS AND LOCATIONS, AND GEOMETRY OF EXISTING STRUCTURES MUST BE VERIFIED BY THE OWNER OR OWNER'S REPRESENTATIVE PRIOR TO CONSTRUCTION.
- 5.4 CROSSPOINT ENGINEERING ASSUMES NO LIABILITY FOR INTERPRETATION OR VERIFICATION OF SUBSURFACE CONDITIONS, FOR THE SUITABILITY OF SOIL DESIGN PARAMETER, OR FOR INTERPRETATION OF SUBSURFACE GROUNDWATER CONDITIONS.
- 5.4 OWNER'S REPRESENTATIVE IS RESPONSIBLE FOR REVIEWING AND VERIFYING THAT THE ACTUAL SITE CONDITIONS AND PARAMETERS ARE AS DESCRIBED HEREIN, PRIOR TO AND DURING CONSTRUCTION. OWNER'S REPRESENTATIVE SHALL BE ONSITE TO ASSURE CONSTRUCTION IS IN ACCORDANCE WITH THESE NOTES AND DRAWINGS AND THE CONTRACT PLANS AND SPECIFICATIONS.
- 5.5 PROCEEDING WITH CONSTRUCTION WITHOUT FIRST VERIFYING THE CONDITIONS AND PARAMETERS SHALL ABSOLVE CROSSPOINT ENGINEERING FROM ALL LIABILITY FOR THE DESIGN AND CONSTRUCTION OF THIS STRUCTURE AND THE CONTRACTOR SHALL INDEMNIFY AND HOLD HARMLESS CROSSPOINT ENGINEERING FROM ALL RESULTING CLAIMS, DAMAGES, LOSSES, AND EXPENSES.
- 5.6 IF ANY GROUNDWATER IS ENCOUNTERED DURING CONSTRUCTION, IMMEDIATELY CONTACT CROSSPOINT ENGINEERING AT 903-705-4416 AND THE OWNER'S REPRESENTATIVE.


- 5.7 THIS DESIGN IS ONLY VALID FOR THE PROPOSED SEGMENTAL RETAINING WALL DETAILED AT THIS LOCATION AS PER THESE PLANS. THESE PLANS ARE NOT TRANSFERABLE TO ANY OTHER PROJECT.

- 5.8 DIFFERENTIAL SETTLEMENT, TOTAL SETTLEMENT AND CONSOLIDATION OF SUBGRADE MATERIALS SHALL BE THE RESPONSIBILITY OF THE OWNER'S GEOTECHNICAL ENGINEER OR OWNER'S REPRESENTATIVE. CROSSPOINT ENGINEERING ACCEPTS NO LIABILITY FOR THE EVALUATION OF SETTLEMENTS.

- 5.9 EVALUATION AND MITIGATION OF POTENTIAL EROSION, SCOUR AND HYDRAULIC EFFECTS OF WATER FLOWING IN ANY PROJECT AREAS IS THE RESPONSIBILITY OF THE OWNER'S REPRESENTATIVE.

- 5.10 STRUCTURAL DESIGN HEREIN REPRESENTS A FINISHED STRUCTURE. THE CONTRACTOR SHALL PROVIDE ALL INTERIM BRACING, SHORING, INTERIM DRAINAGE PROVISIONS AND EROSION PROTECTION REQUIRED UNTIL FINAL CAPPING, PAVING, CURBING AND COMPLETION OF FINAL STORM DRAIN SYSTEM IS COMPLETE.

RECORD DRAWINGS
 TO THE BEST OF OUR KNOWLEDGE, CROSSPOINT ENGINEERING, LLC, HEREBY STATES THAT THIS PLAN IS RECORD DRAWINGS. THIS INFORMATION PROVIDED IS BASED ON SURVEYING OF THE SITE AND INFORMATION PROVIDED BY THE CONTRACTOR.

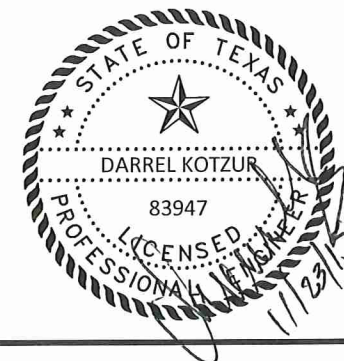

crosspoint
 engineering

5620 Old Bullard Road, Suite 130 | Tyler, Texas 75703
 903 705 4416 | TPBE Firm Reg. No. F-35385
 cp-eng.com


**RETAINING WALL PLANS
 CAVENDER'S BOOT CITY
 ROCKWALL, TEXAS**

GENERAL NOTES


PROJECT:	ISSUED:
14-1518-01	10/22/14
DRAWN:	CHECKED: SCALE:
TG	DK
SHEET:	
RW2	

**RETAINING WALL PLANS
CAVENDER'S BOOT CITY
ROCKWALL, TEXAS**


CROSS SECTIONS

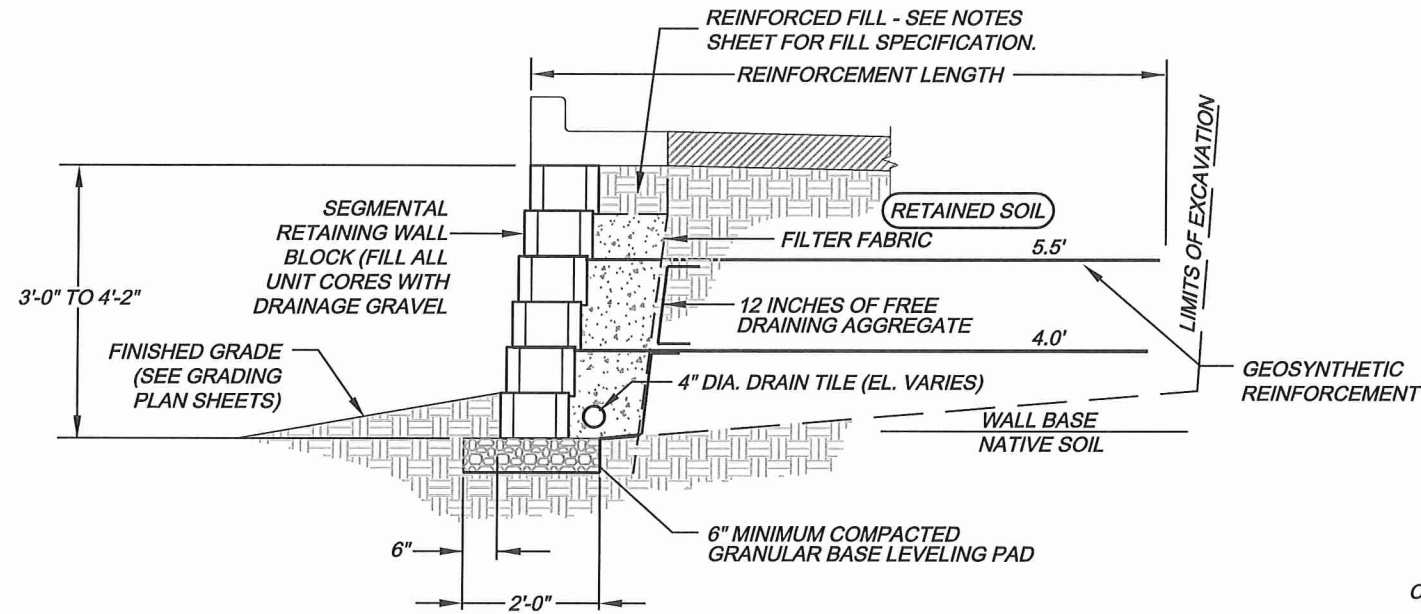

SECTION B-B
N.T.S.

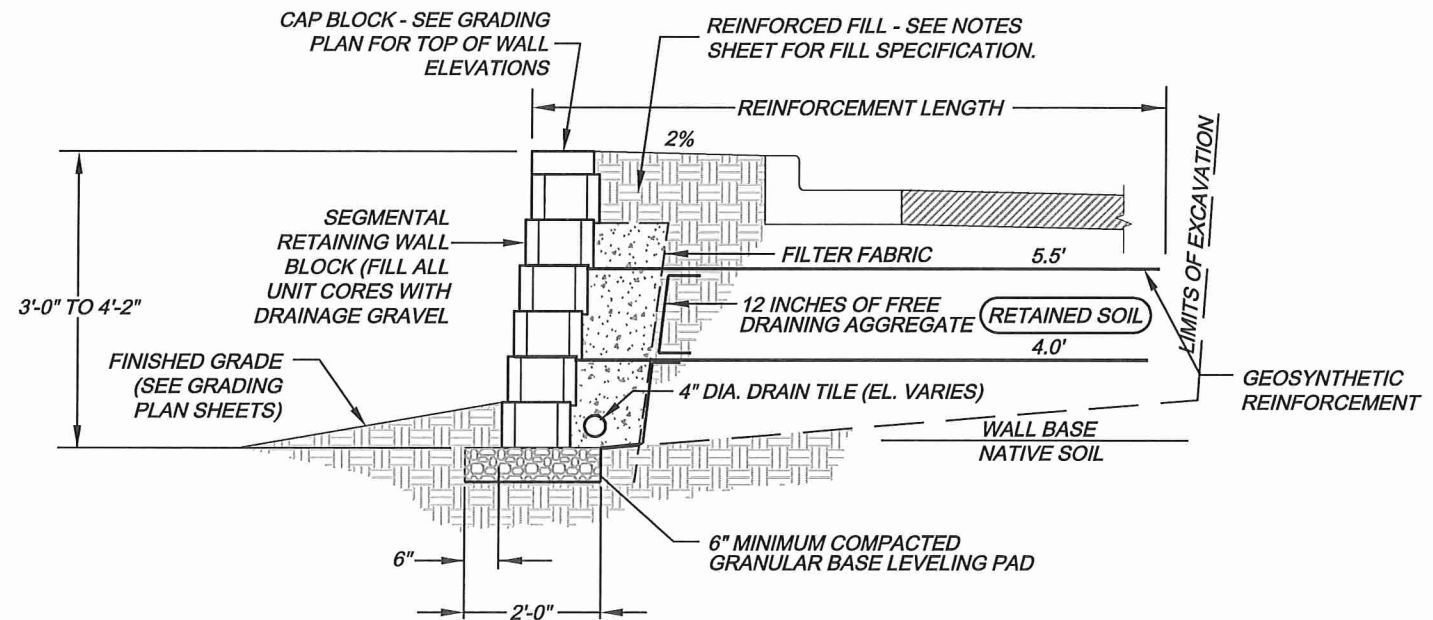

SECTION C-C
N.T.S.

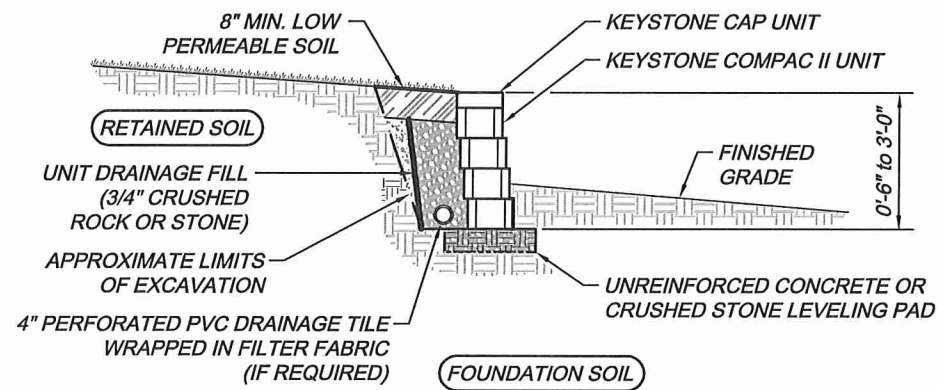

TYPICAL GRAVITY WALL SECTION
COMPAC II UNIT - 1" SETBACK

RECORD DRAWINGS
TO THE BEST OF OUR KNOWLEDGE, CROSSPOINT ENGINEERING, LLC, HEREBY STATES THAT THIS PLAN IS RECORD DRAWINGS. THIS INFORMATION PROVIDED IS BASED ON SURVEYING OF THE SITE AND INFORMATION PROVIDED BY THE CONTRACTOR.




PROJECT:	ISSUED:
14-1518-01	10/22/14
DRAWN:	CHECKED:
TG	DK
SHEET:	

RW3

PLACE ADDITIONAL PIECES OF GEOGRID WHEN ANGLE EXCEEDS 20°

3" OF SOIL FILL IS REQUIRED BETWEEN OVERLAPPING GEOGRID FOR PROPER ANCHORAGE (TYP.)

ADDITIONAL DRAINAGE FILL EXTEND WALL HEIGHT / 2

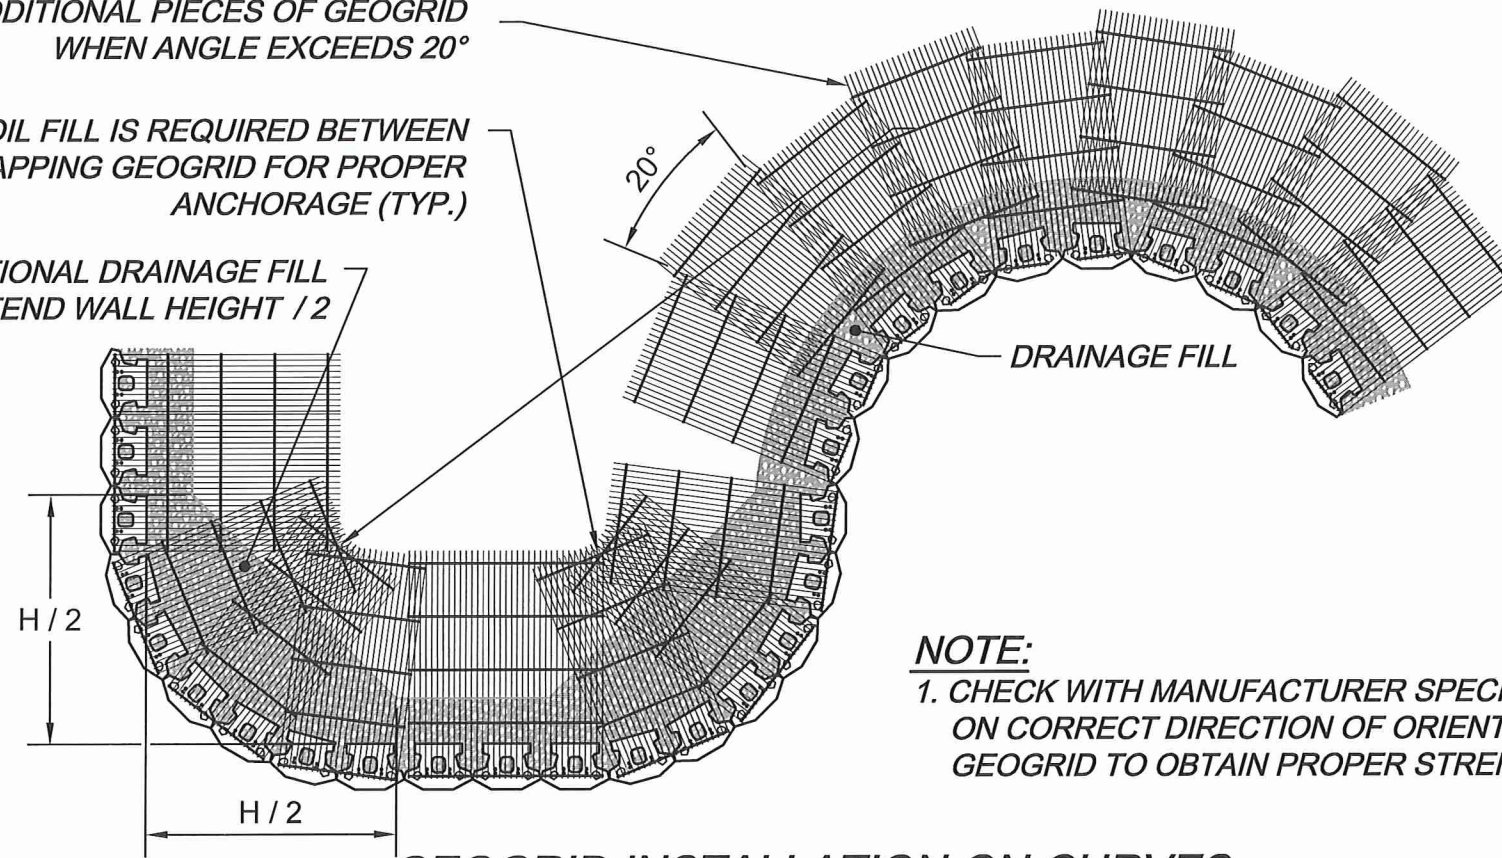


NOTE:

1. CHECK WITH MANUFACTURER SPECIFICATIONS ON CORRECT DIRECTION OF ORIENTATION FOR GEOGRID TO OBTAIN PROPER STRENGTH.

GEOGRID INSTALLATION ON CURVES

3" OF SOIL FILL IS REQUIRED BETWEEN OVERLAPPING GEOGRID FOR PROPER ANCHORAGE (TYP.)

ADDITIONAL DRAINAGE FILL EXTEND WALL HEIGHT / 2

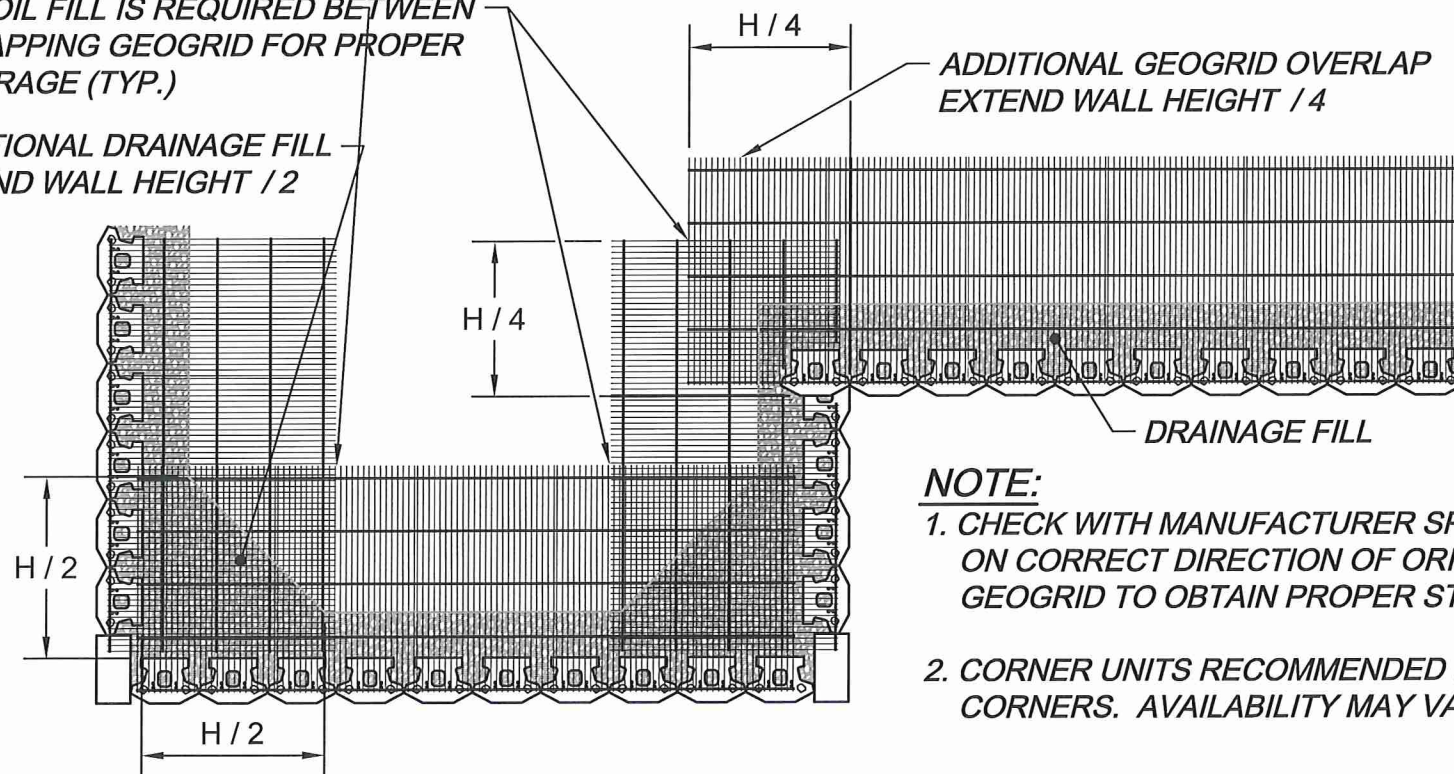


NOTE:


1. CHECK WITH MANUFACTURER SPECIFICATIONS ON CORRECT DIRECTION OF ORIENTATION FOR GEOGRID TO OBTAIN PROPER STRENGTH.
2. CORNER UNITS RECOMMENDED FOR OUTSIDE CORNERS. AVAILABILITY MAY VARY.

GEOGRID INSTALLATION AT CORNERS

RECORD DRAWINGS
TO THE BEST OF OUR KNOWLEDGE, CROSSPOINT ENGINEERING, LLC, HEREBY STATES THAT THIS PLAN IS RECORD DRAWINGS. THIS INFORMATION PROVIDED IS BASED ON SURVEYING OF THE SITE AND INFORMATION PROVIDED BY THE CONTRACTOR.

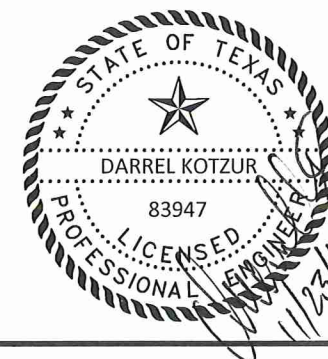


PROJECT:	ISSUED:
14-1518-01	10/22/14
DRAWN:	CHECKED: SCALE:
TG	DK
SHEET:	

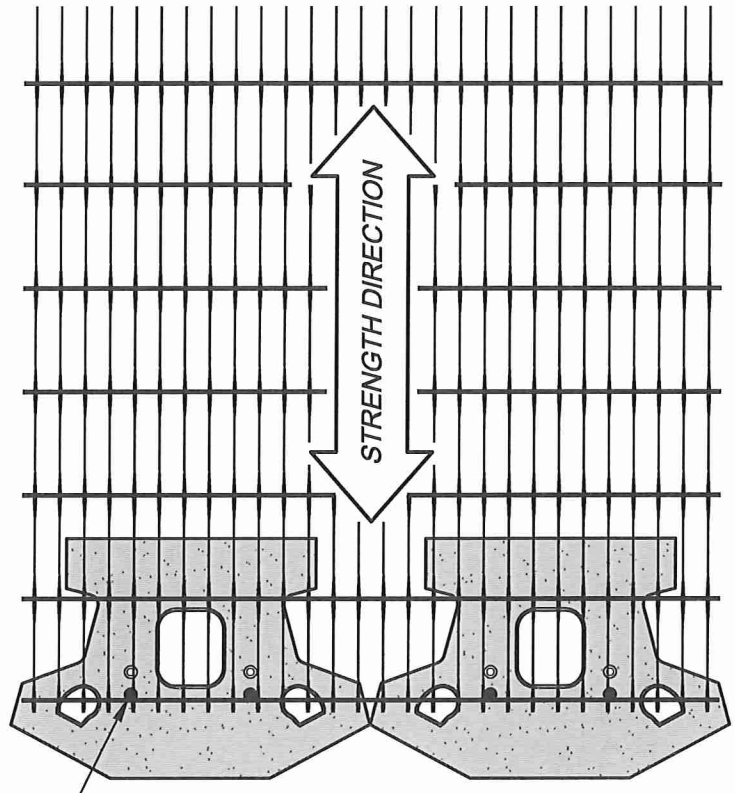


GEOGRID IS TO BE PLACED ON LEVEL BACKFILL AND EXTENDED OVER THE FIBERGLASS PINS. PLACE NEXT UNIT. PULL GRID TAUGHT AND BACKFILL. STAKE AS REQUIRED.

GRID & PIN CONNECTION

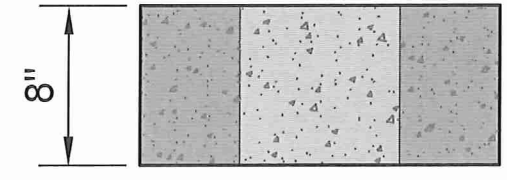


COMPAC ELEVATION

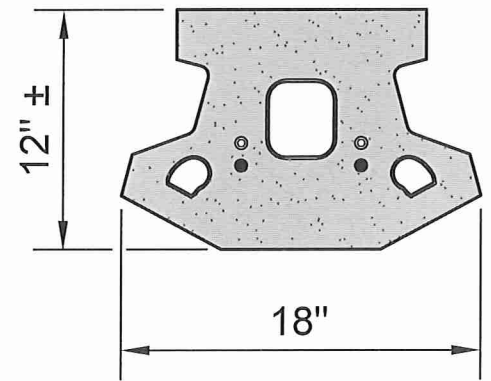


COMPAC PLAN

COMPAC UNIT
* DIMENSIONS MAY VARY BY REGION

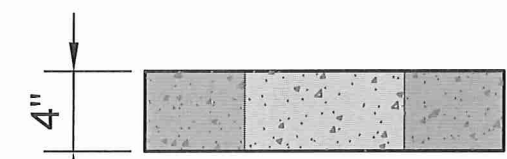

CAP UNIT ELEVATION

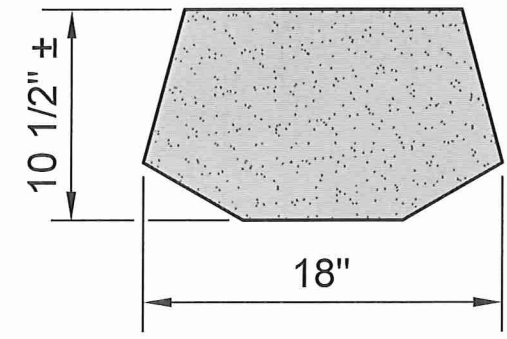

CAP UNIT PLAN

3-PLANE SPLIT CAP UNIT OPTION
* DIMENSIONS & AVAILABILITY WILL VARY BY REGION

RECORD DRAWINGS
TO THE BEST OF OUR KNOWLEDGE, CROSSPOINT ENGINEERING, LLC, HEREBY STATES THAT THIS PLAN IS RECORD DRAWINGS. THIS INFORMATION PROVIDED IS BASED ON SURVEYING OF THE SITE AND INFORMATION PROVIDED BY THE CONTRACTOR.



PROJECT:	ISSUED:	
14-1518-01	10/22/14	
DRAWN:	CHECKED:	SCALE:
TG	DK	
SHEET:		


RW5

RETAINING WALL PLANS
CAVENDER'S BOOT CITY
ROCKWALL, TEXAS

BASE LEVELING PAD NOTES:


1. THE LEVELING PAD IS TO BE CONSTRUCTED OF CRUSHED STONE OR 2,000 PSI ± UNREINFORCED CONCRETE
2. THE BASE FOUNDATION IS TO BE APPROVED BY THE SITE GEOTECHNICAL ENGINEER PRIOR TO PLACEMENT OF THE LEVELING PAD.

COMPAC UNIT		CAP UNIT	
WIDTH:	18"	WIDTH:	18"
*DEPTH:	12"	*DEPTH:	10 1/2"
HEIGHT:	8"	HEIGHT:	4"
*WEIGHT:	85 LBS	*WEIGHT:	45 LBS

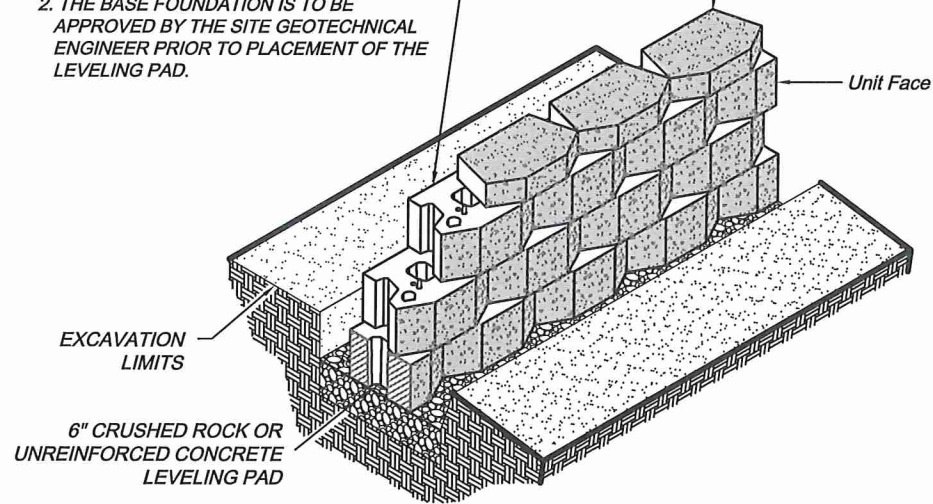

COMPAC UNIT/BASE PAD ISOMETRIC SECTION VIEW


* DIMENSIONS & WEIGHT MAY VARY BY REGION

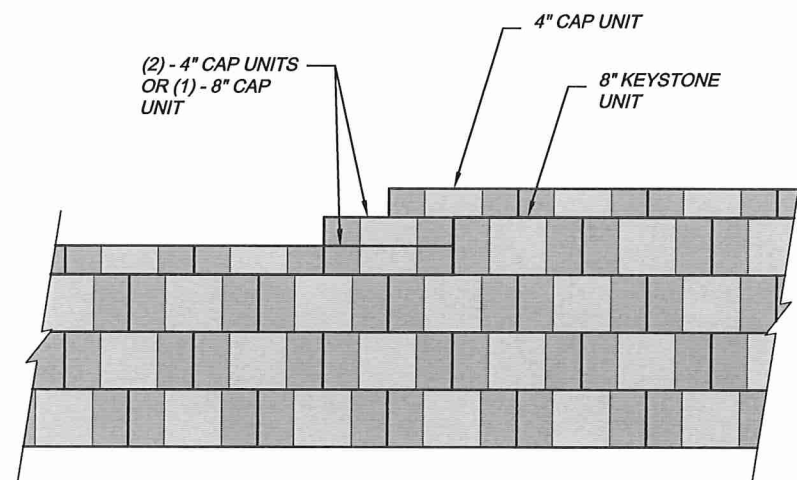

NOTE:

1. SECURE ALL CAP UNITS WITH KEYSTONE KAPSEAL OR EQUAL.


TOP OF WALL STEPS

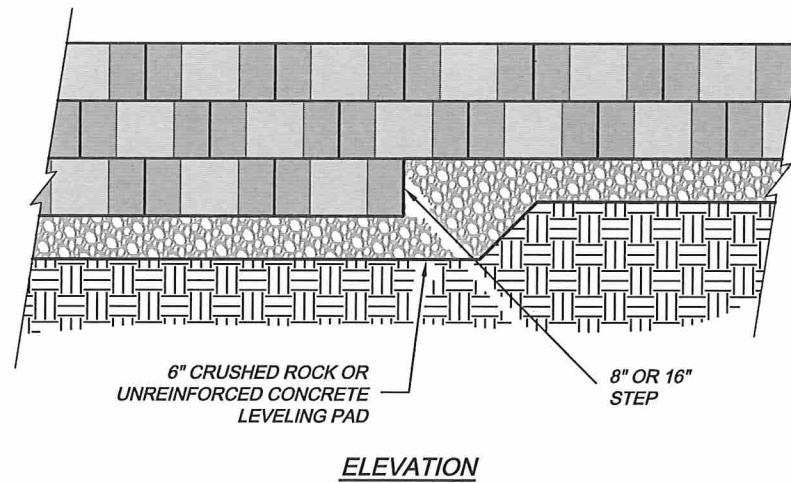

ELEVATION


NOTE:

1. THE LEVELING PAD IS TO BE CONSTRUCTED OF CRUSHED STONE OR 2000 PSI ± UNREINFORCED CONCRETE.

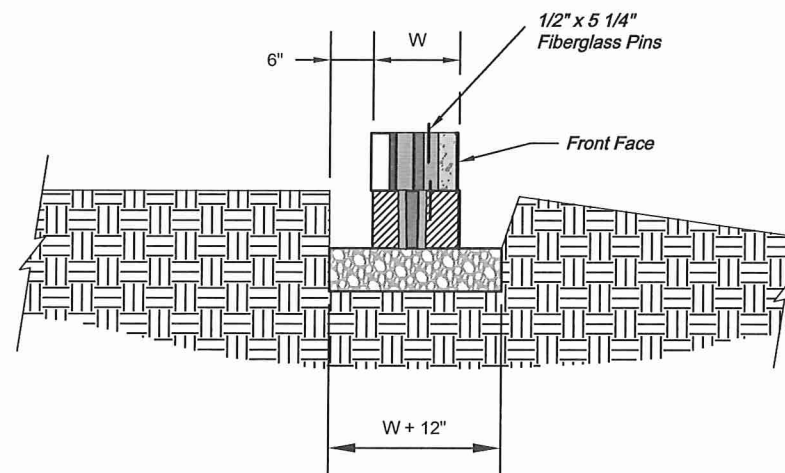

SECTION

LEVELING PAD DETAIL

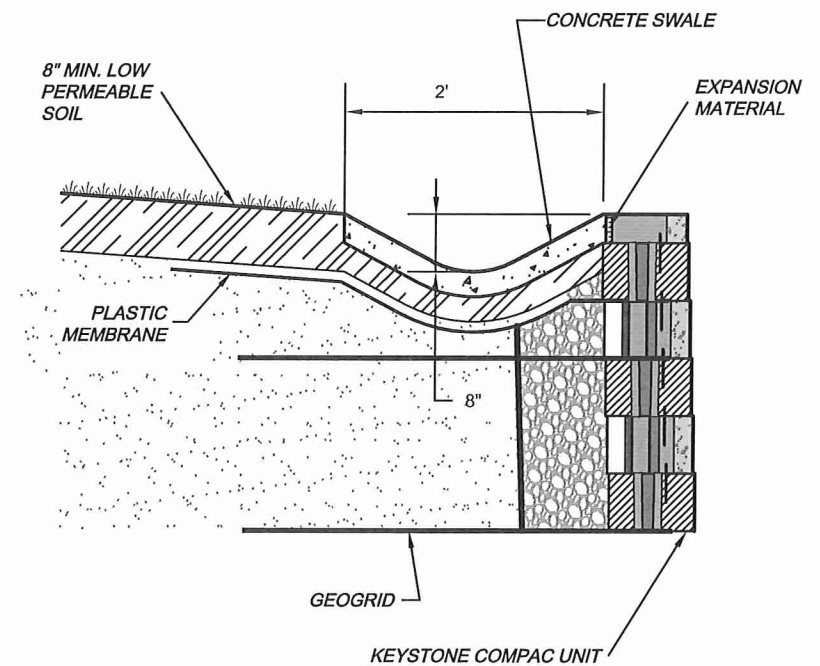

DRAINAGE SWALE DETAIL

RECORD DRAWINGS
TO THE BEST OF OUR KNOWLEDGE, CROSSPOINT ENGINEERING, LLC, HEREBY STATES THAT THIS PLAN IS RECORD DRAWINGS. THIS INFORMATION PROVIDED IS BASED ON SURVEYING OF THE SITE AND INFORMATION PROVIDED BY THE CONTRACTOR.



**RETAINING WALL PLANS
CAVENDER'S BOOT CITY
ROCKWALL, TEXAS**

DETAIL SHEET

PROJECT:	ISSUED:
14-1518-01	10/22/14
DRAWN:	CHECKED:
TG	DK
SCALE:	
SHEET:	

RW6