


CHAMPION ROAD-LIFT STATION 65-33-02
 RECORD DRAWINGS
 NOTE: THE INTENT OF THE OWNER AND ENGINEER WAS TO CONSTRUCT THE IMPROVEMENTS ACCORDING TO THESE PLANS AS APPROVED BY THE CITY OF ROCKWALL. THE LINES AND GRADES WERE SET ON THE GROUND FOR CONSTRUCTION ACCORDING TO SAID PLANS. WE ARE NOT AWARE OF ANY CHANGES OR REVISIONS TO THESE PLANS DURING CONSTRUCTION EXCEPT AS NOTED ON THE PLANS.

NOTE:
 BY REQUEST OF
 PULTE HOMES OF TEXAS, L.P.
 THE 6" FORCE MAIN WAS
 NOT CONSTRUCTED

**PLAN AND PROFILE
 WASTE WATER IMPROVEMENTS**
 CITY OF ROCKWALL
 ROCKWALL COUNTY, TEXAS

DOWDEY, ANDERSON & ASSOCIATES, INC.
 5225 VILLAGE CREEK DR., STE. 200 (972) 931-0694 PLANO, TEXAS

NO.	DATE	BY	REVISION
AB	5/23/02	GB	DELETED 6" FORCE MAIN

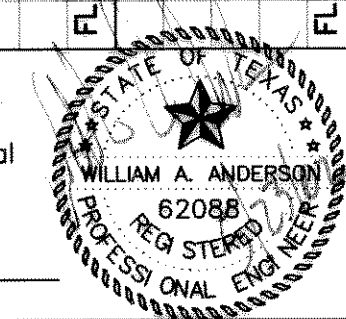

These construction plans were prepared under the responsible supervision of William A. Anderson, Registered Professional Engineer No. 62088.