
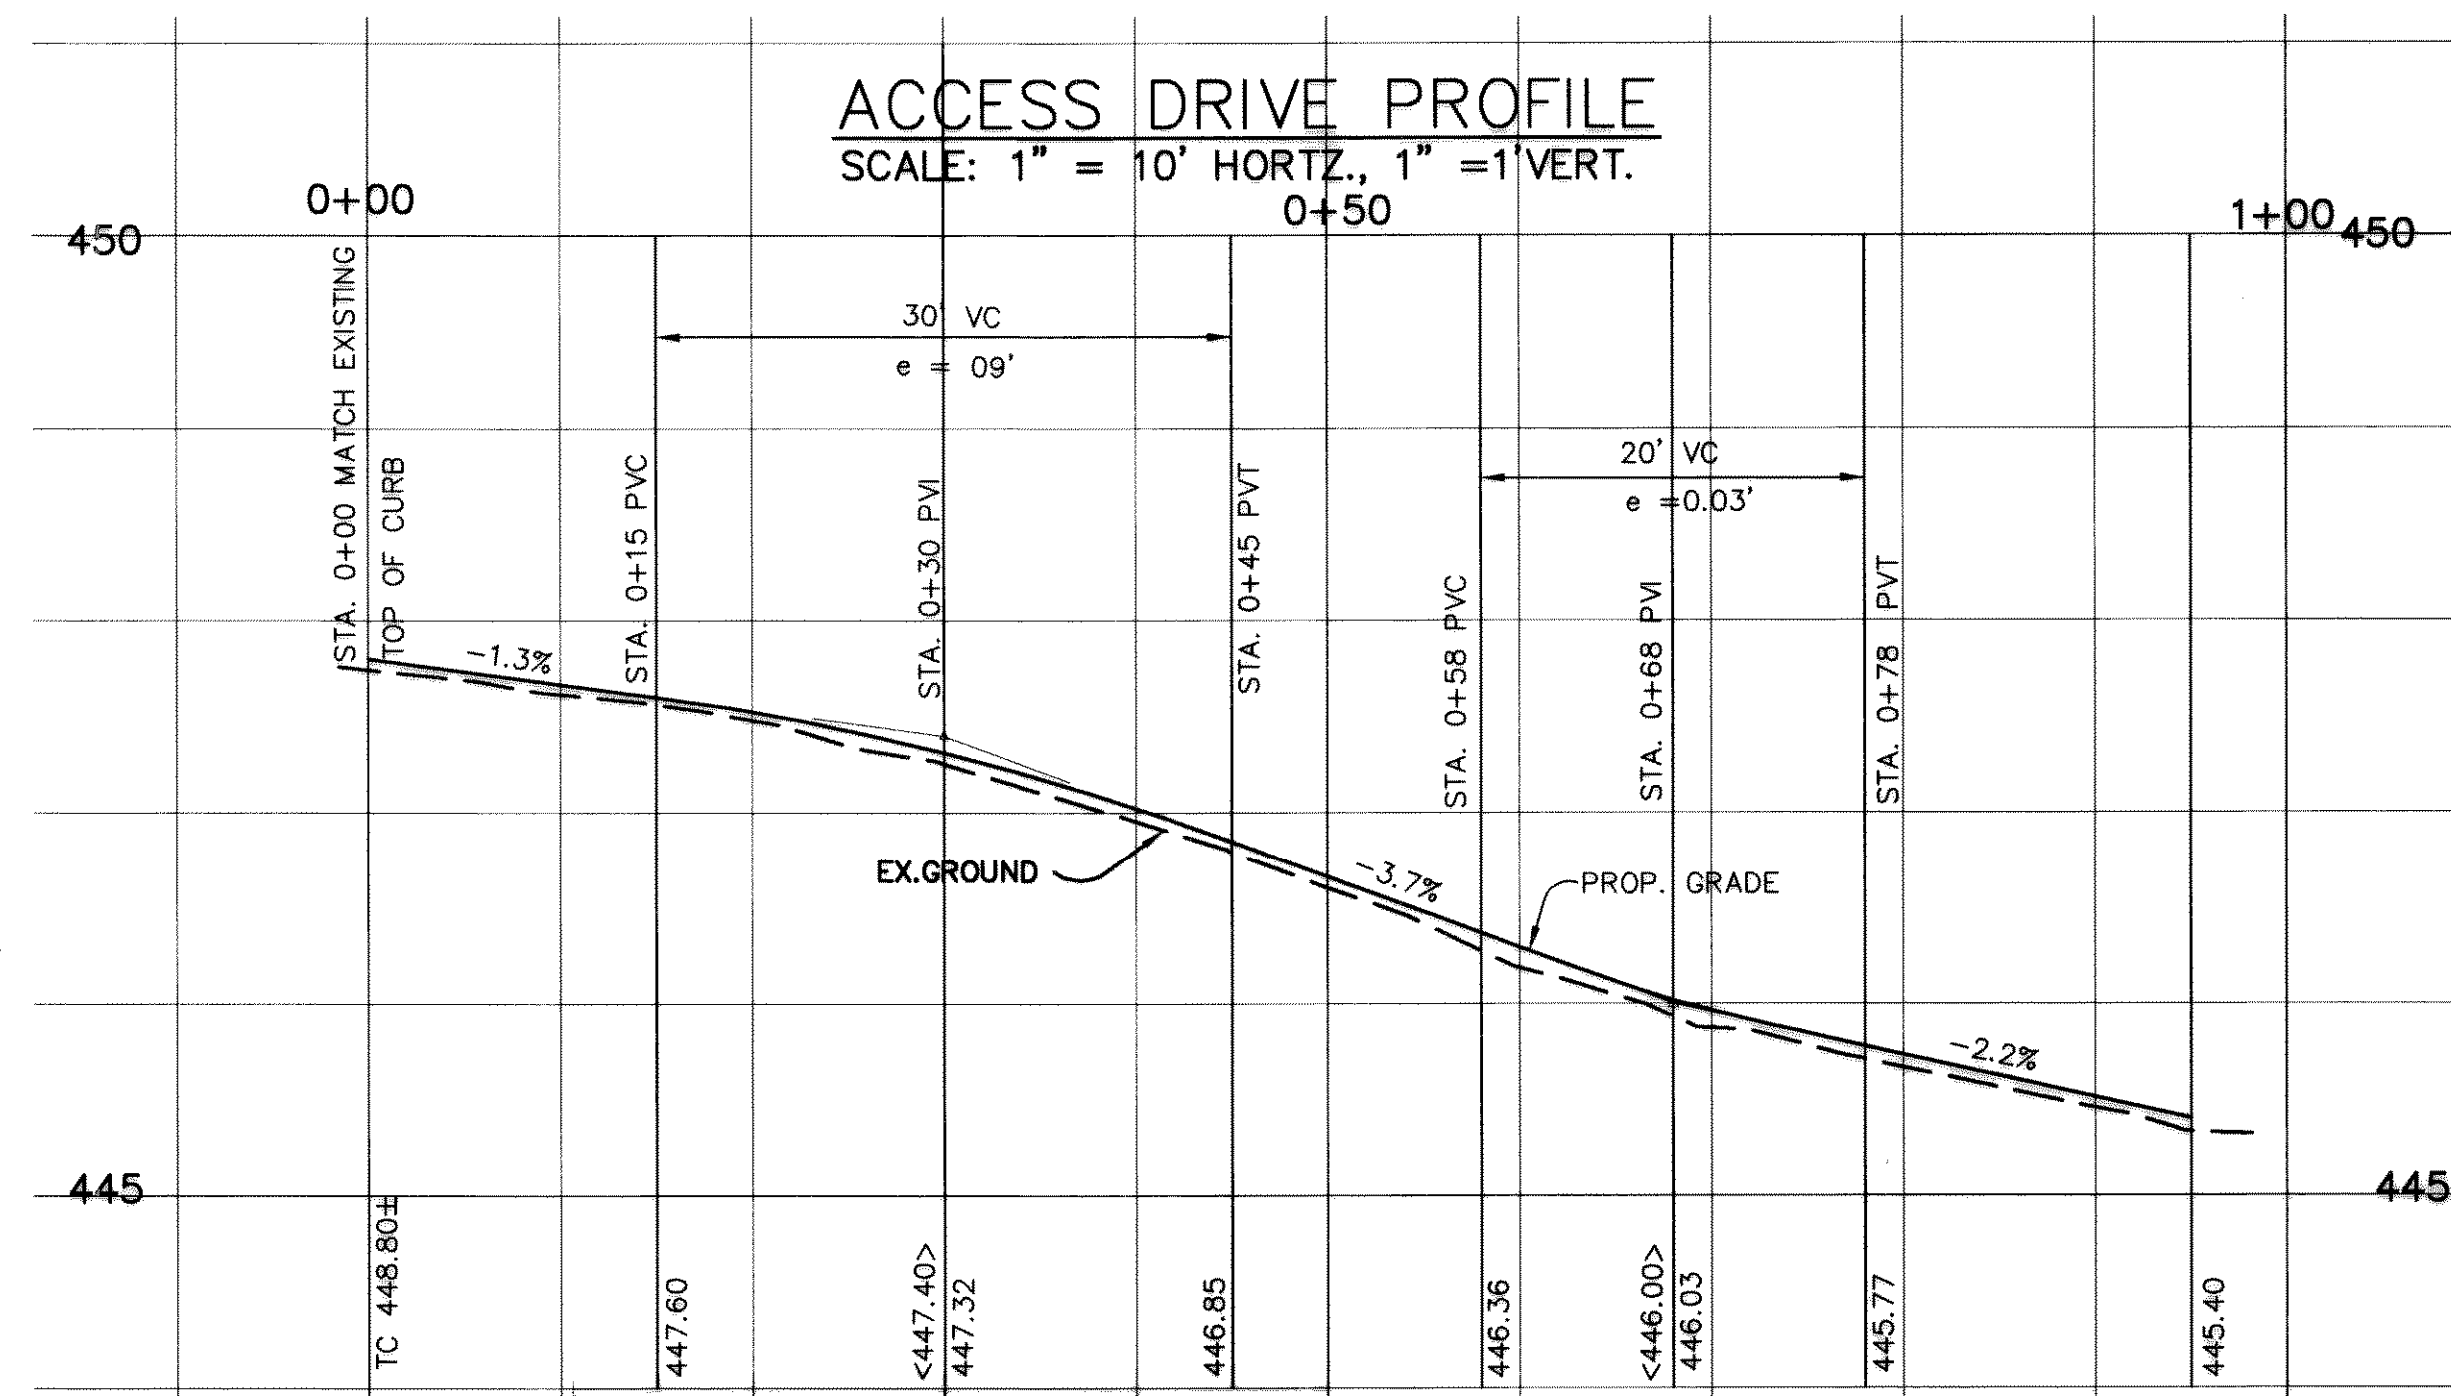


EXISTING 100 YR FLOOD ELEVATION = 446.97  
 FUTURE 100 YR FLOOD ELEVATION = 448.61

NOTE:  
 TYPE AND LOCATION OF  
 ACCESS ROAD GATE SHALL  
 BE COORDINATED WITH THE  
 CITY AND THE OWNER.

These construction plans were prepared  
 under the responsible supervision of  
 William A. Anderson, Registered Professional  
 Engineer No. 62088.

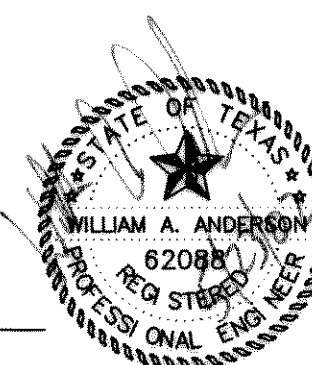

CHAMPION ROAD-LIFT STATION 05-23-02  
 RECORD DRAWINGS  
 NOTE: THE INTENT OF THE OWNER AND ENGINEER  
 WAS TO CONSTRUCT THE IMPROVEMENTS  
 ACCORDING TO THESE PLANS AS APPROVED BY THE  
 CITY OF ROCKWALL. THE LINES AND GRADES  
 WERE SET ON THE GROUND FOR CONSTRUCTION  
 ACCORDING TO SAID PLANS. WE ARE NOT AWARE  
 OF ANY CHANGES OR REVISION TO THESE PLANS  
 DURING CONSTRUCTION EXCEPT AS NOTED ON THE  
 PLANS.

| NO. | DATE    | BY | REVISION                         |
|-----|---------|----|----------------------------------|
| AB  | 5/23/02 | GB | REVISED GRADING AND SERVICE ROAD |
|     |         |    |                                  |
|     |         |    |                                  |

**GRADING / SITE PLAN**  
**WASTEWATER IMPROVEMENTS**

CITY OF ROCKWALL  
 ROCKWALL COUNTY, TEXAS

**DOWDEY, ANDERSON & ASSOCIATES, INC.**  
 5225 VILLAGE CREEK DR., STE. 200 (972) 931-0694 PLANO, TEXAS

| DESIGN | DRAWN | CHECKED | DATE     | SCALE  | JOB   | SHEET |
|--------|-------|---------|----------|--------|-------|-------|
| DJR    | BAB   | WAA     | MAY 2002 | 1"=10' | 99015 | 1 / 1 |