


REVISED 6-5-73
9-14-73

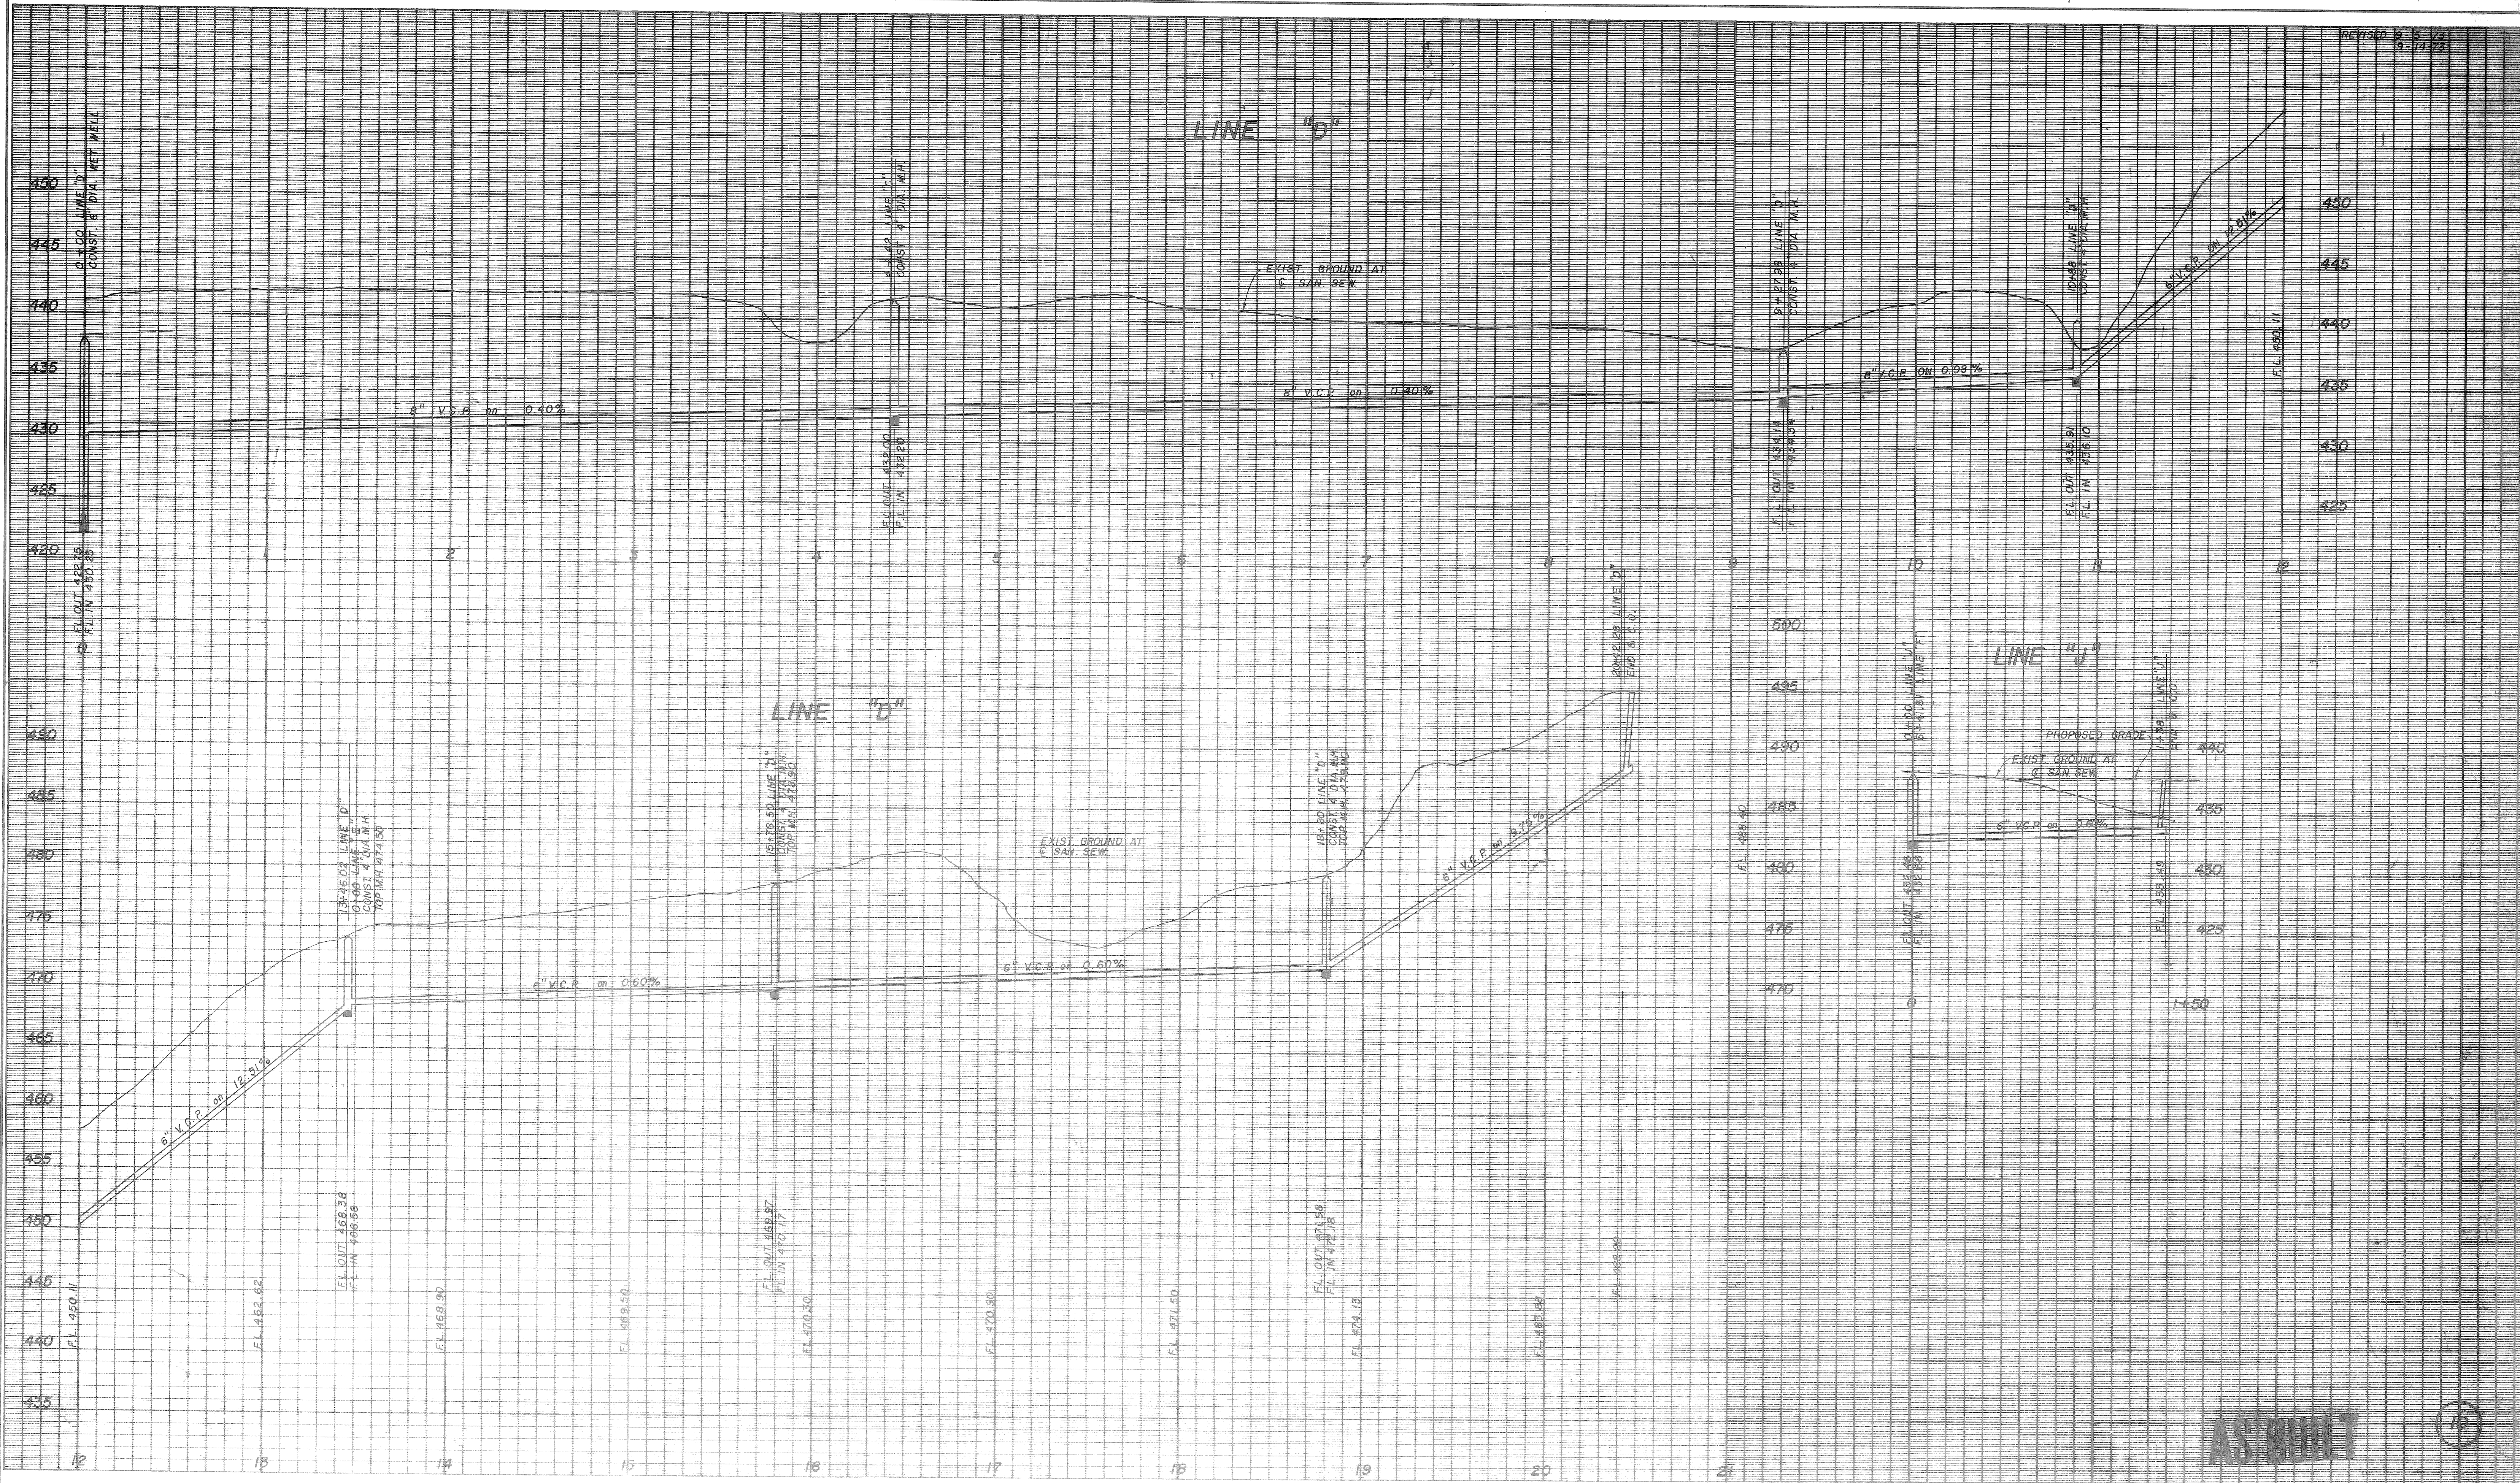

CHANDLERS LANDING						
PROPOSED SANITARY SEWER						
LINES "D" & "J"						
ROCKWALL, TEXAS						
DESIGN	DRAWN	DATE	SCALE	NOTES	FILE	NO.
H L E		6/11/73	1" = 40' H 1" = 6' V			72122

PHASE
1, 2, & 3