


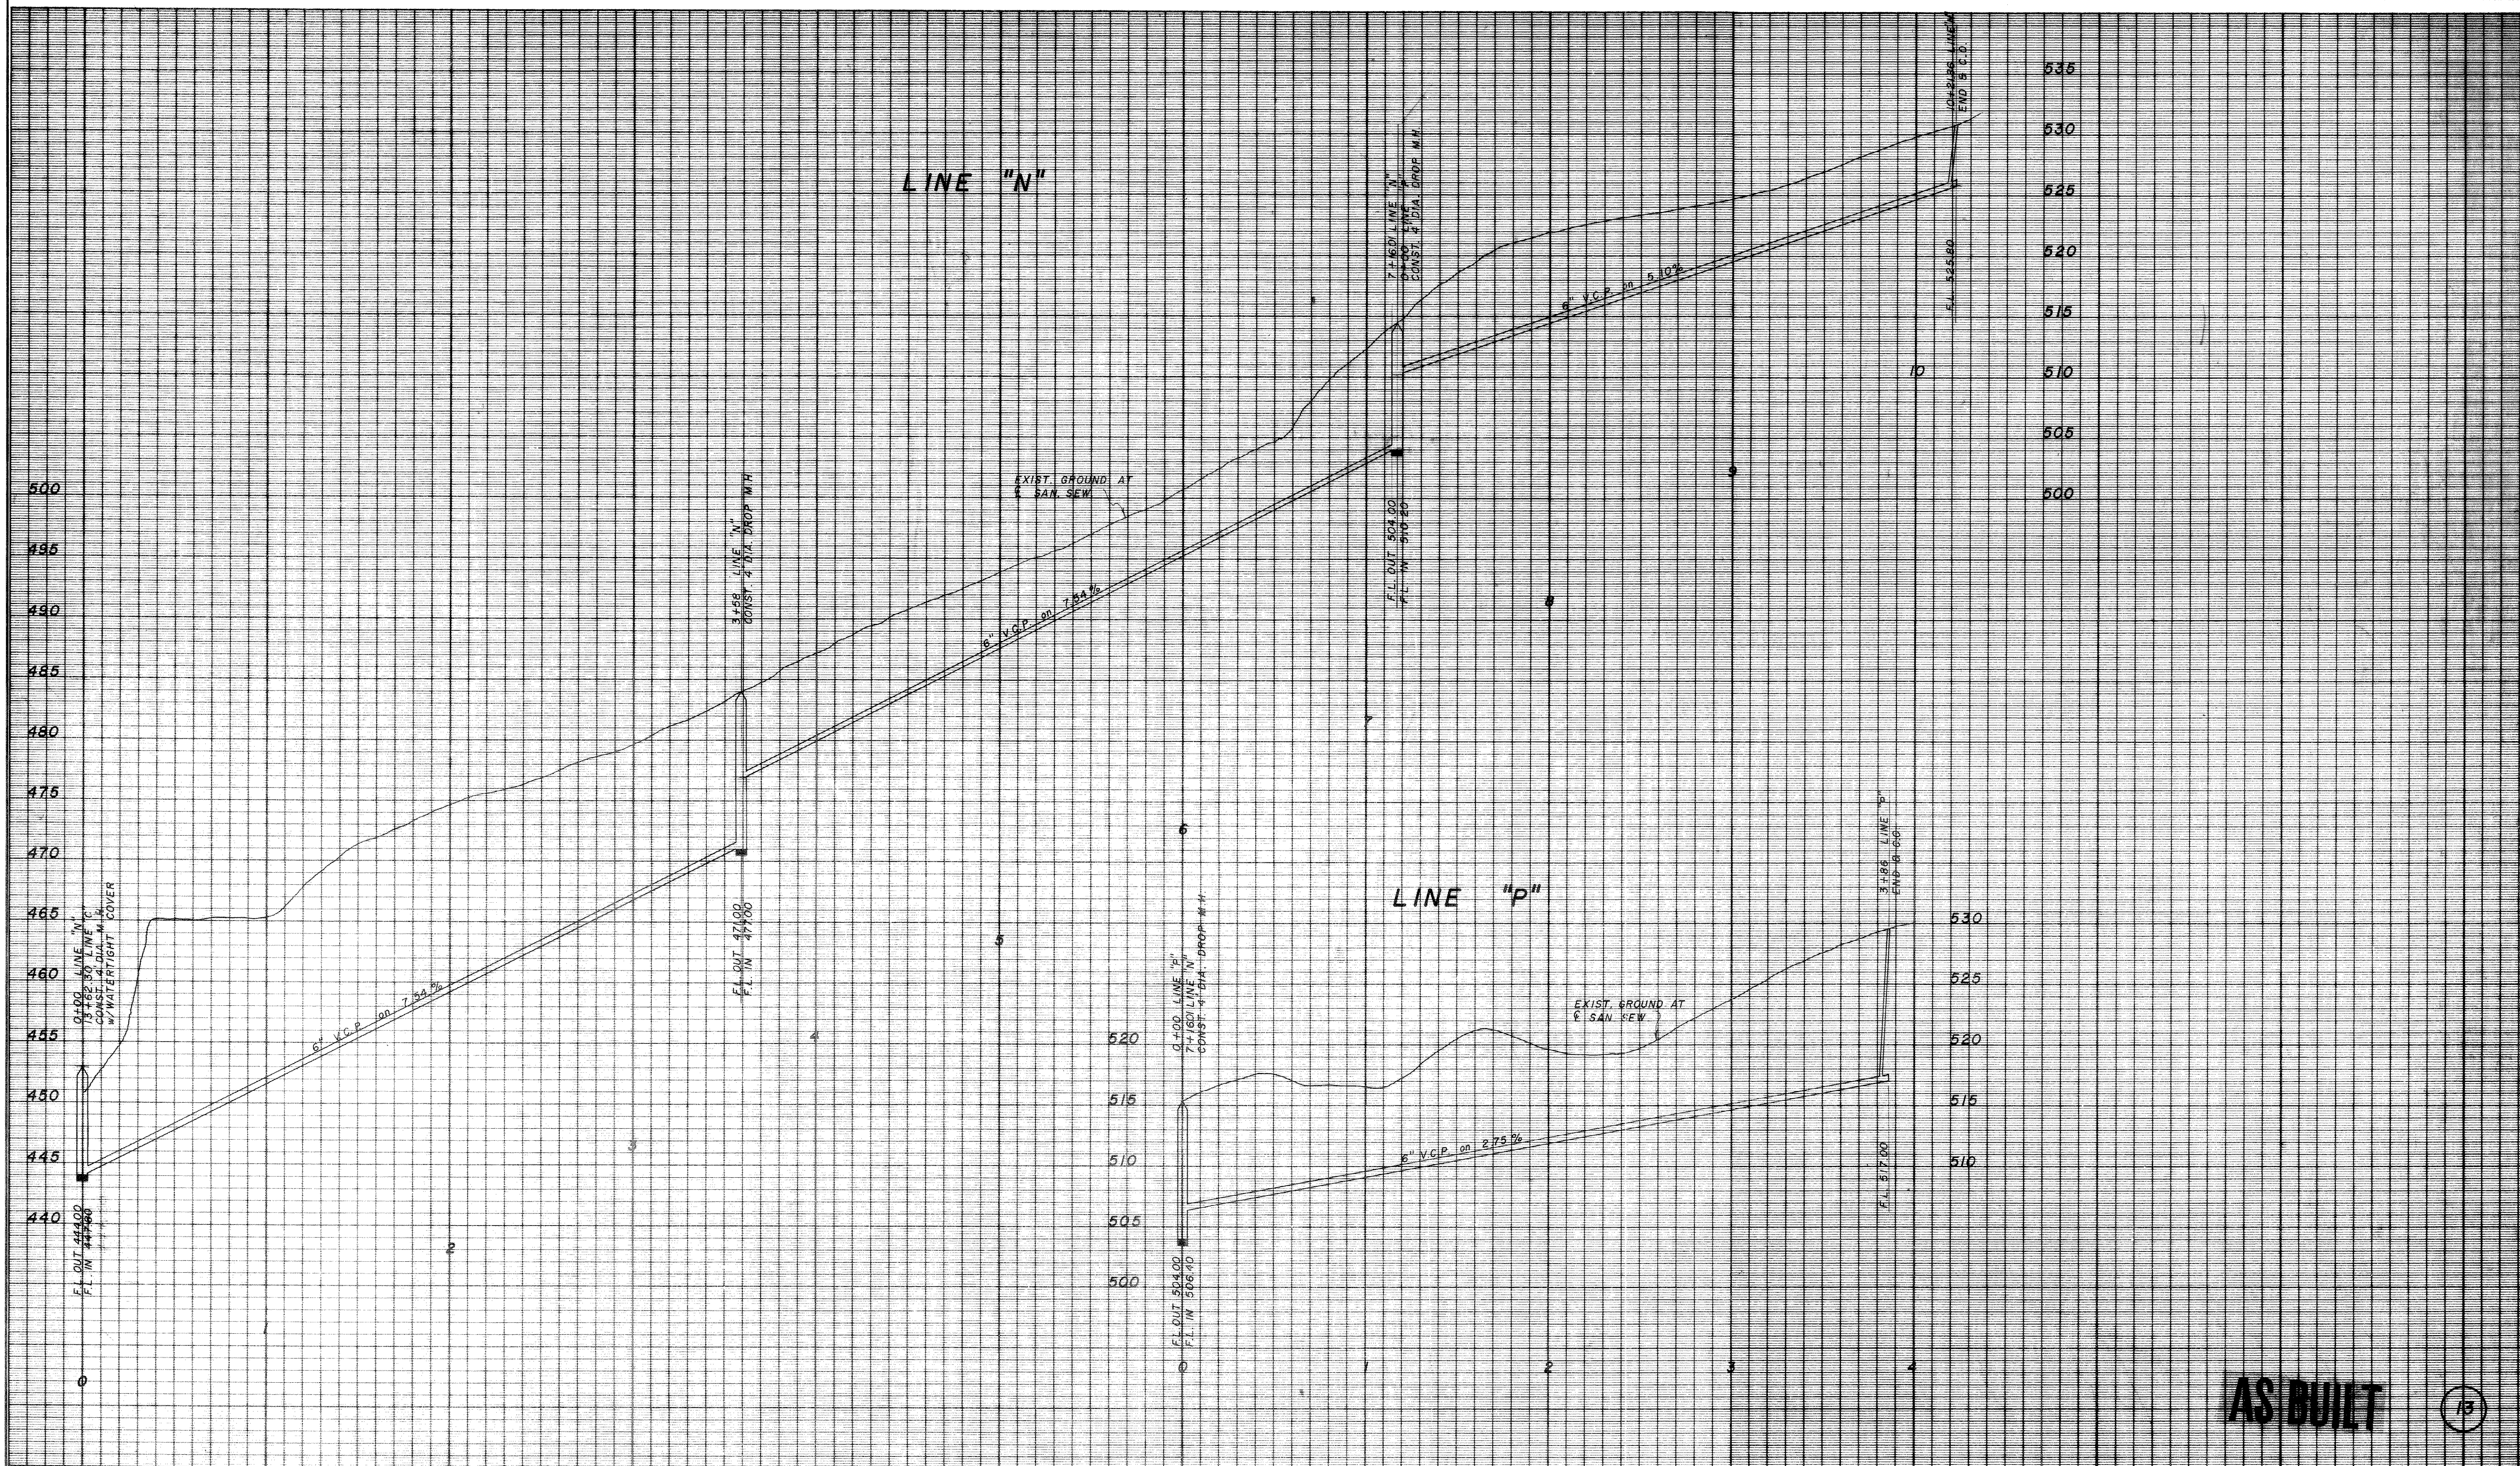

AS BUILT (13)

CHANDLERS LANDING						
PROPOSED SANITARY SEWER						
LINES "N" & "P"						
ROCKWALL, TEXAS						
DESIGN	DRAWN	DATE	SCALE	NOTES	FILE	NO.
H L E		6/15/73	1" = 40' H. 1" = 6' V.			72/22

PHASE 1, 2, & 3