



CURVE DATA TABLE								
NO.	ANGLE	RADIUS	NO.	ANGLE	RADIUS	NO.	ANGLE	RADIUS
1	89°23'	70.0'	5	28°07'	100.0'	9	111°04'	30.0'
2	36°56'	150.0'	6	94°25'	30.0'	10	76°11'	100.0'
3	69°35'	140.0'	7	62°29'	90.0'			
4	78°22'	40.0'	8	57°35'	60.0'			


NOTE:
USE 5° BEVEL JOINTS AS REQUIRED
FOR LINE "C".

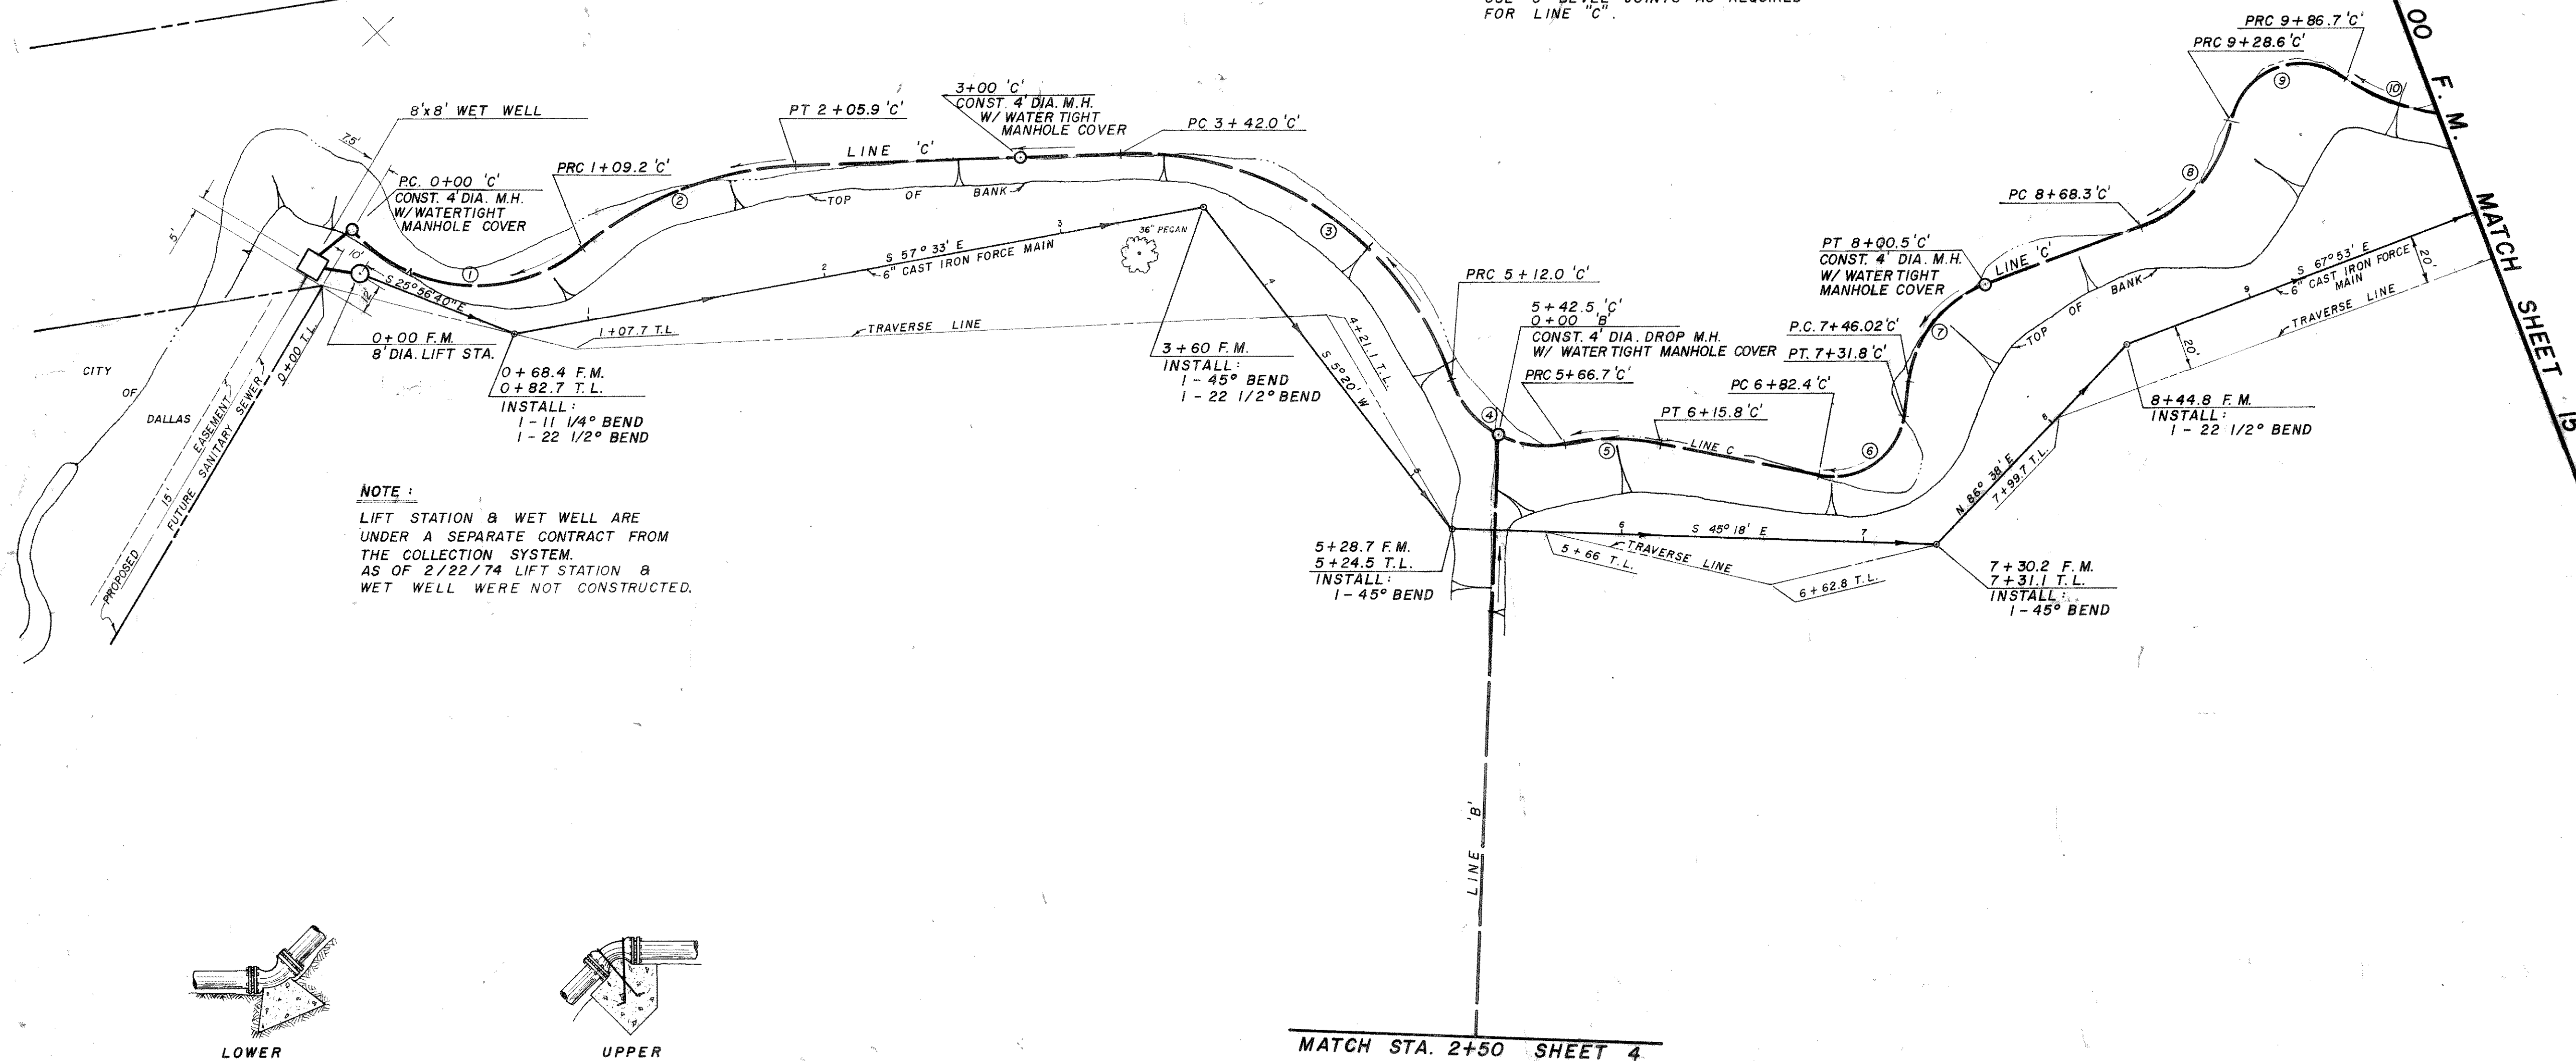

NOTE:
LIFT STATION & WET WELL ARE
UNDER A SEPARATE CONTRACT FROM
THE COLLECTION SYSTEM.
AS OF 2/22/74 LIFT STATION &
WET WELL WERE NOT CONSTRUCTED.

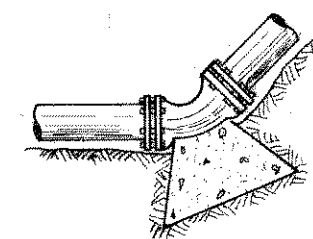

LOWER
CONCRETE

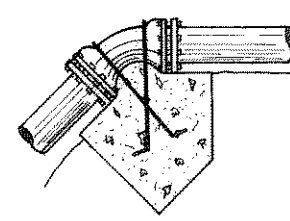

UPPER
BLOCKING

MATCH STA. 2+50 SHEET 4



CHANDLERS LANDING
PROPOSED SANITARY SEWER
FORCE MAIN & LINE "C"
ROCKWALL, TEXAS

DESIGN	DRAWN	DATE	SCALE	NOTES	FILE	NO.
HLE		6/6/73	1"=40'H. 1"=6'V.			

PHASE 12.33