


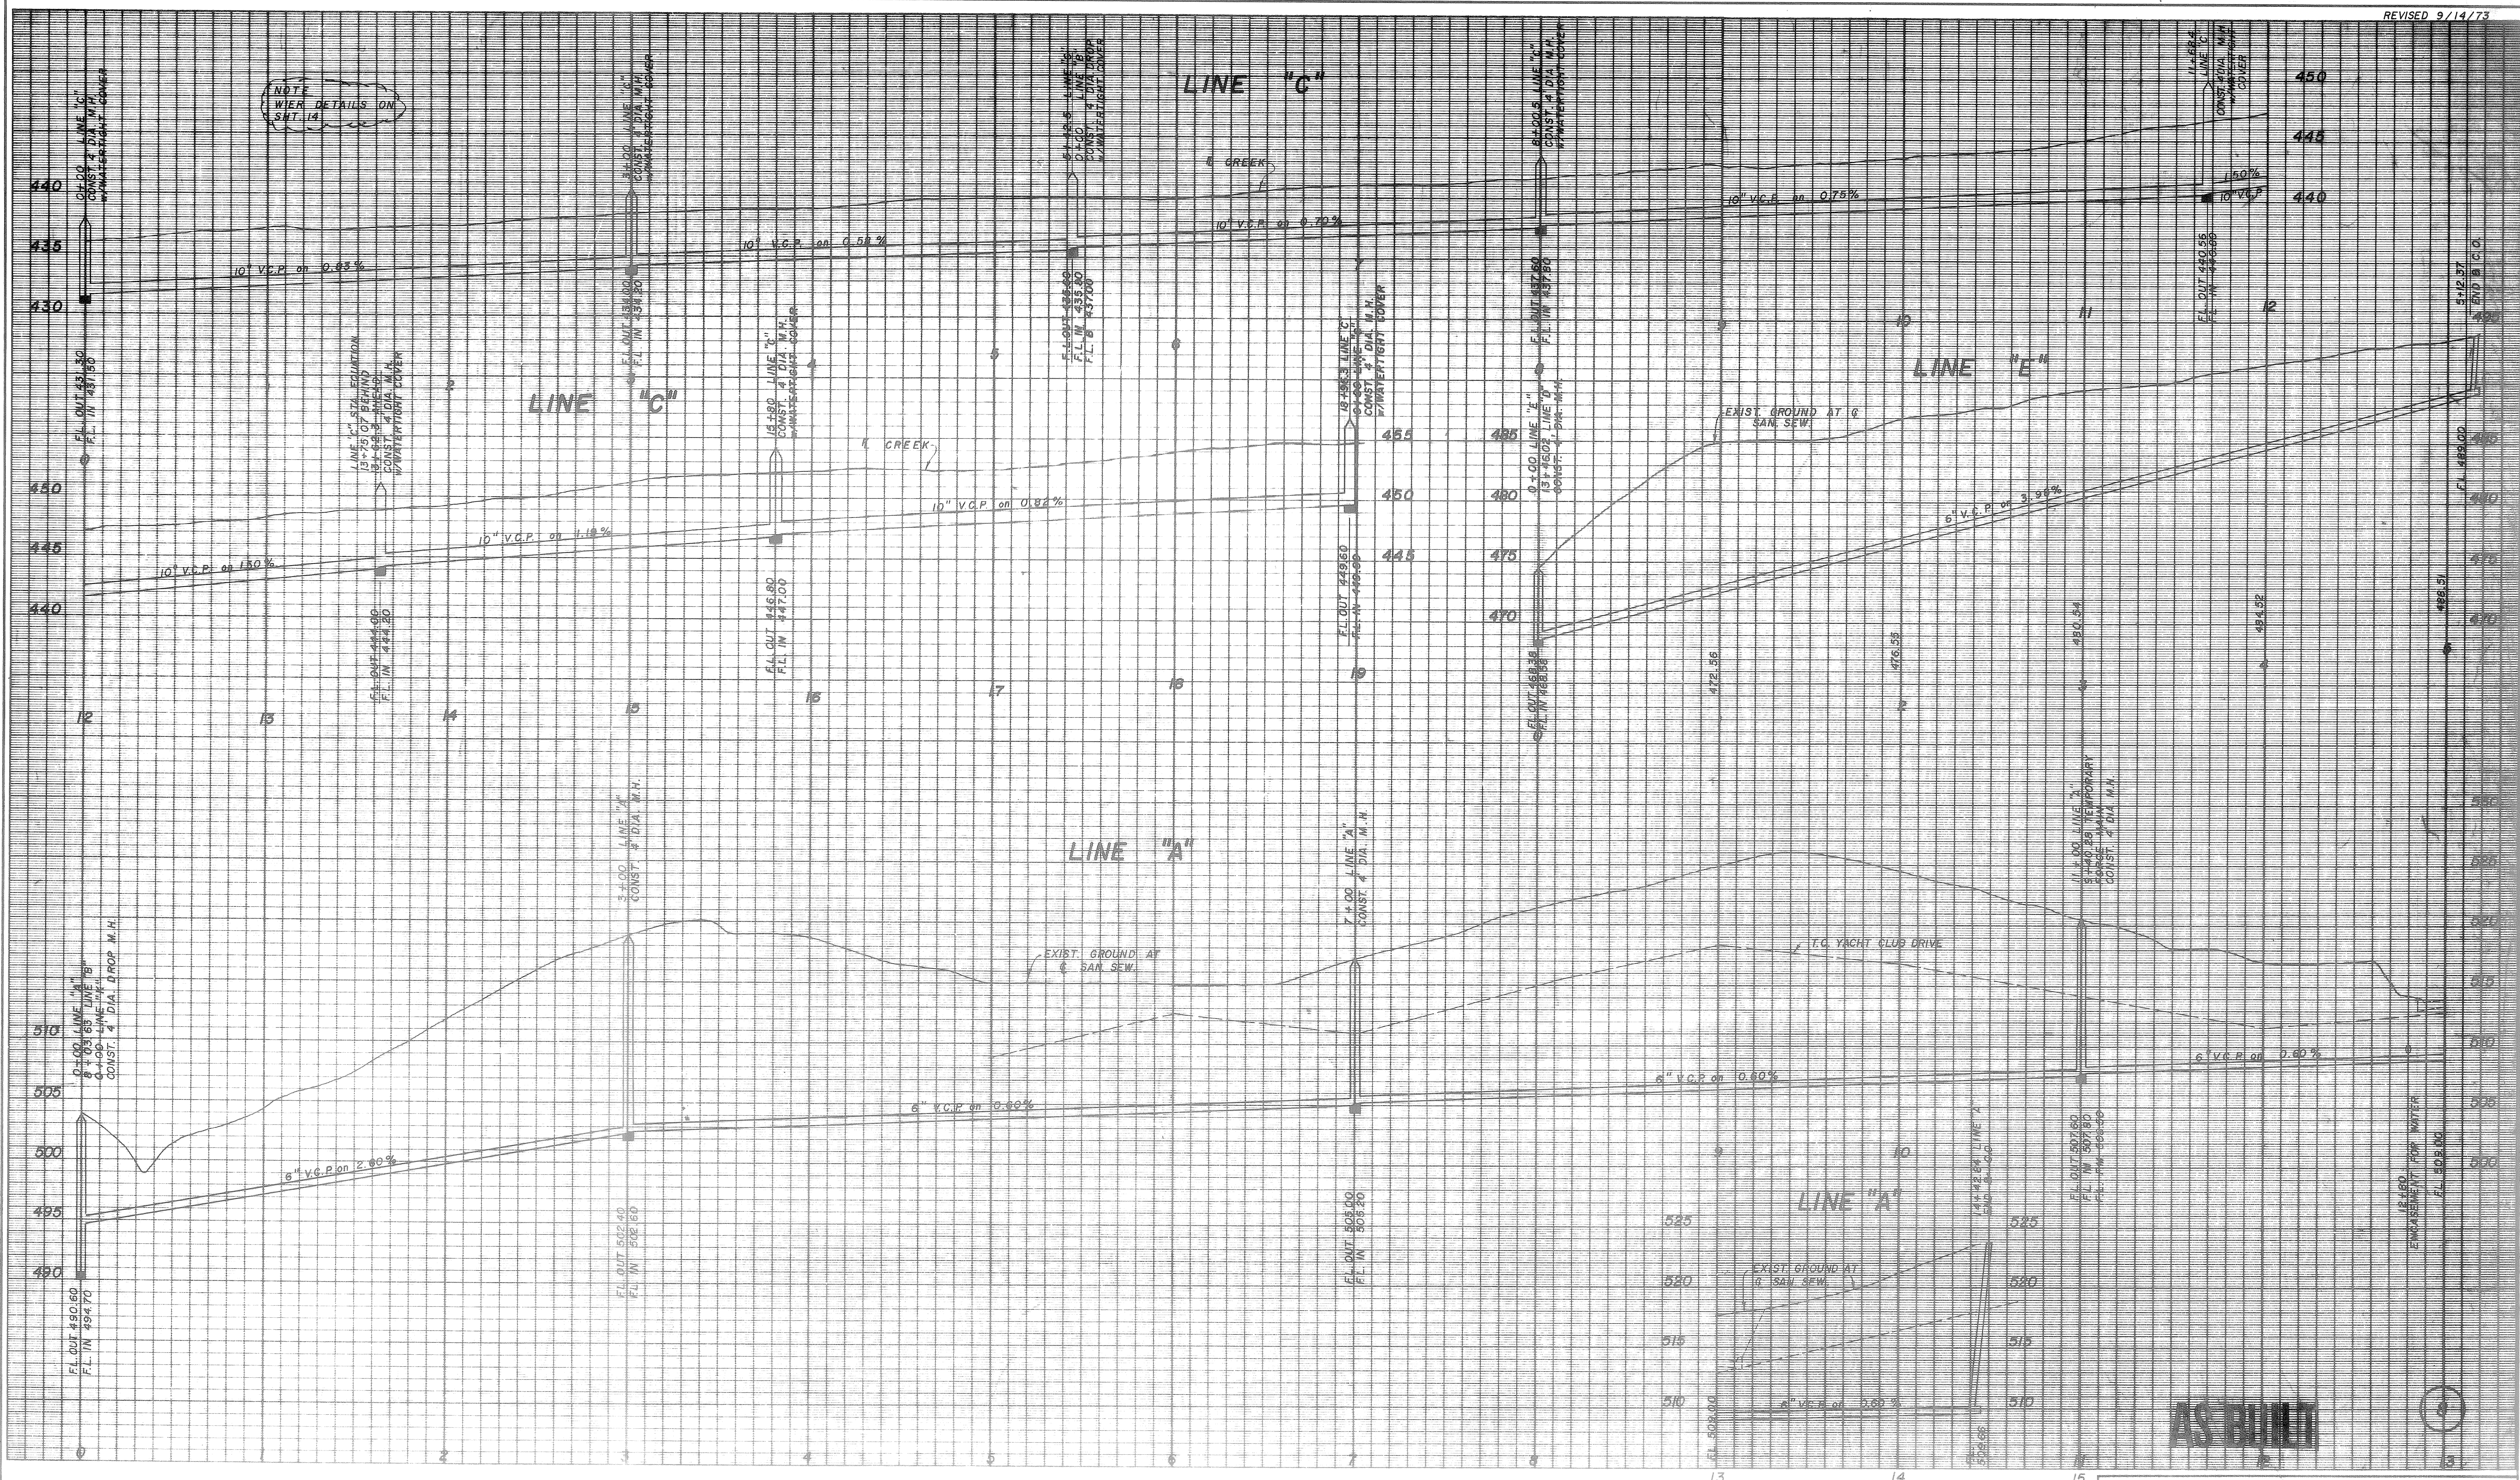

CHANDLERS LANDING
PROPOSED SANITARY SEWER
LINES "A", "C" & "E"
ROCKWALL, TEXAS

DESIGN	DRAWN	DATE	SCALE	NOTES	FILE	NO.
HLE		6/6/73	1" = 40' H. 1" = 6' V.			72122