
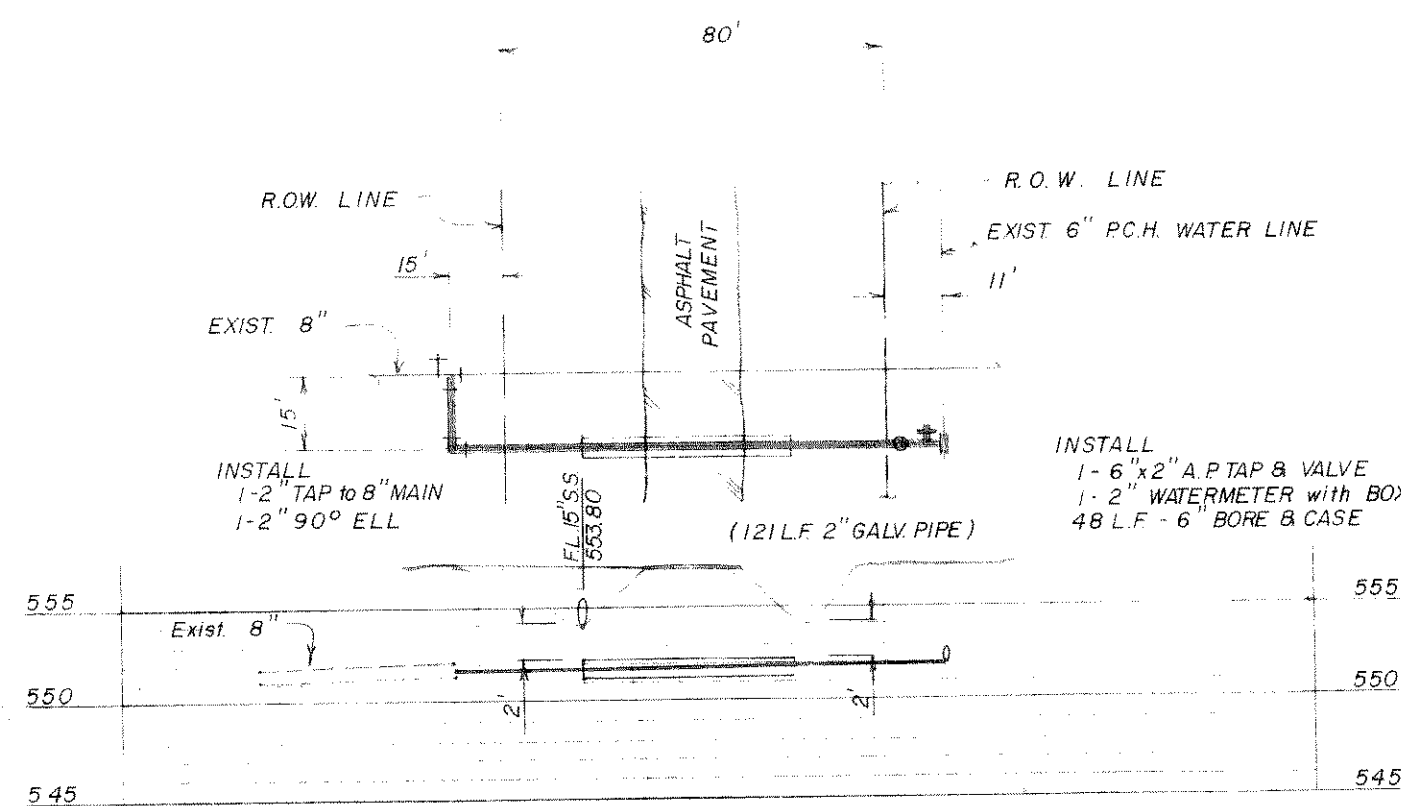


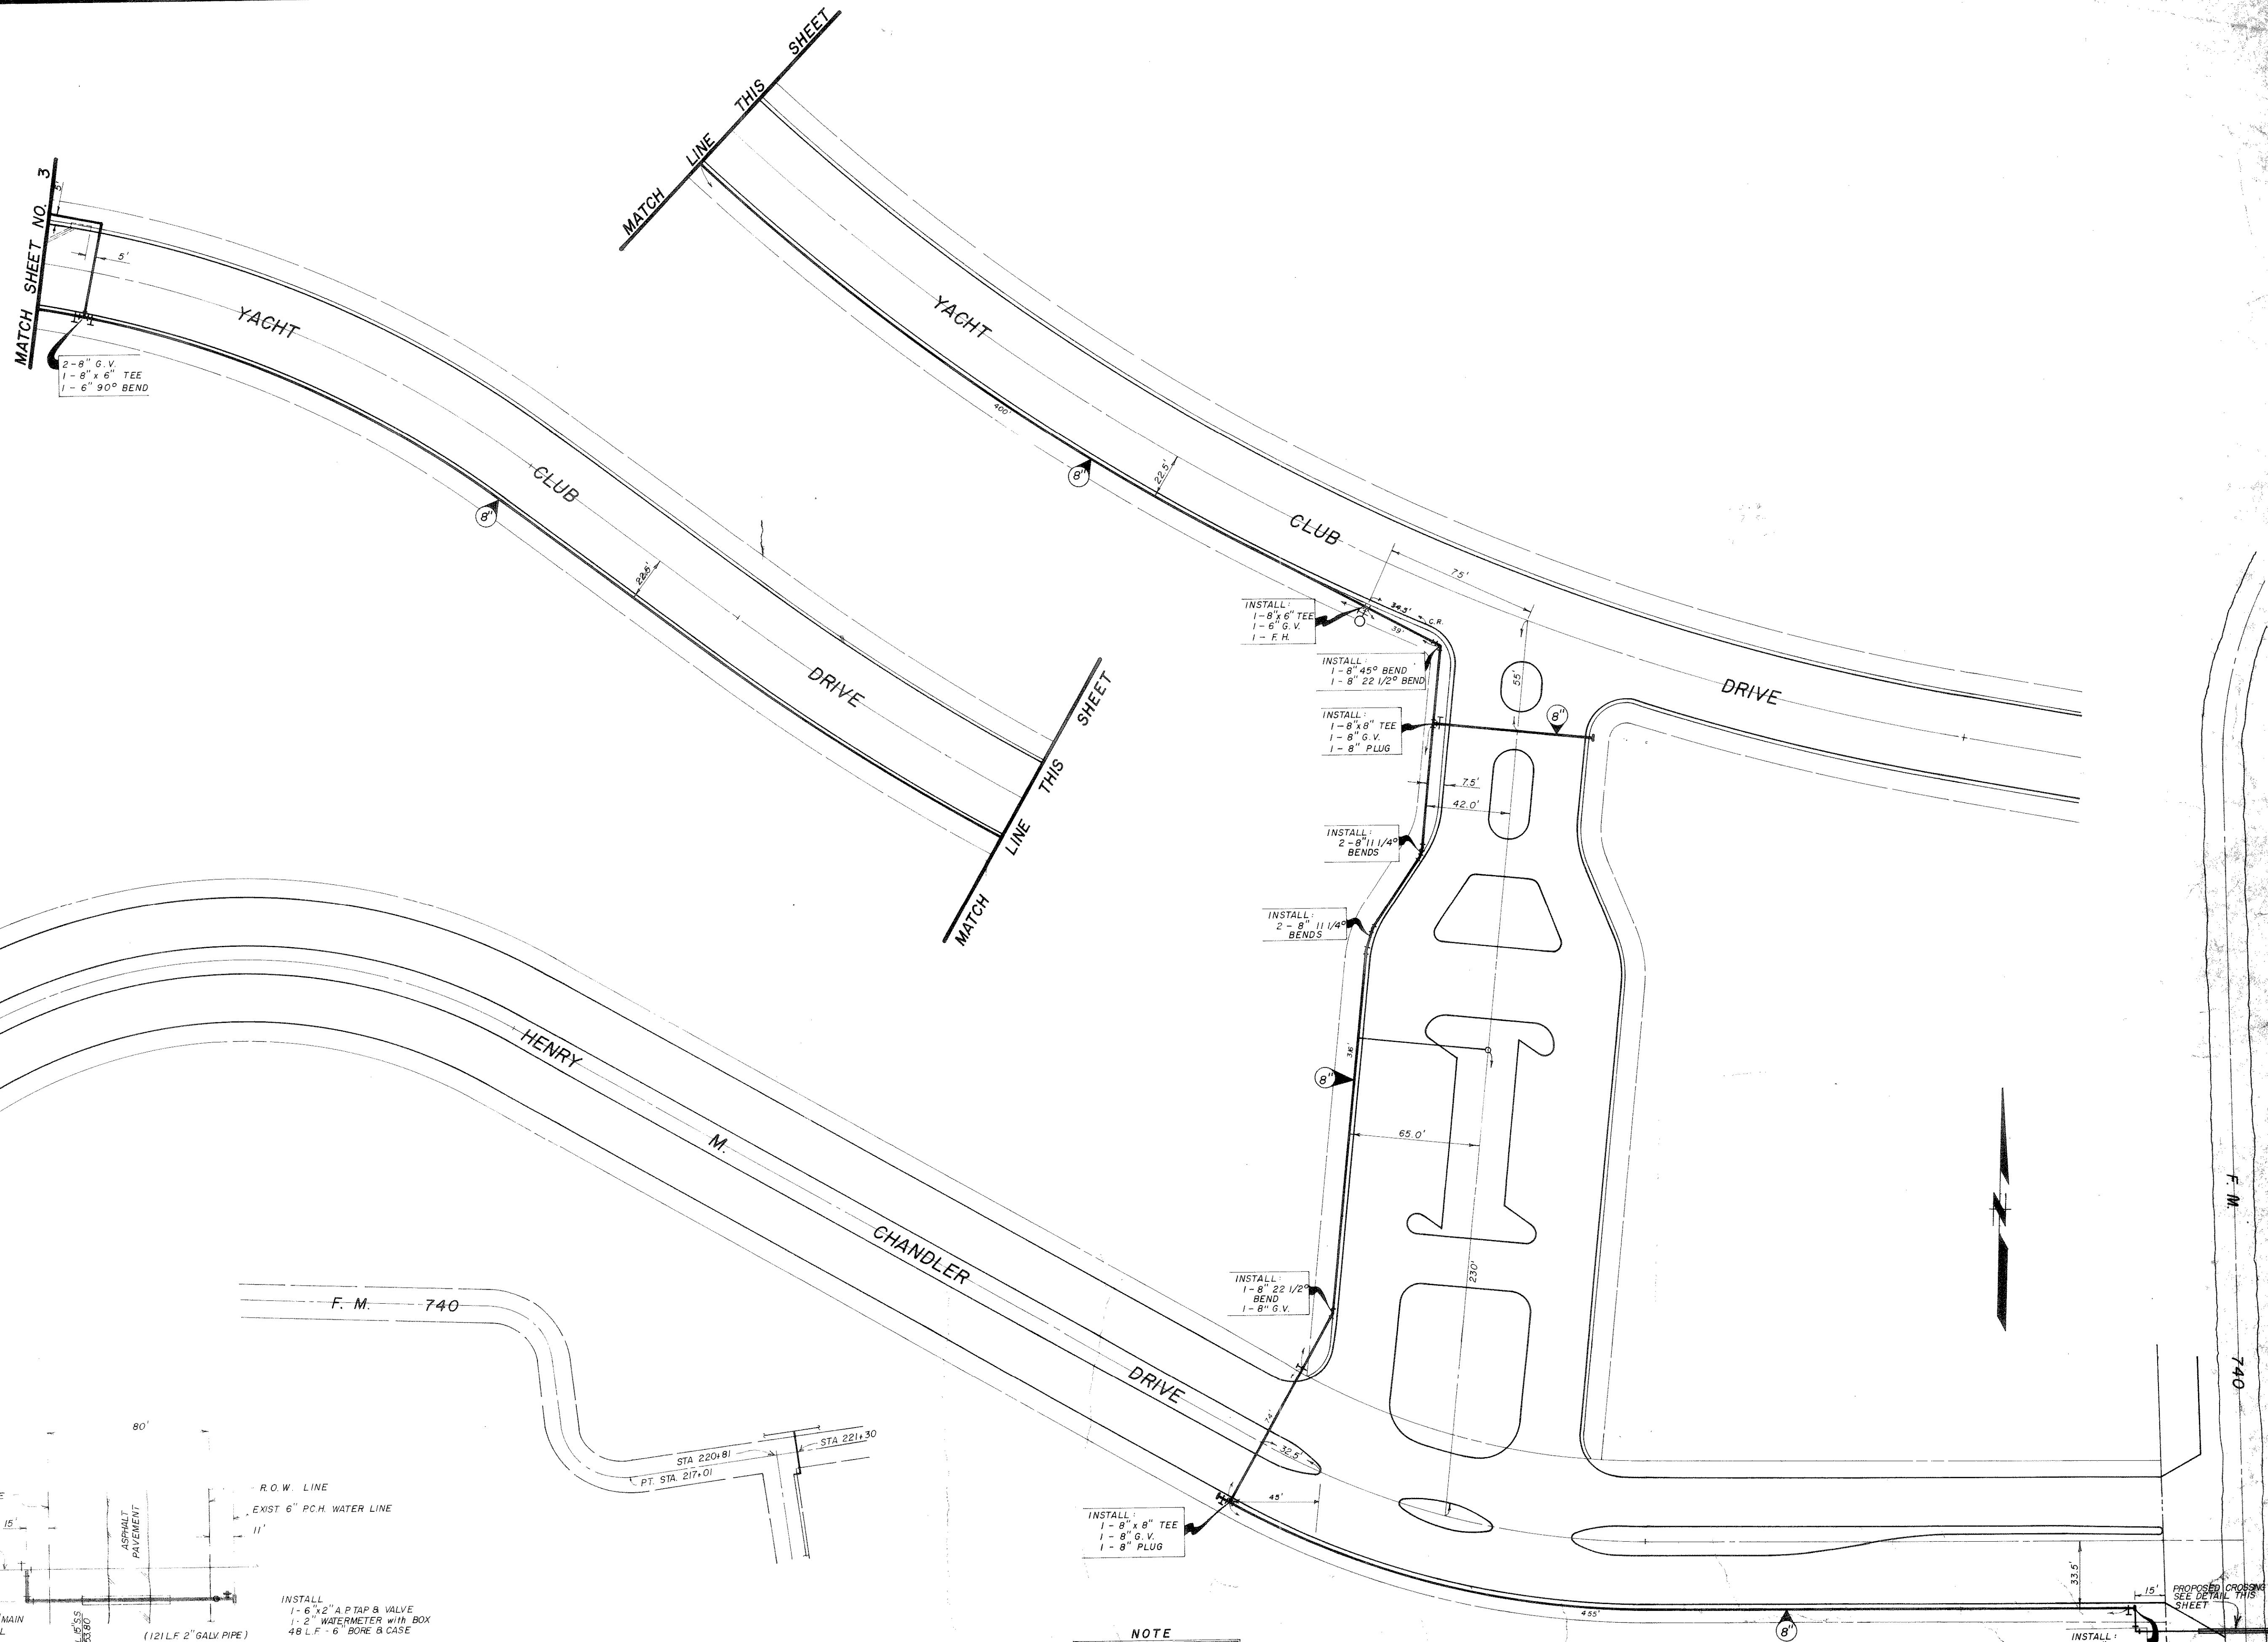

**NOTE**  
Water Line 2' behind back of curb is typical.

"AS BUILT"

| WATER   |        |          |       | CHANDLERS LANDING                                  |  |
|---------|--------|----------|-------|----------------------------------------------------|--|
|         |        |          |       | ROCKWALL COUNTY, TEXAS                             |  |
| DESIGN: | DRAWN: | SCALE:   | DATE: | DALLAS HAROLD EVANS - CONSULTING ENGINEER 222-8133 |  |
|         |        | 1" = 40' |       | JOB NO. 72122                                      |  |

PHASE 1, 2, 3

2