


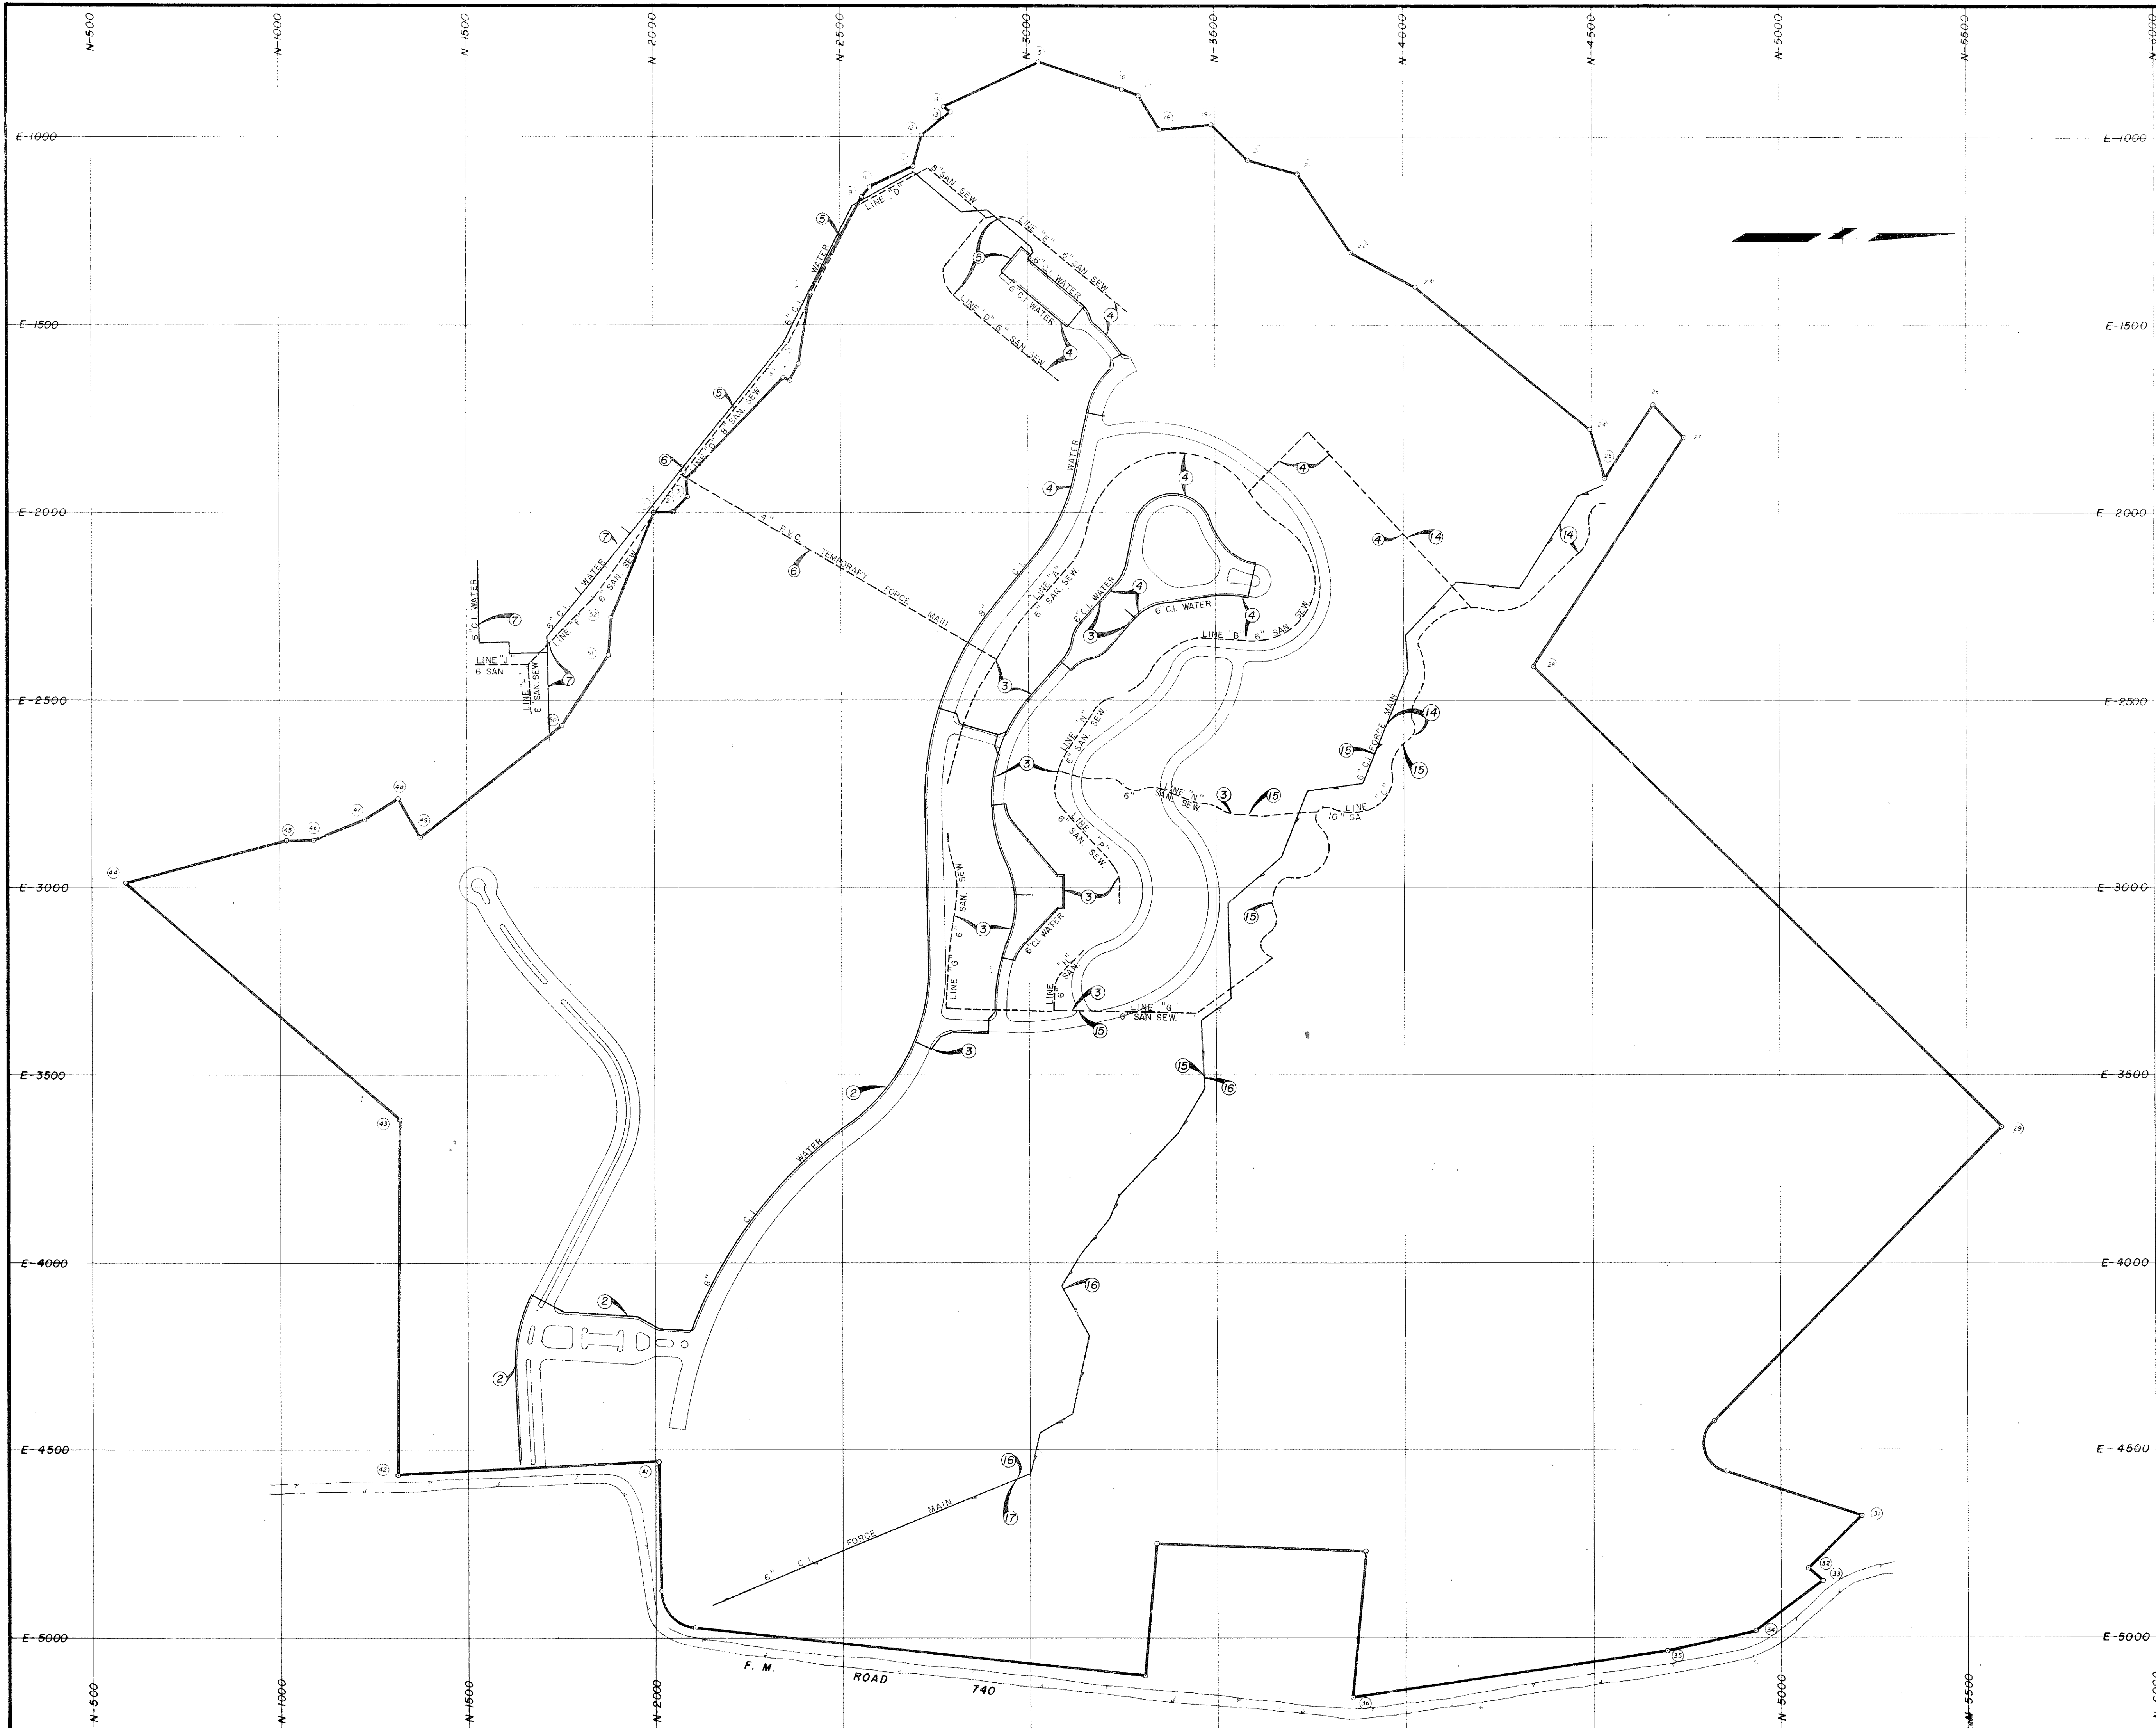

② Indicates SHEET NUMBER

AS BUILT

1

CHANDLERS LANDING ROCKWALL COUNTY, TEXAS		KEY	MAP
DESIGN	DRAWN	SCALE	DATE
HAROLD EVANS — CONSULTING ENGINEER		1" = 200'	

PH 1, 2, & 3