
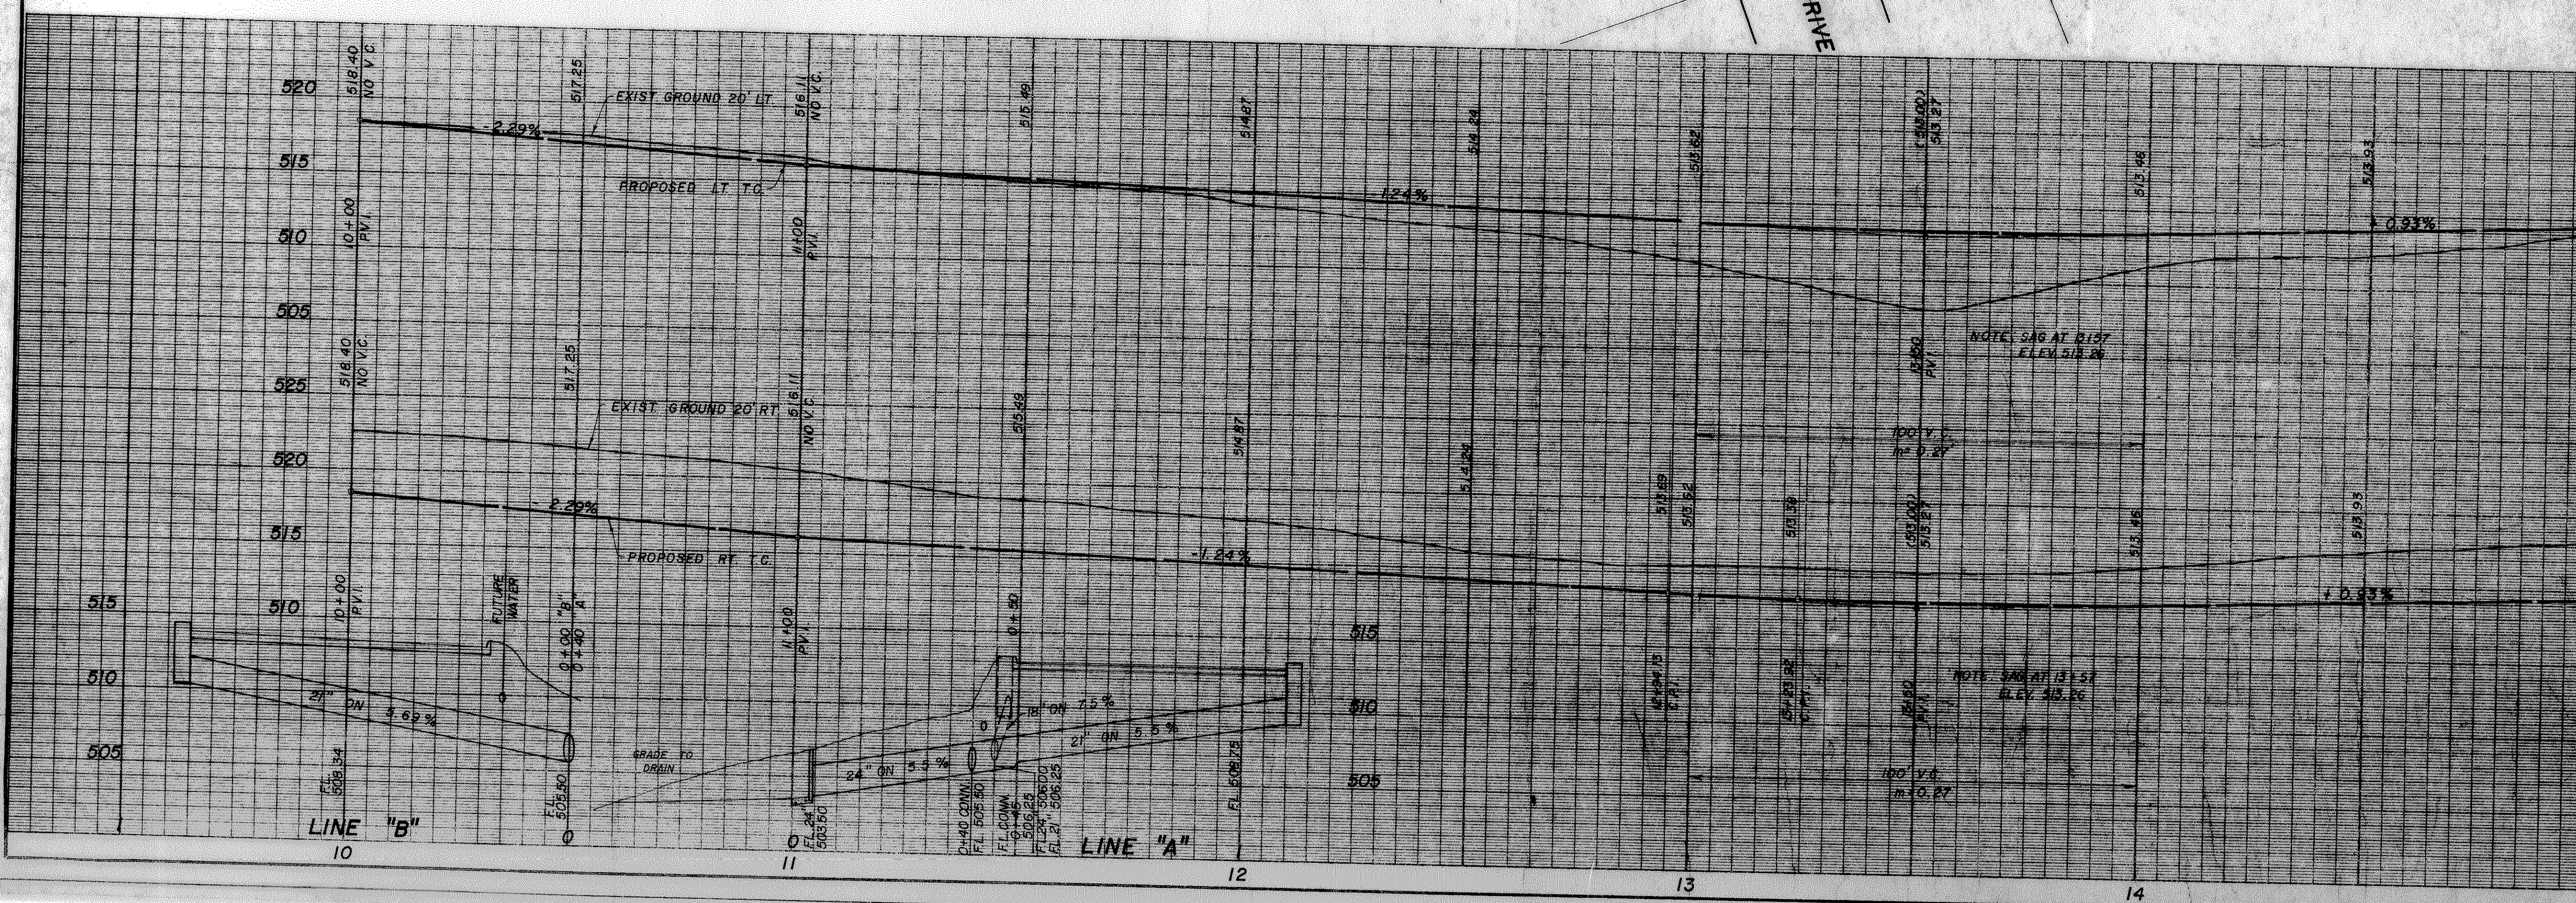


TABLE OF CURVE DATA

1	2	3
$\Delta = 12^\circ 41' 02''$	$\Delta = 14^\circ 21' 28''$	$\Delta = 12^\circ 34' 40''$
$R = 115.00'$	$R = 202.50'$	$R = 111.50'$
$T = 12.78'$	$T = 25.51'$	$T = 12.29'$
$L = 25.46'$	$L = 50.74'$	$L = 24.48'$
4	5	6
$\Delta = 5^\circ 41' 26''$	$\Delta = 22^\circ 35' 46''$	$\Delta = 6^\circ 00' 07''$
$R = 155.00'$	$R = 202.50'$	$R = 130.00'$
$T = 7.70'$	$T = 40.46'$	$T = 6.82'$
$L = 15.39'$	$L = 79.86'$	$L = 13.62'$

Q CURVE DATA
 $\Delta = 51^\circ 00' 00''$
 $R = 548.60'$
 $T = 261.67'$
 $L = 488.32'$

PIPE
 CURVE DATA
 $\Delta = 60^\circ 00' 00''$
 $R = 67.0'$
 $T = 38.68'$
 $L = 70.16'$

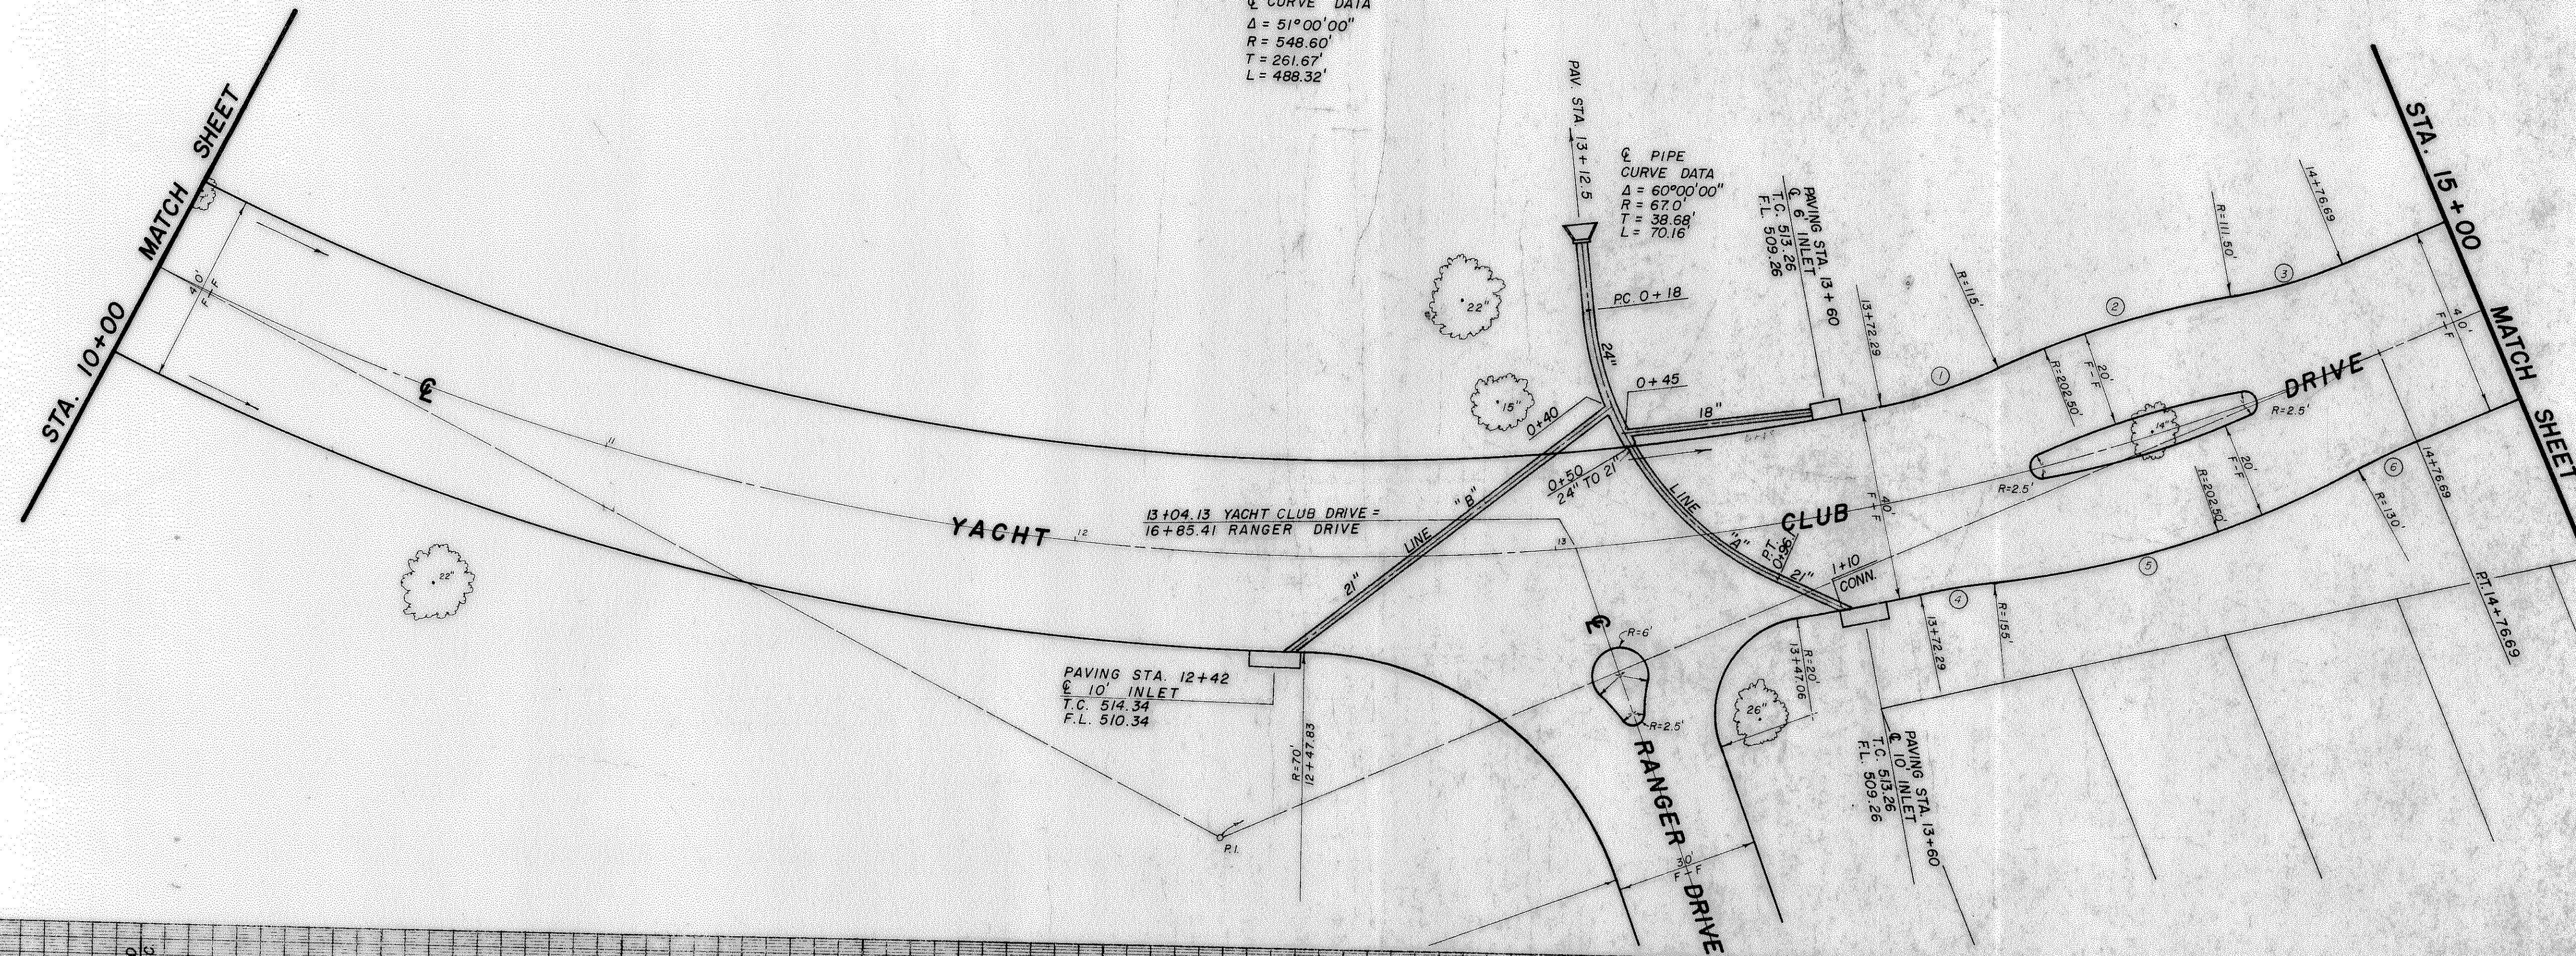

CHANDLERS LANDING
 PROPOSED PAVING
 YACHT CLUB DRIVE
 ROCKWALL, TEXAS

DESIGN	DRAWN	DATE	SCALE	NOTES	FILE
HLE	RP	2/73	1"=20' H. 1"=6' V.		