


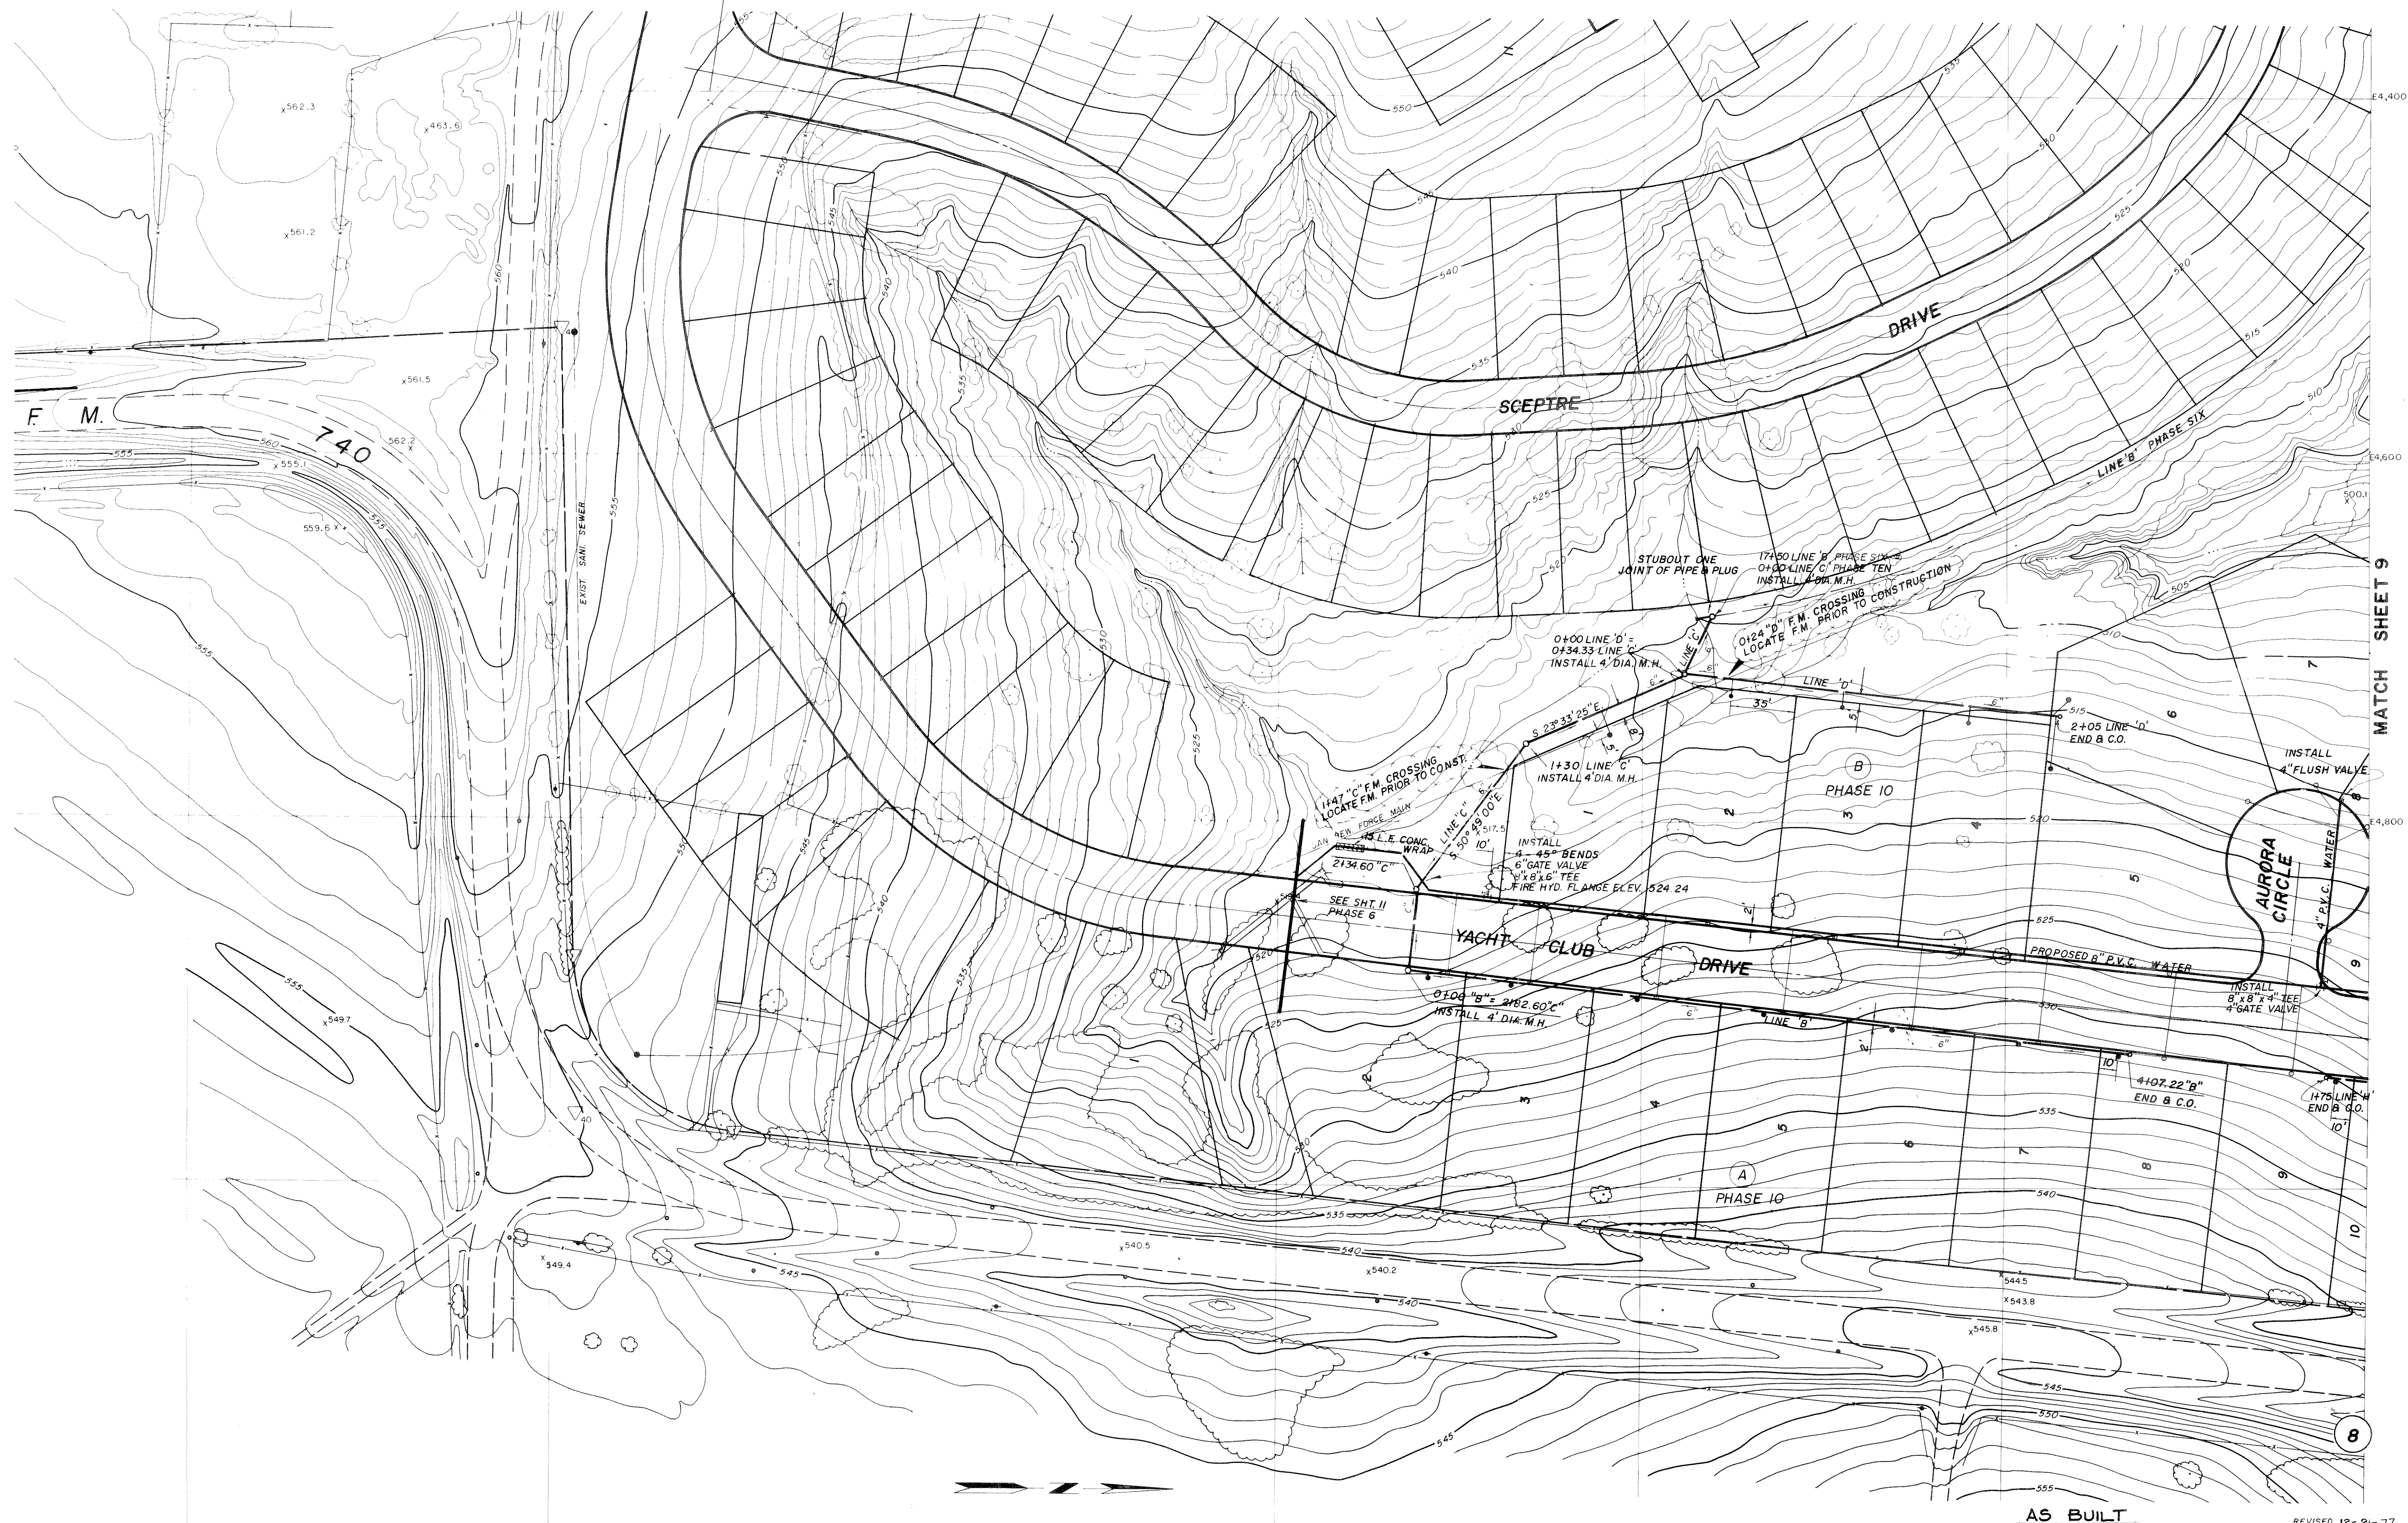

MATCH SHEET 9

8

AS BUILT

REVISÉD 12-24-7

CHANDLERS LANDING

PHASE TEN

DESIGN: J. T. S.

DRAWN: *H.R.M.*
By: *A*

	SCALE
--	-------

DATE:
 M

WATER & SANITARY SEWER

HAROLD EVANS CONSULTING ENGINEER